

# DESIGN & CONSTRUCTION GROUP THE GOVERNOR NELSON A. ROCKEFELLER EMPIRE STATE PLAZA ALBANY, NY 12242

### ADDENDUM NO. 1 TO PROJECT NO. 46240

# CONSTRUCTION, HVAC AND ELECTRICAL WORK PROVIDE FACILITY-WIDE CCTV / AUDIO MONITORING SYSTEM & CIVILIAN PERSONAL ALARM SYSTEM MARCY CORRECTIONAL FACILITY 9000 OLD RIVER ROAD MARCY, NY

April 16, 2025

**NOTE:** This Addendum forms a part of the Contract Documents. Insert it in the Project Manual. Acknowledge receipt of this Addendum in the space provided on the Bid Form.

### GENERAL DRAWINGS

- 1. Revised Drawing:
  - a. Drawing No. G-011, noted "ADDENDUM 1 4/15/2025", accompanies this Addendum and supersedes the same numbered originally issued drawing.

### **CONSTRUCTION DRAWINGS**

- 2. Revised Drawing:
  - a. Drawing No. A-510, noted "ADDENDUM 1 4/15/2025", accompanies this Addendum and supersedes the same numbered originally issued drawing.

### HVAC DRAWINGS


- 3. Revised Drawing:
  - a. Drawing No. M-502, noted "ADDENDUM 1 4/15/2025", accompanies this Addendum and supersedes the same numbered originally issued drawing.


### **ELECTRICAL DRAWINGS**

- 4. Revised Drawings:
  - Drawing Nos. ED-000-01, E-000-05, E-502, E-503 and E-509, noted "ADDENDUM 1 4/15/2025", accompany this Addendum and supersede the same numbered originally issued drawings.

### **END OF ADDENDUM**

Brady M. Sherlock, P.E. Director, Division of Design Design & Construction

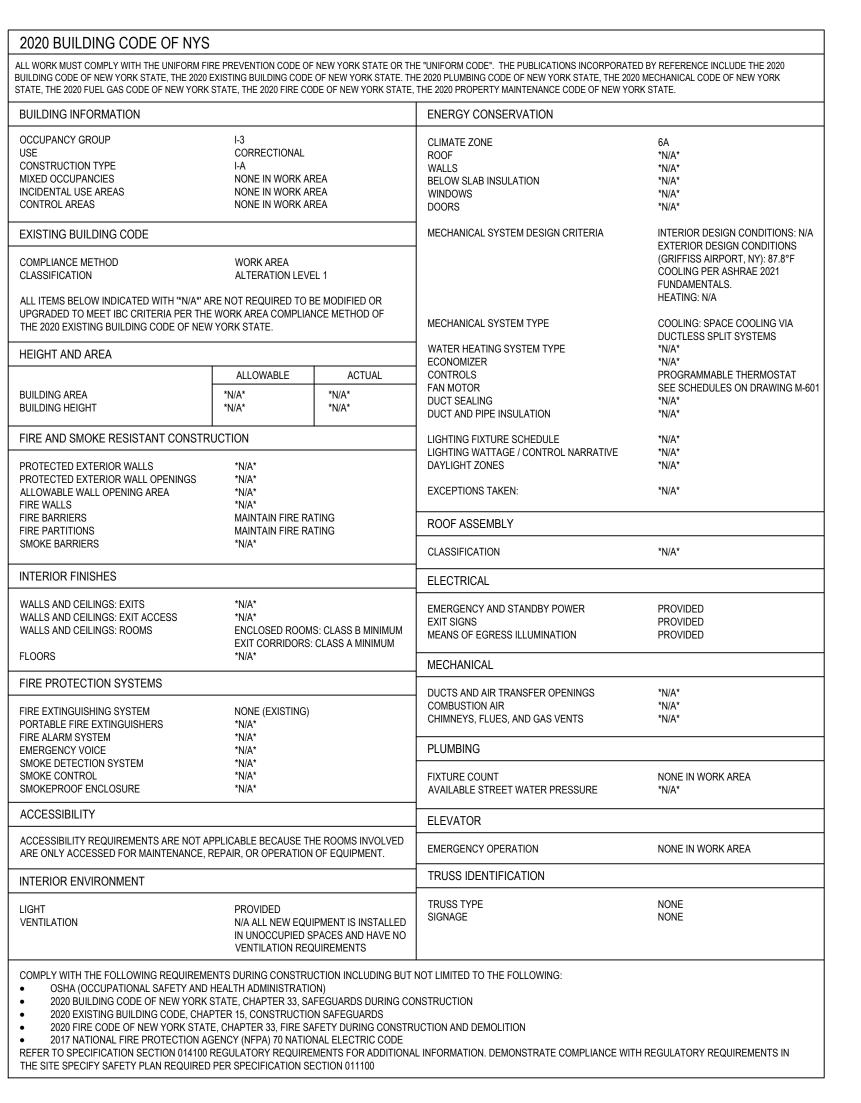

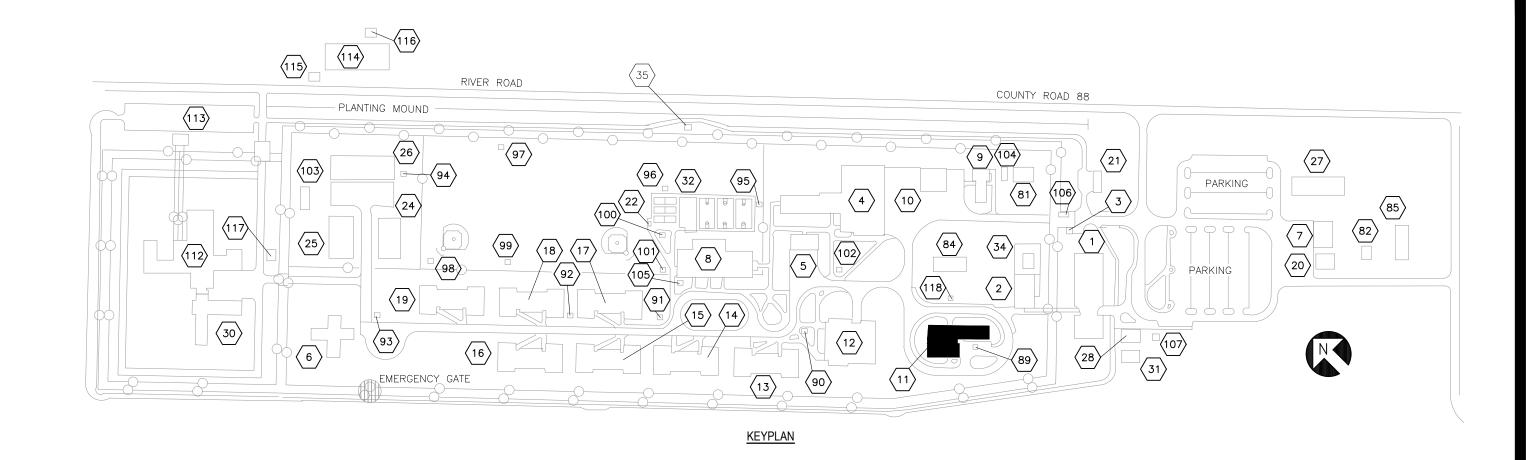

## **GENERAL NOTES:**

- 1. ALL INTERIOR WALLS UNLESS NOTED OTHERWISE ARE 6" CMU EXTENDING 4" BEYOND SUSPENDED CEILING.
- 2. ALL EXTERIOR WALLS ARE 8" CMU WITH HORIZONTAL REINFORCEMENT EVERY OTHER COURSE WITH 4" FACE BRICK VENEER WITH 2" INSULATION AND 1" AIR GAP BETWEEN BRICK AND CMU.

## WALL LEGEND

2-HOUR RATED 8" CMU WALL UP TO UNDERSIDE OF STEEL DECK - - 1-HOUR RATED 6" CMU WALL UP TO UNDERSIDE OF STEEL DECK

— — 6" CMU WALL GROUTED SOLID UP TO UNDERSIDE OF STEEL DECK ---- 8" CMU WALL GROUTED SOLID UP TO UNDERSIDE OF STEEL DECK



# **CEILING LEGEND**

- A = ACT
- G = 5/8" GYP TYPE X
- G1 = (2) LAYERS 5/8" GYP TYPE X 1 HOUR
- GF1 = (1) LAYER 5/8" GYP TYPE X AND (1) LAYER 5/8" GYP TYPE X
- C = CONCRETE
- MP = METAL PANEL REMOVABLE
- MT = METAL TILE
- NO = EXPOSED TO METAL PAN OF ROOF DECK OR FLOOR ABOVE
- A/G1 = ACT WITH "G1" ABOVE
- A/G = ACT WITH "G" ABOVE
- GP1 = (2) LAYERS GYP TYPE X 1 HOUR, 1/2" PLYWOOD BACKER
- G2 = (2) LAYERS 5/8" GYP TYPE X, WITH 1/2" GALVANIZED FRAMING BETWEEN - 2 HOUR

- GF = 5/8" GYP TYPE X LAMINATED TO 0.08" FRP
- LAMINATED TO 0.08" FRP 1 HOUR

- M = METAL SOLID

- A/G2 = ACT WITH "G2" ABOVE
- GP = 5/8" GYP TYPE X, 1/2" PLYWOOD BACKER

REGISTRATION EXPIRES:

10/31/2026

PROVIDE FACILITY-WIDE CCTV AUDIO MONITORING SYSTEM &

**DESIGN & CONSTRUCTION** 

SAGE ENGINEERING

ASSOCIATES, LLP

PROFESSIONAL'S KNOWLEDGE, BELIEF AND PROFESSIONAL

JUDGEMENT, THESE PLANS AND/OR SPECIFICATIONS ARE

PROFESSIONAL'S KNOWLEDGE, BELIEF AND PROFESSIONAL

JUDGEMENT, THESE PLANS AND/OR SPECIFICATIONS ARE

UNLESS DONE UNDER THE DIRECTION OF A COMPARABLE

ENGINEER FOR AN ENGINEER OR LANDSCAPE ARCHITECT

NEW YORK STATE EDUCATION LAW AND/OR REGULATIONS

FOR A LANDSCAPE ARCHITECT, IS A VIOLATION OF THE

TO THE BEST OF THE REGISTERED DESIGN

TO THE BEST OF THE REGISTERED DESIGN

IN COMPLIANCE WITH THE 2020 ENERGY CODE.

IN COMPLIANCE WITH THE 2020 UNIFORM CODE.

THE ALTERATION OF THIS MATERIAL IN ANY WAY,

AND IS A CLASS 'A' MISDEMEANOR.

PROFESSIONAL, I.E. ARCHITECT FOR AN ARCHITECT,

CERTIFICATE OF AUTHORIZATION #: 0018644

CIVILIAN PERSONAL ALARM SYSTEM MARCY CORRECTIONAL FACILITY 9000 OLD RIVER ROAD MARCY, NY

DEPARTMENT OF CORRECTIONS AND COMMUNITY SUPERVISION


04/15/2025 | ADDDENDUM 1 03/20/2025 | BID DOCUMENT 46240-C,H,E DESIGNED BY:

**BUILDING 11 CODE** 


COMPLIANCE PLAN

G - 011

of **227** 

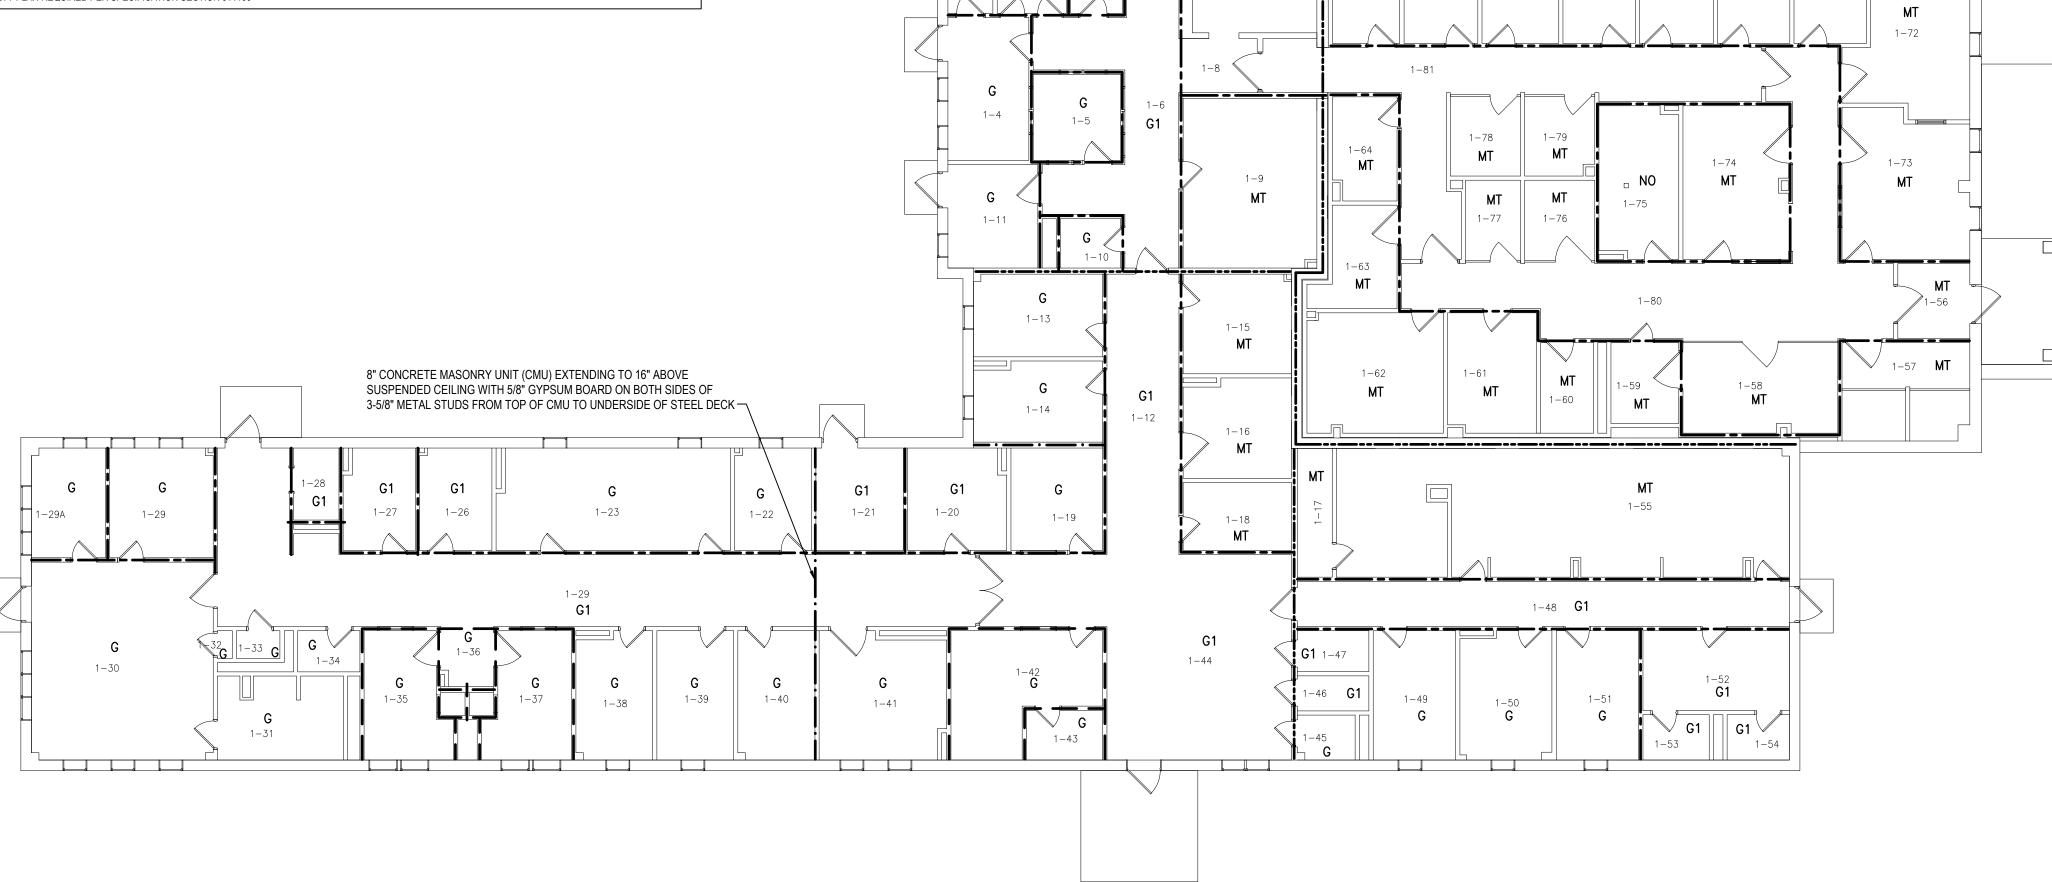



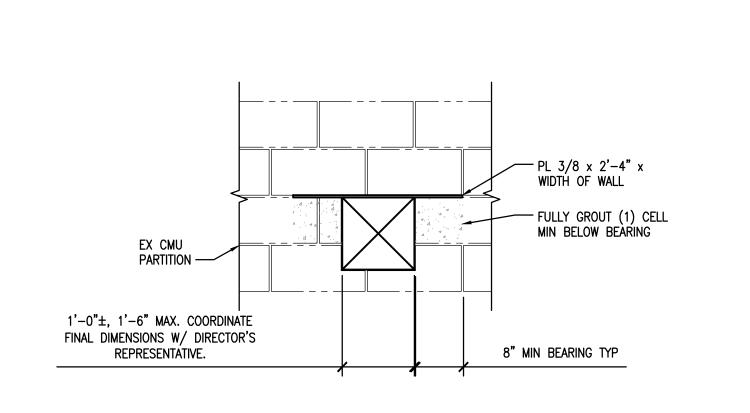



BUILDING 84 LINTEL DETAIL

BUILDING 113 LINTEL DETAIL


A-510 SCALE: NOT TO SCALE


A-510 SCALE: NOT TO SCALE

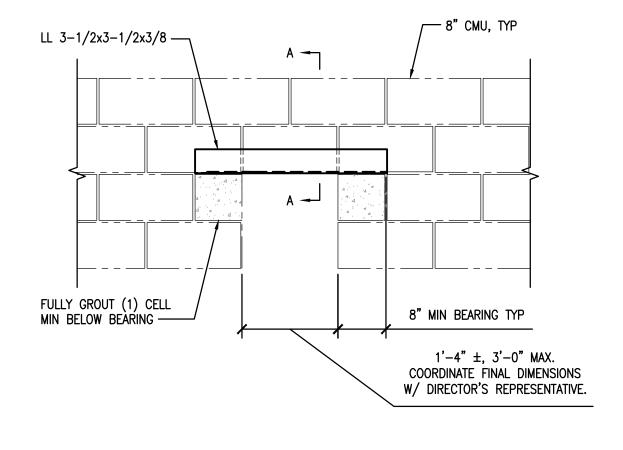

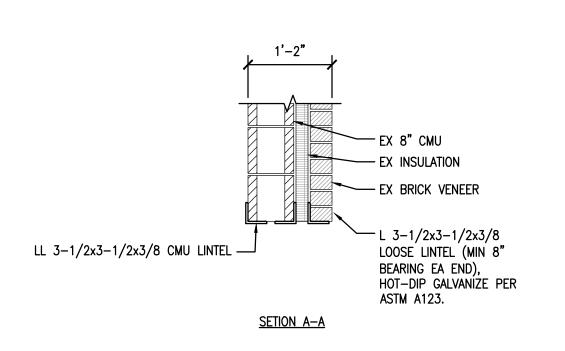


2 BUILDING 5, 6, AND 12 LINTEL DETAIL
SCALE: NOT TO SCALE

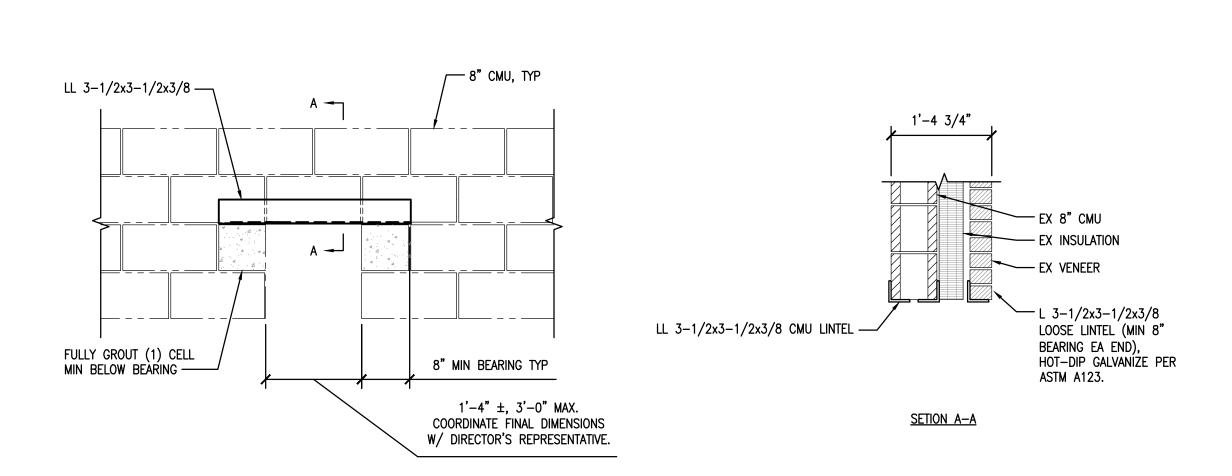

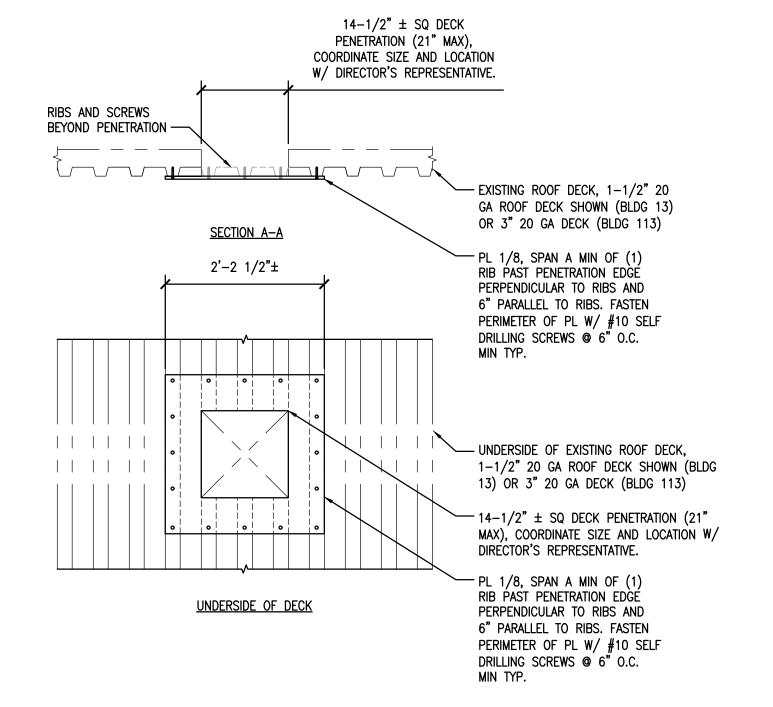

4 BUILDING 4, 8, 13-19, 24, 25, 112, AND 113 ROOF REINFORCEMENT DETAIL

SCALE: NOT TO SCALE

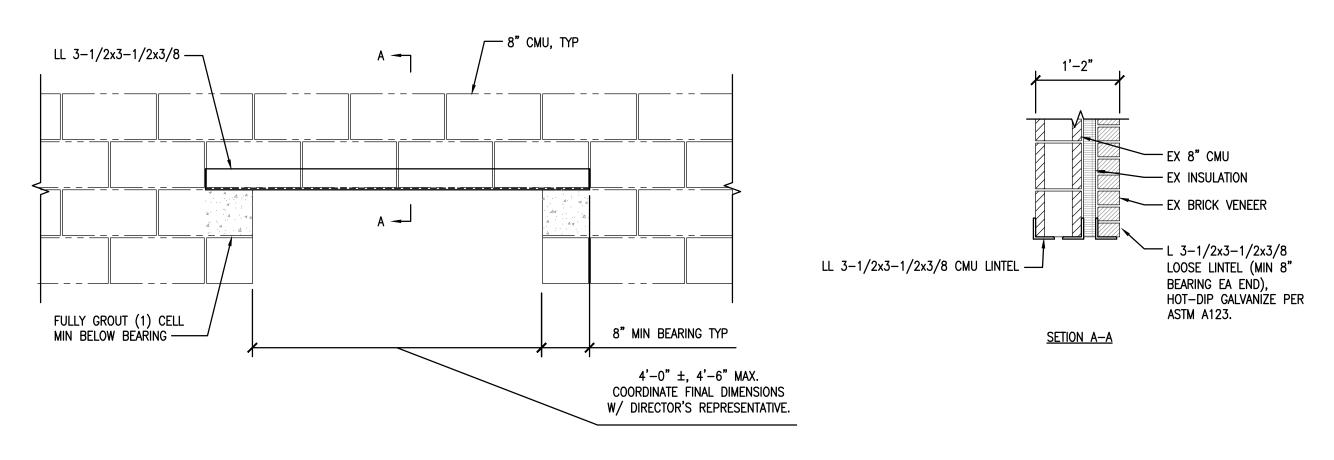

5 BUILDING 2 LINTEL DETAIL

A-510 SCALE: NOT TO SCALE


NEW YORK STATE OF OPPORTUNITY,

NEW YORK Office of General Services

**DESIGN & CONSTRUCTION** 

CONSULTANT

CERTIFICATE OF AUTHORIZATION #: 0018644

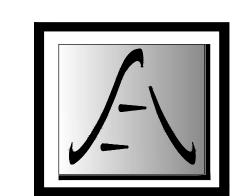


SAGE ENGINEERING ASSOCIATES, LLP

TO THE BEST OF THE REGISTERED DESIGN PROFESSIONAL'S KNOWLEDGE, BELIEF AND PROFESSIONAL JUDGEMENT, THESE PLANS AND/OR SPECIFICATIONS ARE IN COMPLIANCE WITH THE 2020 ENERGY CODE.

TO THE BEST OF THE REGISTERED DESIGN PROFESSIONAL'S KNOWLEDGE, BELIEF AND PROFESSIONAL JUDGEMENT, THESE PLANS AND/OR SPECIFICATIONS ARE IN COMPLIANCE WITH THE 2020 UNIFORM CODE.

### WARNING

THE ALTERATION OF THIS MATERIAL IN ANY WAY, UNLESS DONE UNDER THE DIRECTION OF A COMPARABLE PROFESSIONAL, I.E. ARCHITECT FOR AN ARCHITECT, ENGINEER FOR AN ENGINEER OR LANDSCAPE ARCHITECT FOR A LANDSCAPE ARCHITECT, IS A VIOLATION OF THE NEW YORK STATE EDUCATION LAW AND/OR REGULATIONS AND IS A CLASS 'A' MISDEMEANOR.

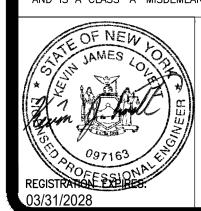

# CONSTRUCTION

PROVIDE FACILITY—WIDE CCTV /
AUDIO MONITORING SYSTEM &
CIVILIAN PERSONAL ALARM SYSTEM

MARCY CORRECTIONAL FACILITY
9000 OLD RIVER ROAD
MARCY, NY

DEPARTMENT OF CORRECTIONS
AND COMMUNITY SUPERVISION


1	04/15/2025	ADDDENDUM 1
	03/20/2025	BID DOCUMENT
MARK	DATE	DESCRIPTION
PROJECT NUMBER:	46240-C	
DESIGNED BY:	CFZ	
DRAWN BY:	CFZ	
FIELD CHECK:	-	
APPROVED:	DPL	
SHEET TITLE:		


LINTEL AND ROOF
REINFORCEMENT DETAILS

DRAWING NUMBER:


A-510

SHEET 43 OF 227

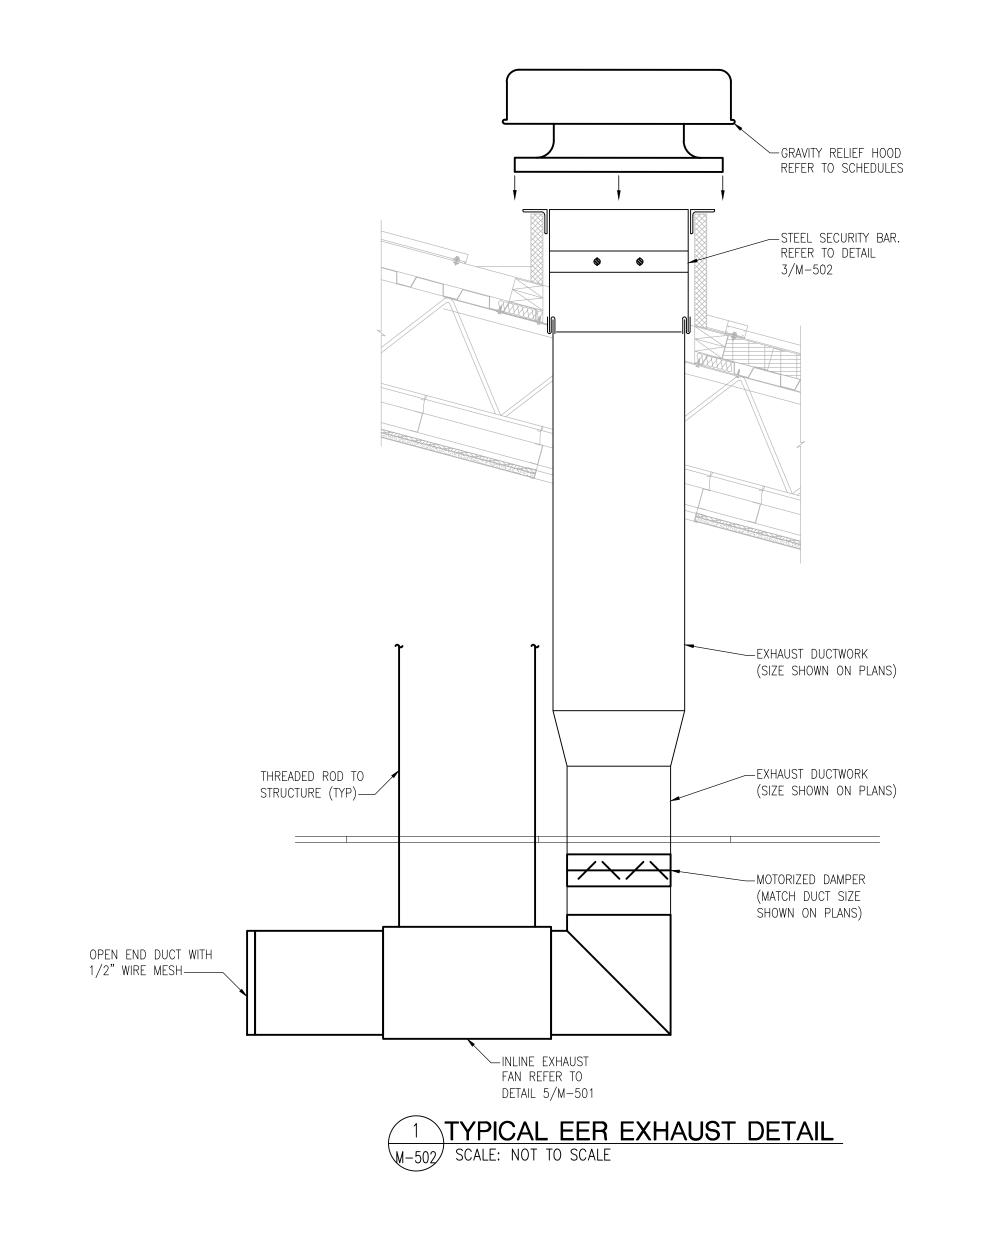

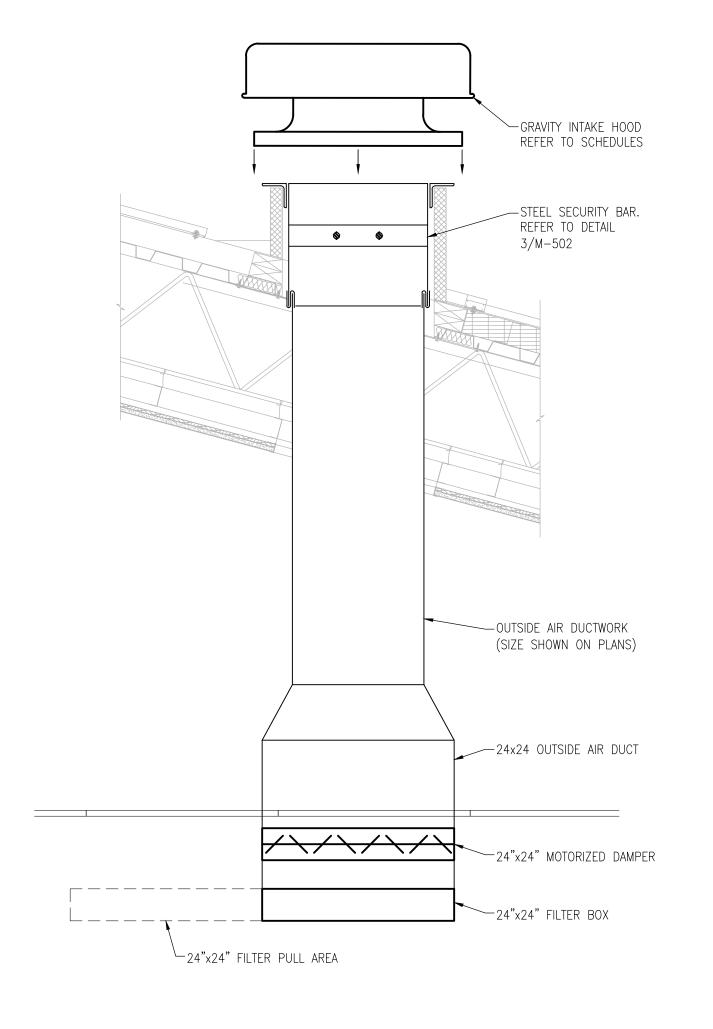


2 TYPICAL EER AIR INTAKE DETAIL
SCALE: NOT TO SCALE

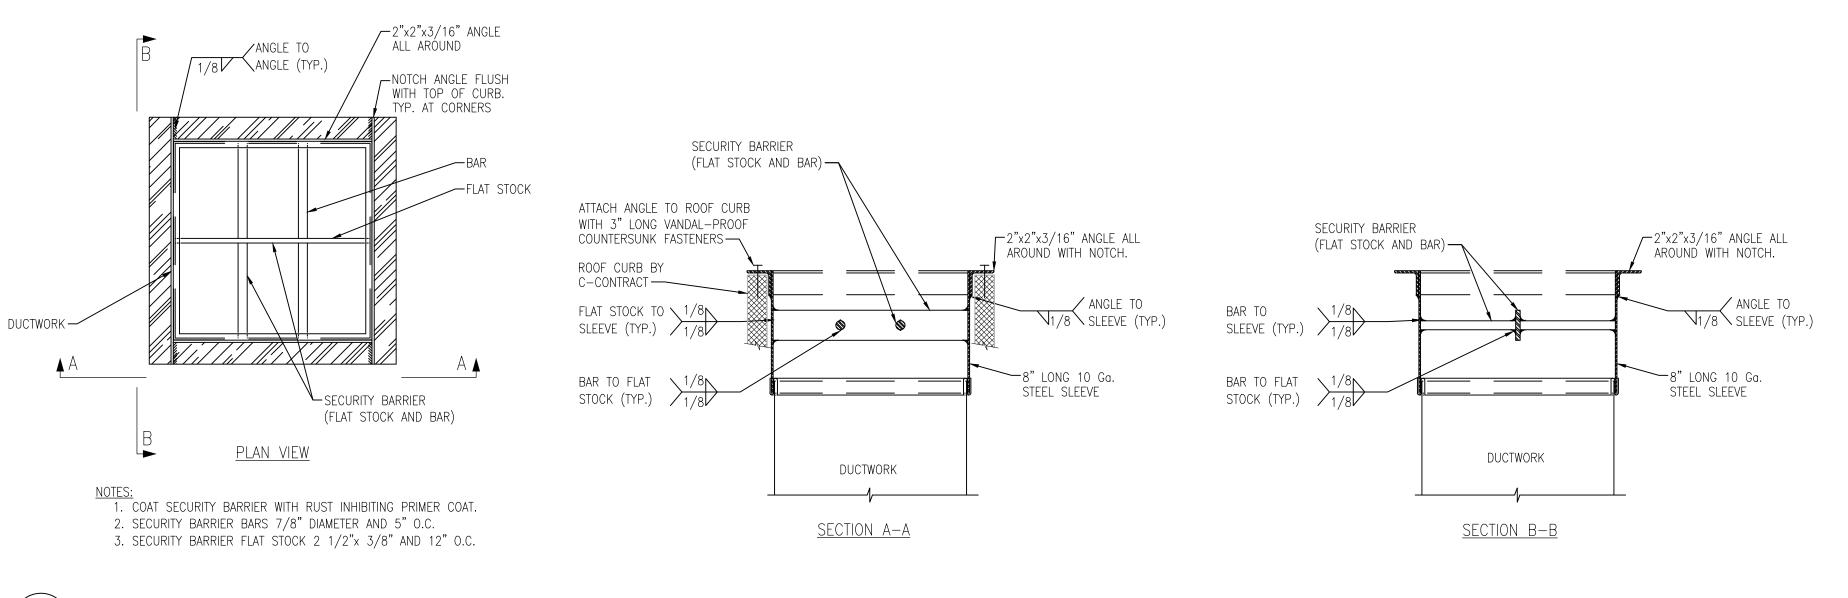

STEEL SECURITY BAR DETAIL M-502 SCALE: NOT TO SCALE

ADDENDUM DRAWING 04/15/2025

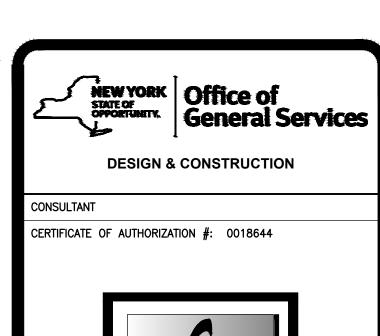

SAGE ENGINEERING ASSOCIATES, LLP

TO THE BEST OF THE REGISTERED DESIGN PROFESSIONAL'S KNOWLEDGE, BELIEF AND PROFESSIONAL JUDGEMENT, THESE PLANS AND/OR SPECIFICATIONS ARE IN COMPLIANCE WITH THE 2020 ENERGY CODE.

TO THE BEST OF THE REGISTERED DESIGN PROFESSIONAL'S KNOWLEDGE, BELIEF AND PROFESSIONAL JUDGEMENT, THESE PLANS AND/OR SPECIFICATIONS ARE IN COMPLIANCE WITH THE 2020 UNIFORM CODE.

THE ALTERATION OF THIS MATERIAL IN ANY WAY, UNLESS DONE UNDER THE DIRECTION OF A COMPARABLE PROFESSIONAL, I.E. ARCHITECT FOR AN ARCHITECT, ENGINEER FOR AN ENGINEER OR LANDSCAPE ARCHITECT FOR A LANDSCAPE ARCHITECT, IS A VIOLATION OF THE NEW YORK STATE EDUCATION LAW AND/OR REGULATIONS AND IS A CLASS 'A' MISDEMEANOR.



02/28/2026

HVAC

PROVIDE FACILITY-WIDE CCTV AUDIO MONITORING SYSTEM & CIVILIAN PERSONAL ALARM SYSTEM

MARCY CORRECTIONAL FACILITY 9000 OLD RIVER ROAD MARCY, NY

DEPARTMENT OF CORRECTIONS AND COMMUNITY SUPERVISION


/		
$\bigcirc$	04/15/2025	ADDDENDUM 1
	03/20/2025	BID DOCUMENT
MARK	DATE	DESCRIPTION
PROJECT NUMBER:	46240-H	
DESIGNED BY:	DPL	
DRAWN BY:	AZ	
FIELD CHECK:	-	
APPROVED:	DPL	
SHEET TITLE:		

**DETAILS** 

DRAWING NUMBER:

M - 502

or **227** SHEET 54

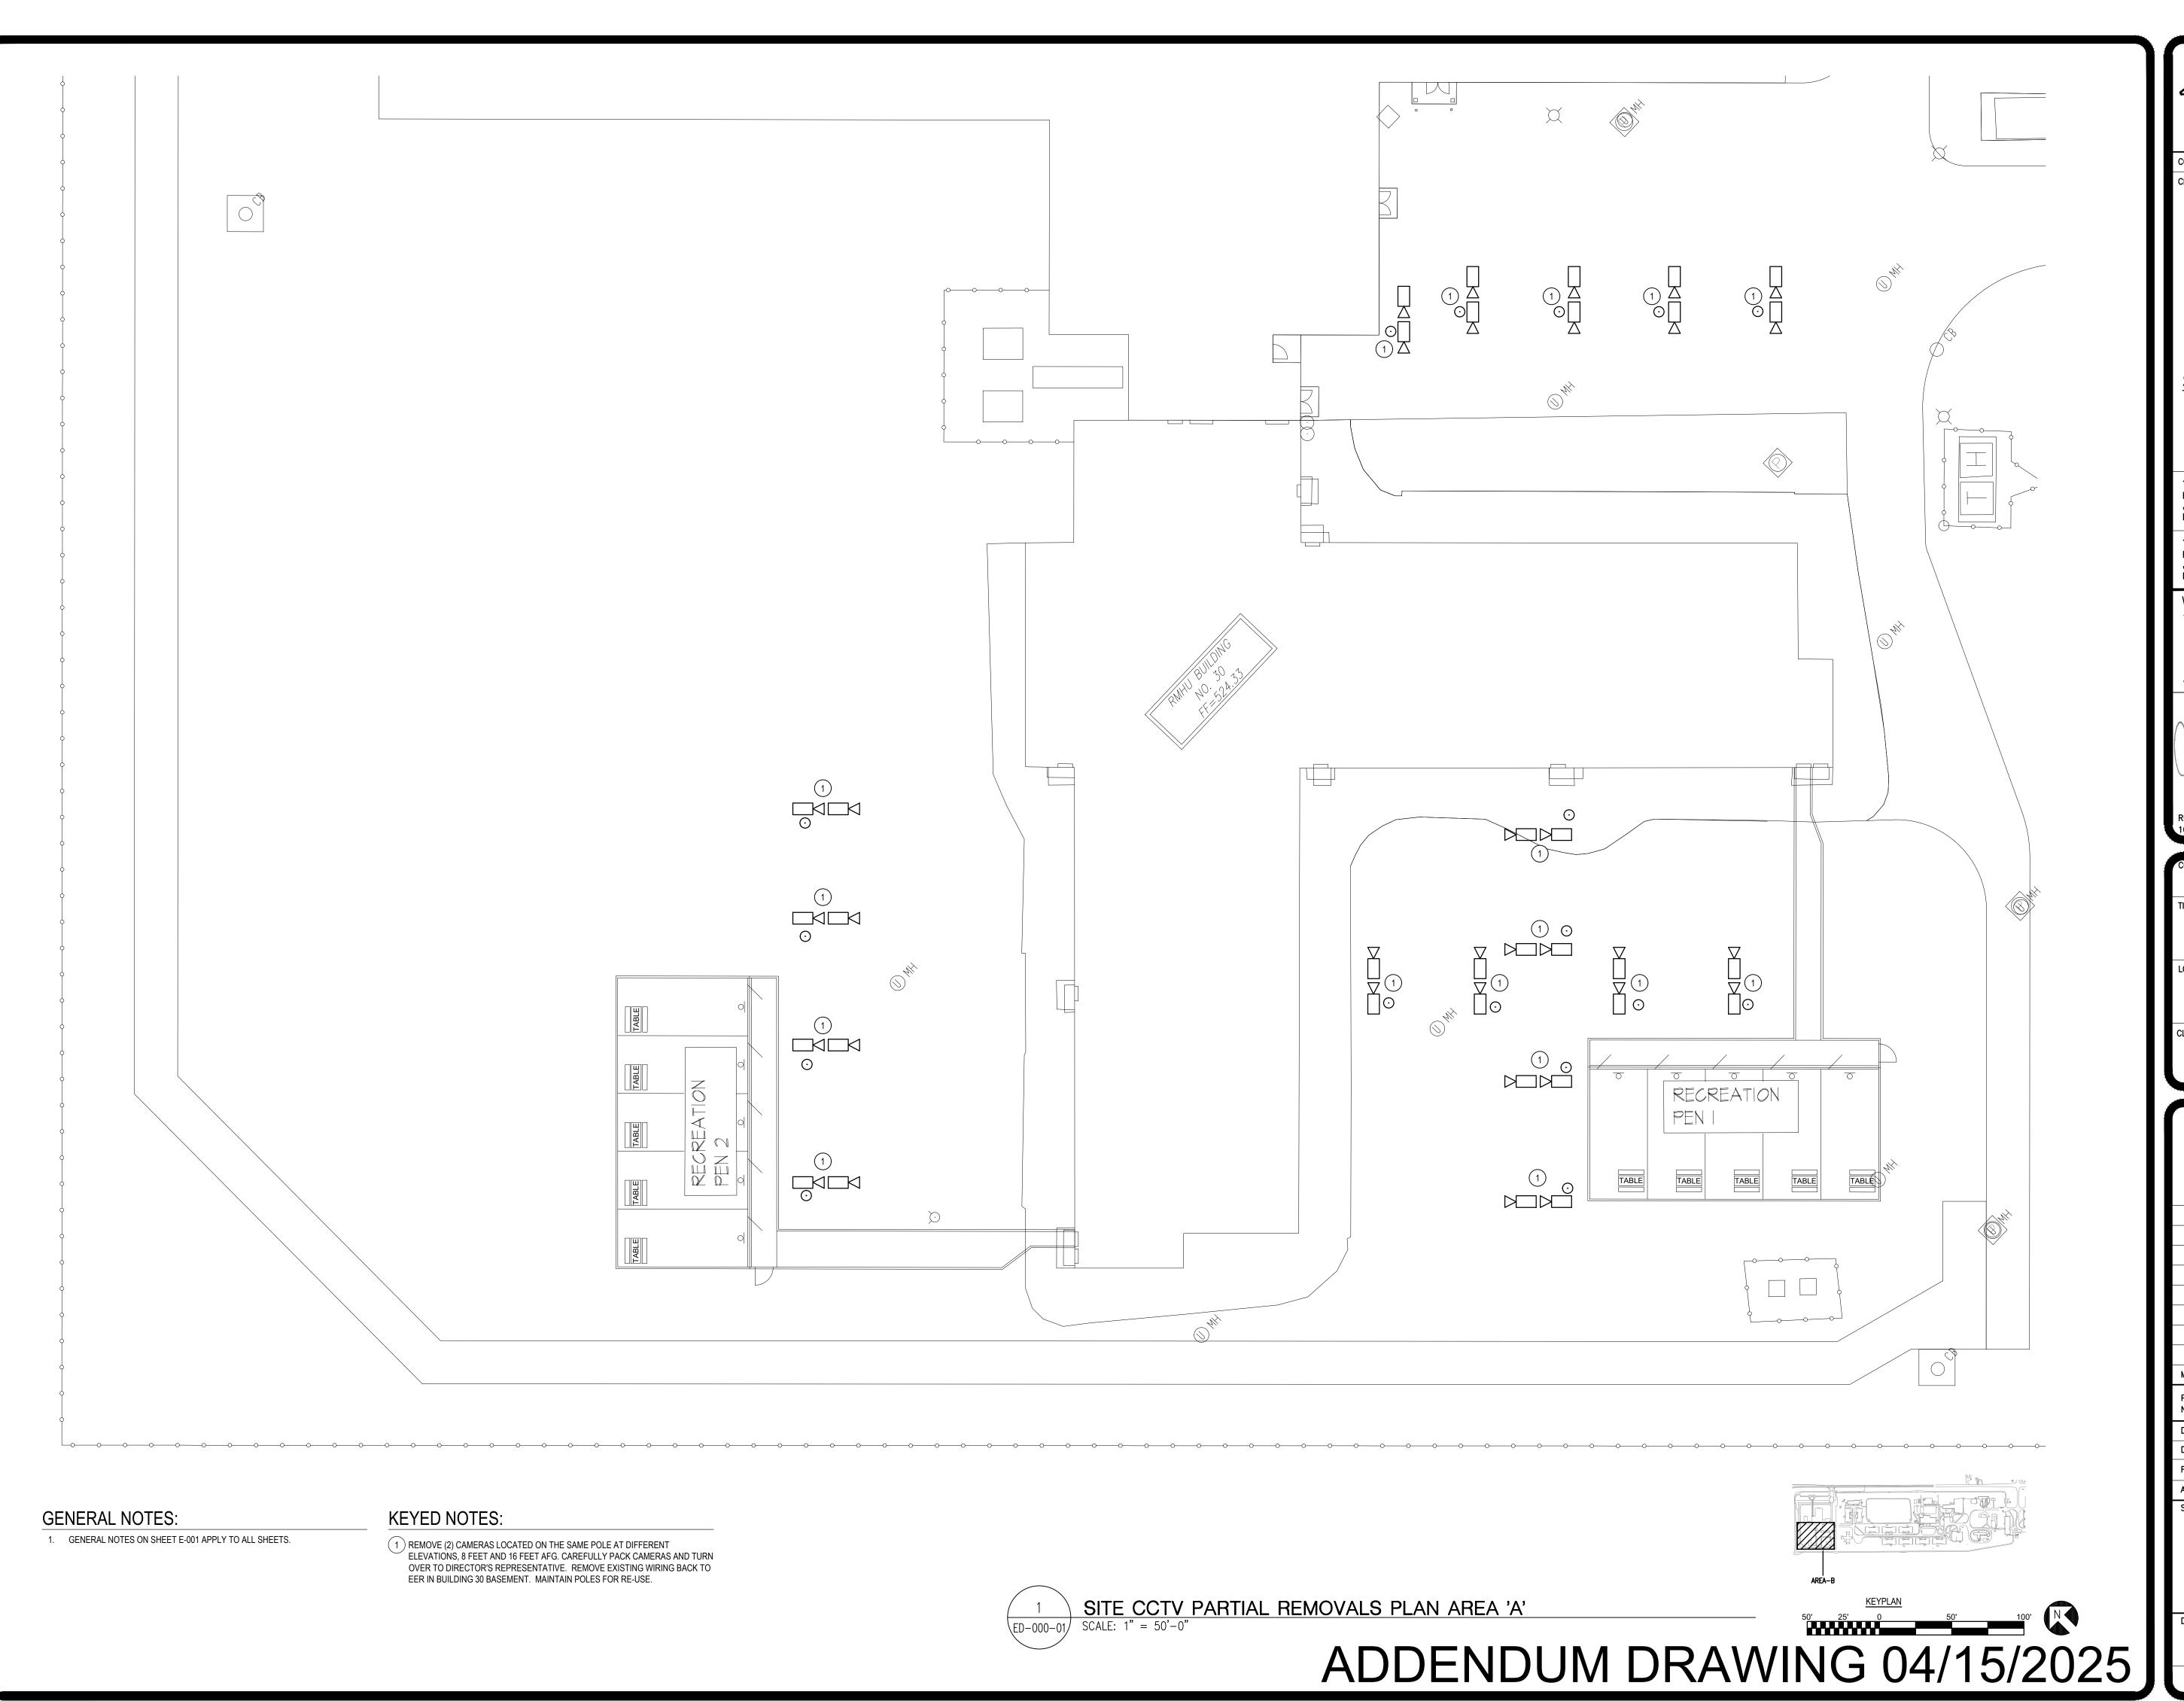




**DESIGN & CONSTRUCTION** 

CONSULTANT

CERTIFICATE OF AUTHORIZATION #: 0018644

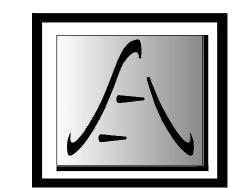

SAGE ENGINEERING ASSOCIATES, LLP

TO THE BEST OF THE REGISTERED DESIGN PROFESSIONAL'S KNOWLEDGE, BELIEF AND PROFESSIONAL JUDGEMENT, THESE PLANS AND/OR SPECIFICATIONS ARE IN COMPLIANCE WITH THE 2020 ENERGY CODE.

TO THE BEST OF THE REGISTERED DESIGN PROFESSIONAL'S KNOWLEDGE, BELIEF AND PROFESSIONAL JUDGEMENT, THESE PLANS AND/OR SPECIFICATIONS ARE IN COMPLIANCE WITH THE 2020 UNIFORM CODE.

THE ALTERATION OF THIS MATERIAL IN ANY WAY, UNLESS DONE UNDER THE DIRECTION OF A COMPARABLE PROFESSIONAL, I.E. ARCHITECT FOR AN ARCHITECT, ENGINEER FOR AN ENGINEER OR LANDSCAPE ARCHITECT FOR A LANDSCAPE ARCHITECT, IS A VIOLATION OF THE NEW YORK STATE EDUCATION LAW AND/OR REGULATIONS AND IS A CLASS 'A' MISDEMEANOR.



10/31/2026

# ELECTRICAL

PROVIDE FACILITY—WIDE CCTV AUDIO MONITORING SYSTEM &
CIVILIAN PERSONAL ALARM SYSTEM

MARCY CORRECTIONAL FACILITY 9000 OLD RIVER ROAD MARCY, NY


DEPARTMENT OF CORRECTIONS AND COMMUNITY SUPERVISION

	2 / / 4 = /222		
<u> </u>	04/15/2025	ADDDENDUM 1	
	03/20/2025	BID DOCUMENT	
MARK	DATE	DESCRIPTION	
PROJECT NUMBER:	46240-E		
DESIGNED BY:	GWC		
DRAWN BY:	RET		
FIELD CHECK:			
APPROVED:	МОМ		
SHEET TITLE:			
SITE CCTV			
PARTIAL			
	REMOVAL		

AREA 'A'

ED-000-01

of **227** 

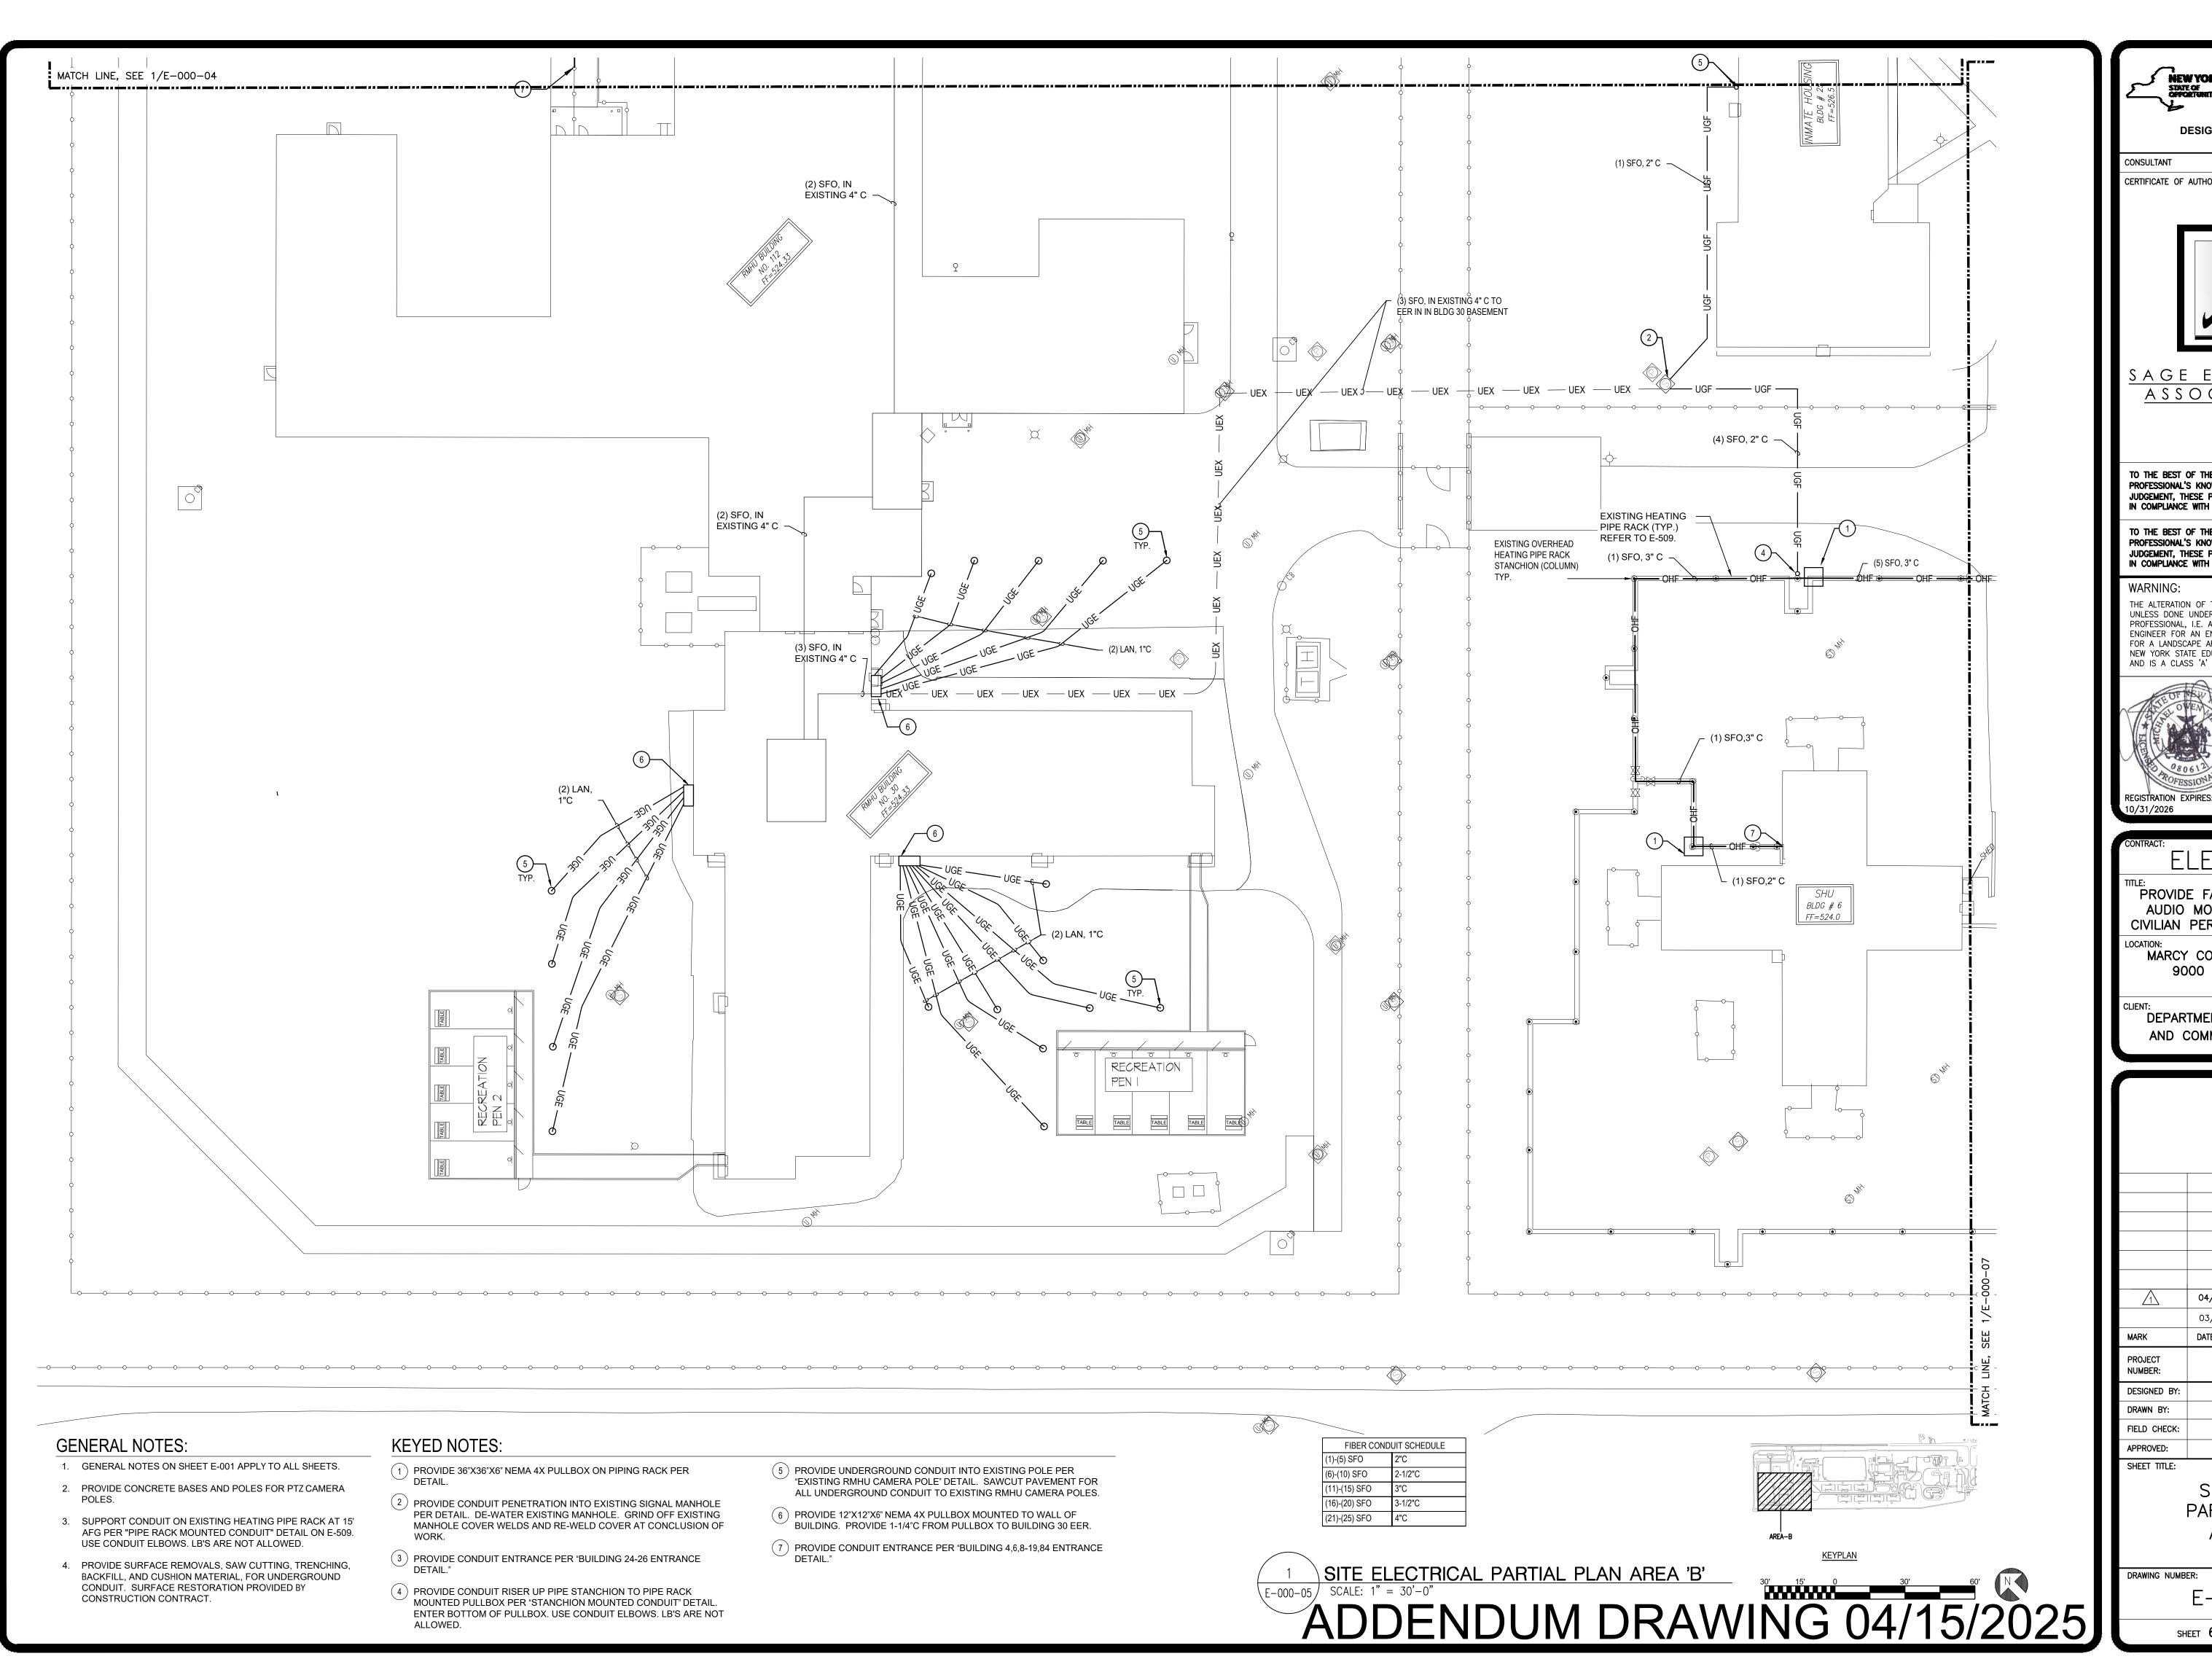

NEW YORK Office of General Services **DESIGN & CONSTRUCTION** CONSULTANT CERTIFICATE OF AUTHORIZATION #: 0018644 SAGE ENGINEERING ASSOCIATES, LLP TO THE BEST OF THE REGISTERED DESIGN PROFESSIONAL'S KNOWLEDGE, BELIEF AND PROFESSIONAL JUDGEMENT, THESE PLANS AND/OR SPECIFICATIONS ARE IN COMPLIANCE WITH THE 2020 ENERGY CODE. TO THE BEST OF THE REGISTERED DESIGN PROFESSIONAL'S KNOWLEDGE, BELIEF AND PROFESSIONAL JUDGEMENT, THESE PLANS AND/OR SPECIFICATIONS ARE IN COMPLIANCE WITH THE 2020 UNIFORM CODE. THE ALTERATION OF THIS MATERIAL IN ANY WAY, UNLESS DONE UNDER THE DIRECTION OF A COMPARABLE PROFESSIONAL, I.E. ARCHITECT FOR AN ARCHITECT, ENGINEER FOR AN ENGINEER OR LANDSCAPE ARCHITECT FOR A LANDSCAPE ARCHITECT, IS A VIOLATION OF THE NEW YORK STATE EDUCATION LAW AND/OR REGULATIONS AND IS A CLASS 'A' MISDEMEANOR.

# ELECTRICAL

PROVIDE FACILITY-WIDE CCTV AUDIO MONITORING SYSTEM & CIVILIAN PERSONAL ALARM SYSTEM

MARCY CORRECTIONAL FACILITY 9000 OLD RIVER ROAD MARCY, NY


DEPARTMENT OF CORRECTIONS AND COMMUNITY SUPERVISION


04/15/2025 | ADDDENDUM 1 03/20/2025 | BID DOCUMENT DESCRIPTION 46240-E NUMBER: DESIGNED BY: FIELD CHECK: APPROVED: MOM SHEET TITLE: SITE FIBER PARTIAL PLAN AREA 'B'


E-000-05

SHEET 69


of **227** 

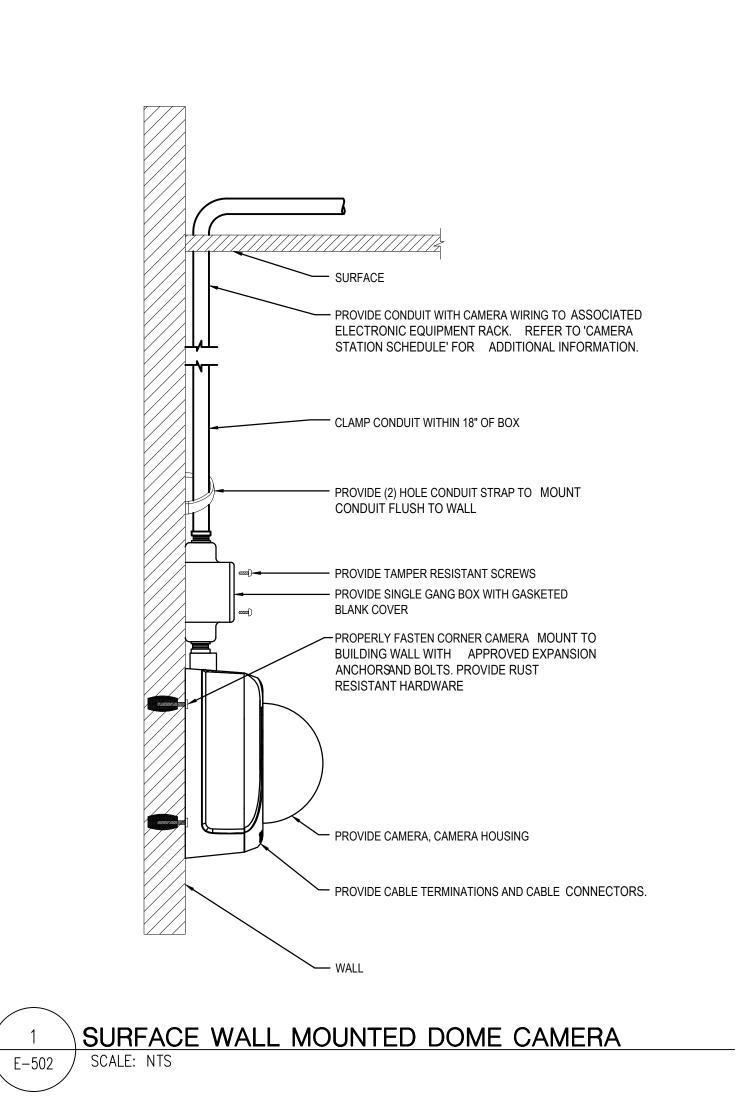

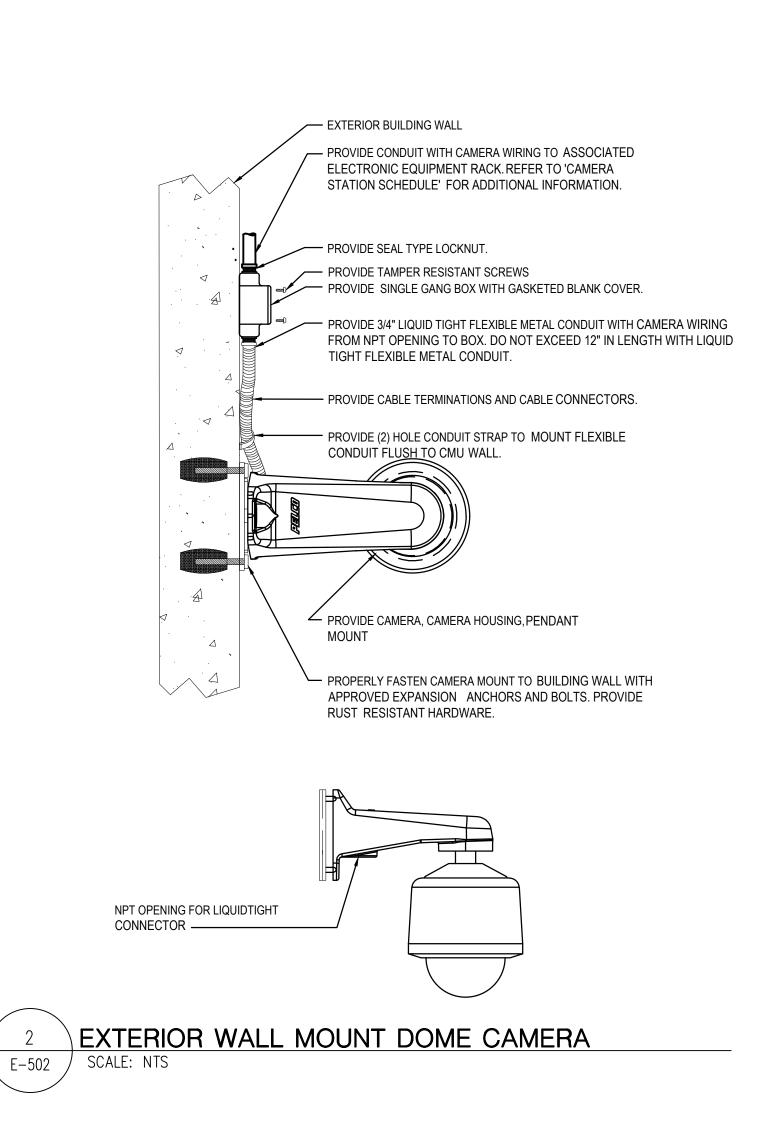


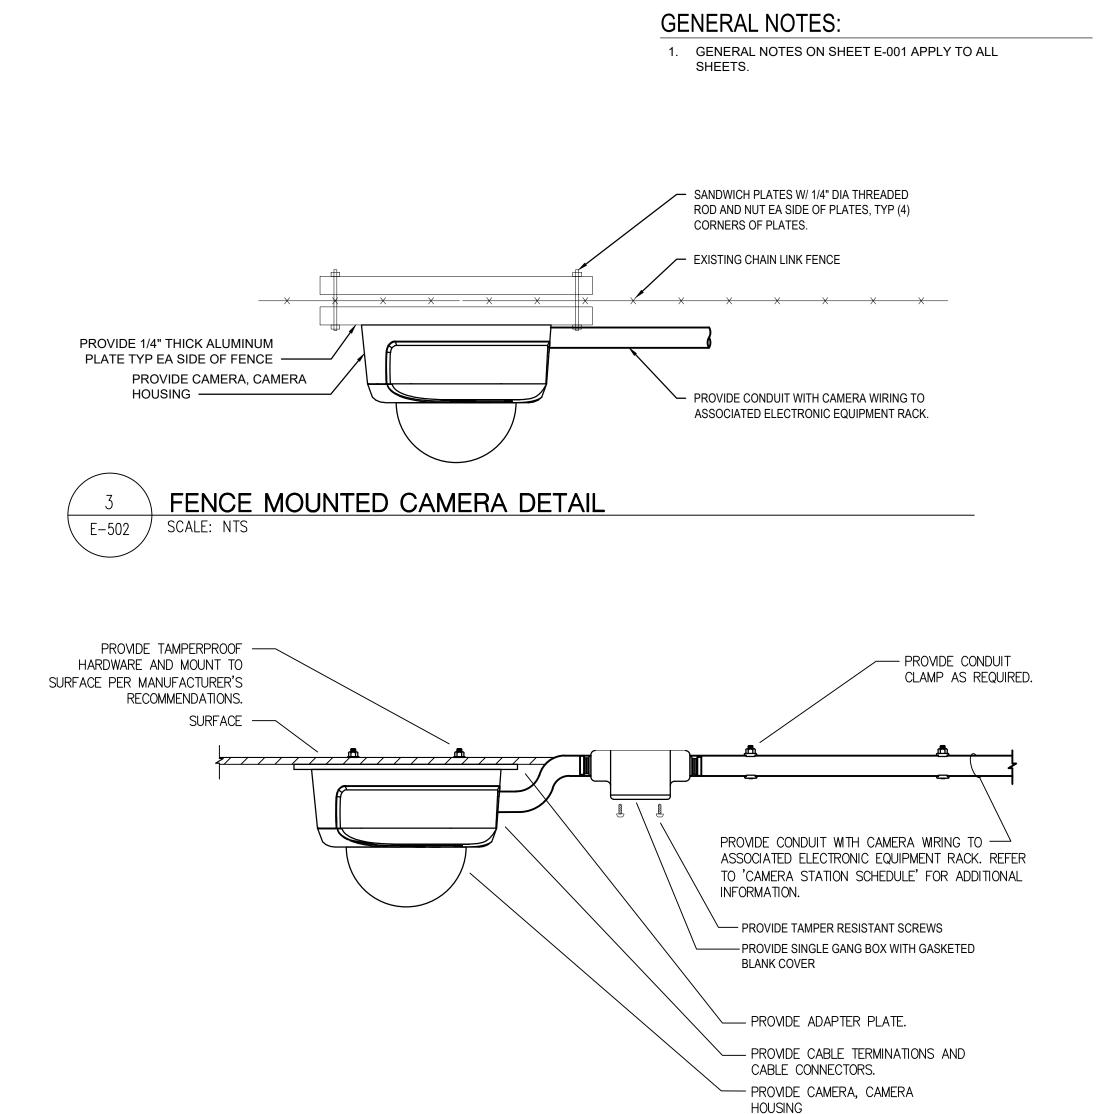


NON-ACCESSIBLE CEILING SURFACE MOUNTED DOME CAMERA E-502

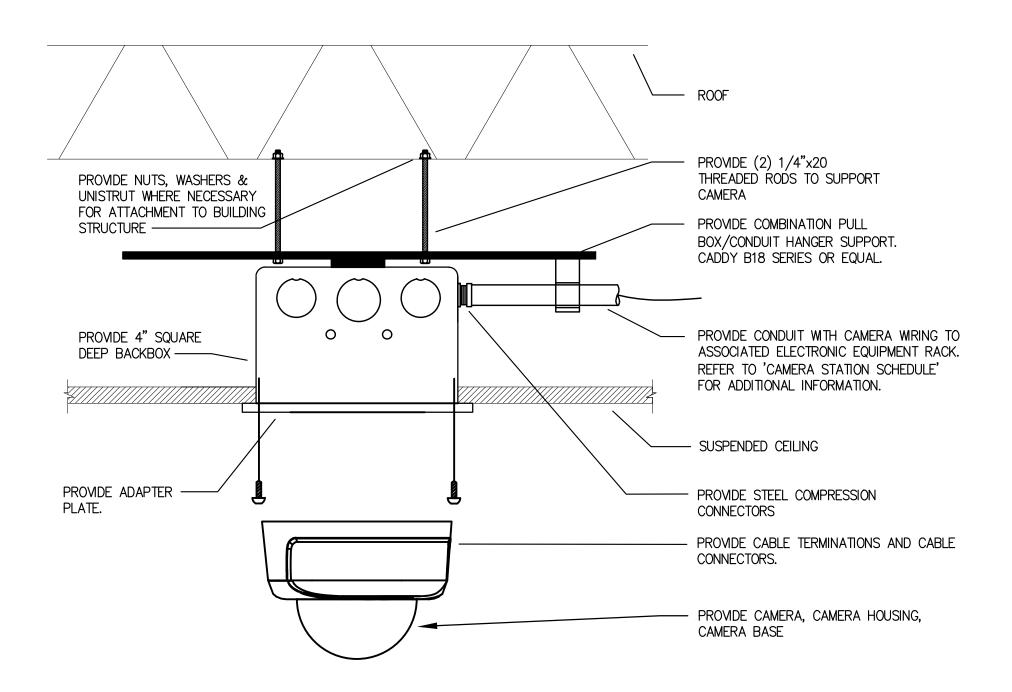

INTERIOR SUSPENDED CEILING DOME CAMERA

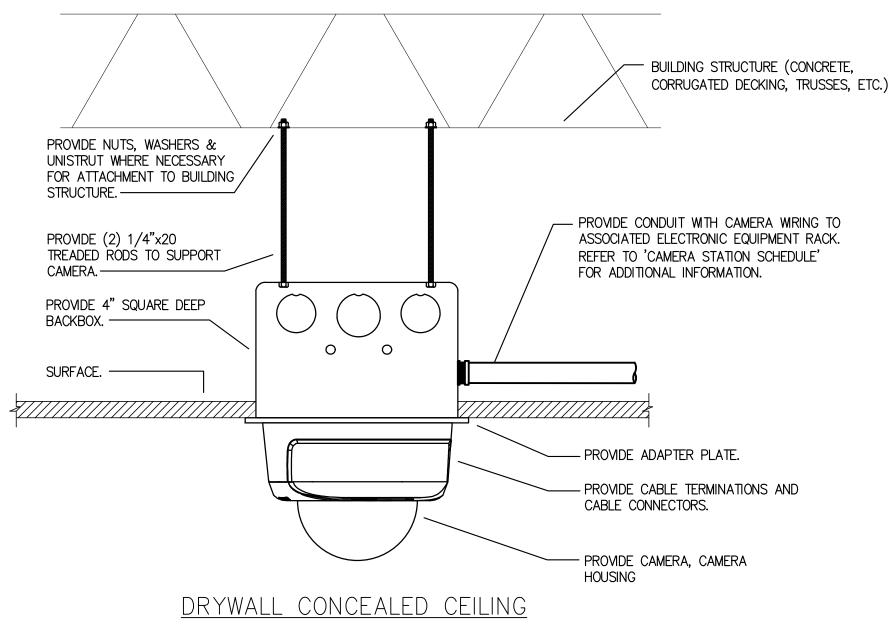

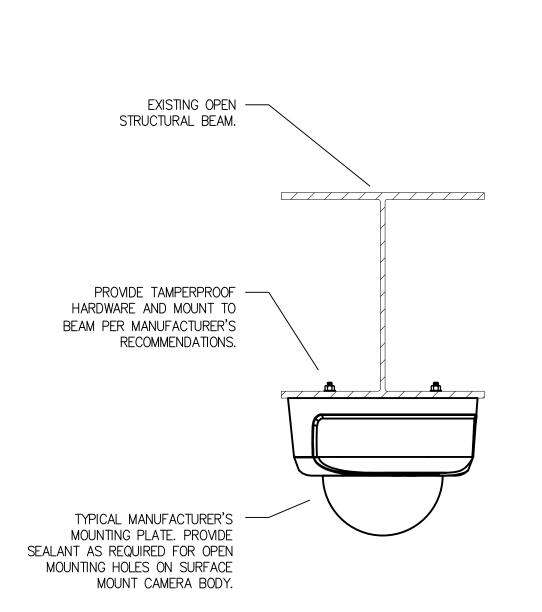

E-502 / SCALE: NTS

SURFACE CEILING MOUNTED DOME CAMERA

BEAM CLAMP CEILING SURFACE MOUNTED DOME CAMERA


ADDENDUM DRAWING 04/15/2025



**DESIGN & CONSTRUCTION** 

CONSULTANT

CERTIFICATE OF AUTHORIZATION #: 0018644

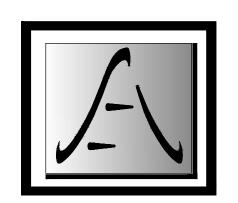

SAGE ENGINEERING ASSOCIATES, LLP

TO THE BEST OF THE REGISTERED DESIGN PROFESSIONAL'S KNOWLEDGE. BELIEF AND PROFESSIONAL JUDGEMENT, THESE PLANS AND/OR SPECIFICATIONS ARE IN COMPLIANCE WITH THE 2020 ENERGY CODE.

TO THE BEST OF THE REGISTERED DESIGN PROFESSIONAL'S KNOWLEDGE, BELIEF AND PROFESSIONAL JUDGEMENT, THESE PLANS AND/OR SPECIFICATIONS ARE IN COMPLIANCE WITH THE 2020 UNIFORM CODE.

THE ALTERATION OF THIS MATERIAL IN ANY WAY, UNLESS DONE UNDER THE DIRECTION OF A COMPARABLE PROFESSIONAL, I.E. ARCHITECT FOR AN ARCHITECT, ENGINEER FOR AN ENGINEER OR LANDSCAPE ARCHITECT FOR A LANDSCAPE ARCHITECT, IS A VIOLATION OF THE NEW YORK STATE EDUCATION LAW AND/OR REGULATIONS AND IS A CLASS 'A' MISDEMEANOR.



**REGISTRATION EXPIRES:** 10/31/2026

# ELECTRICAL

PROVIDE FACILITY—WIDE CCTV AUDIO MONITORING SYSTEM & CIVILIAN PERSONAL ALARM SYSTEM

MARCY CORRECTIONAL FACILITY 9000 OLD RIVER ROAD MARCY, NY

DEPARTMENT OF CORRECTIONS AND COMMUNITY SUPERVISION

04/15/2025 ADDDENDUM 1 01/03/2025 BID DOCUMENT DESCRIPTION 46240-E NUMBER: DESIGNED BY: DRAWN BY: RET FIELD CHECK: APPROVED: MOM SHEET TITLE: CAMERA MOUNTING

DETAILS

DRAWING NUMBER:


E - 502

of 205 SHEET **135** 

E-502 / SCALE: NTS



1. GENERAL NOTES ON SHEET E-001 APPLY TO ALL SHEETS.

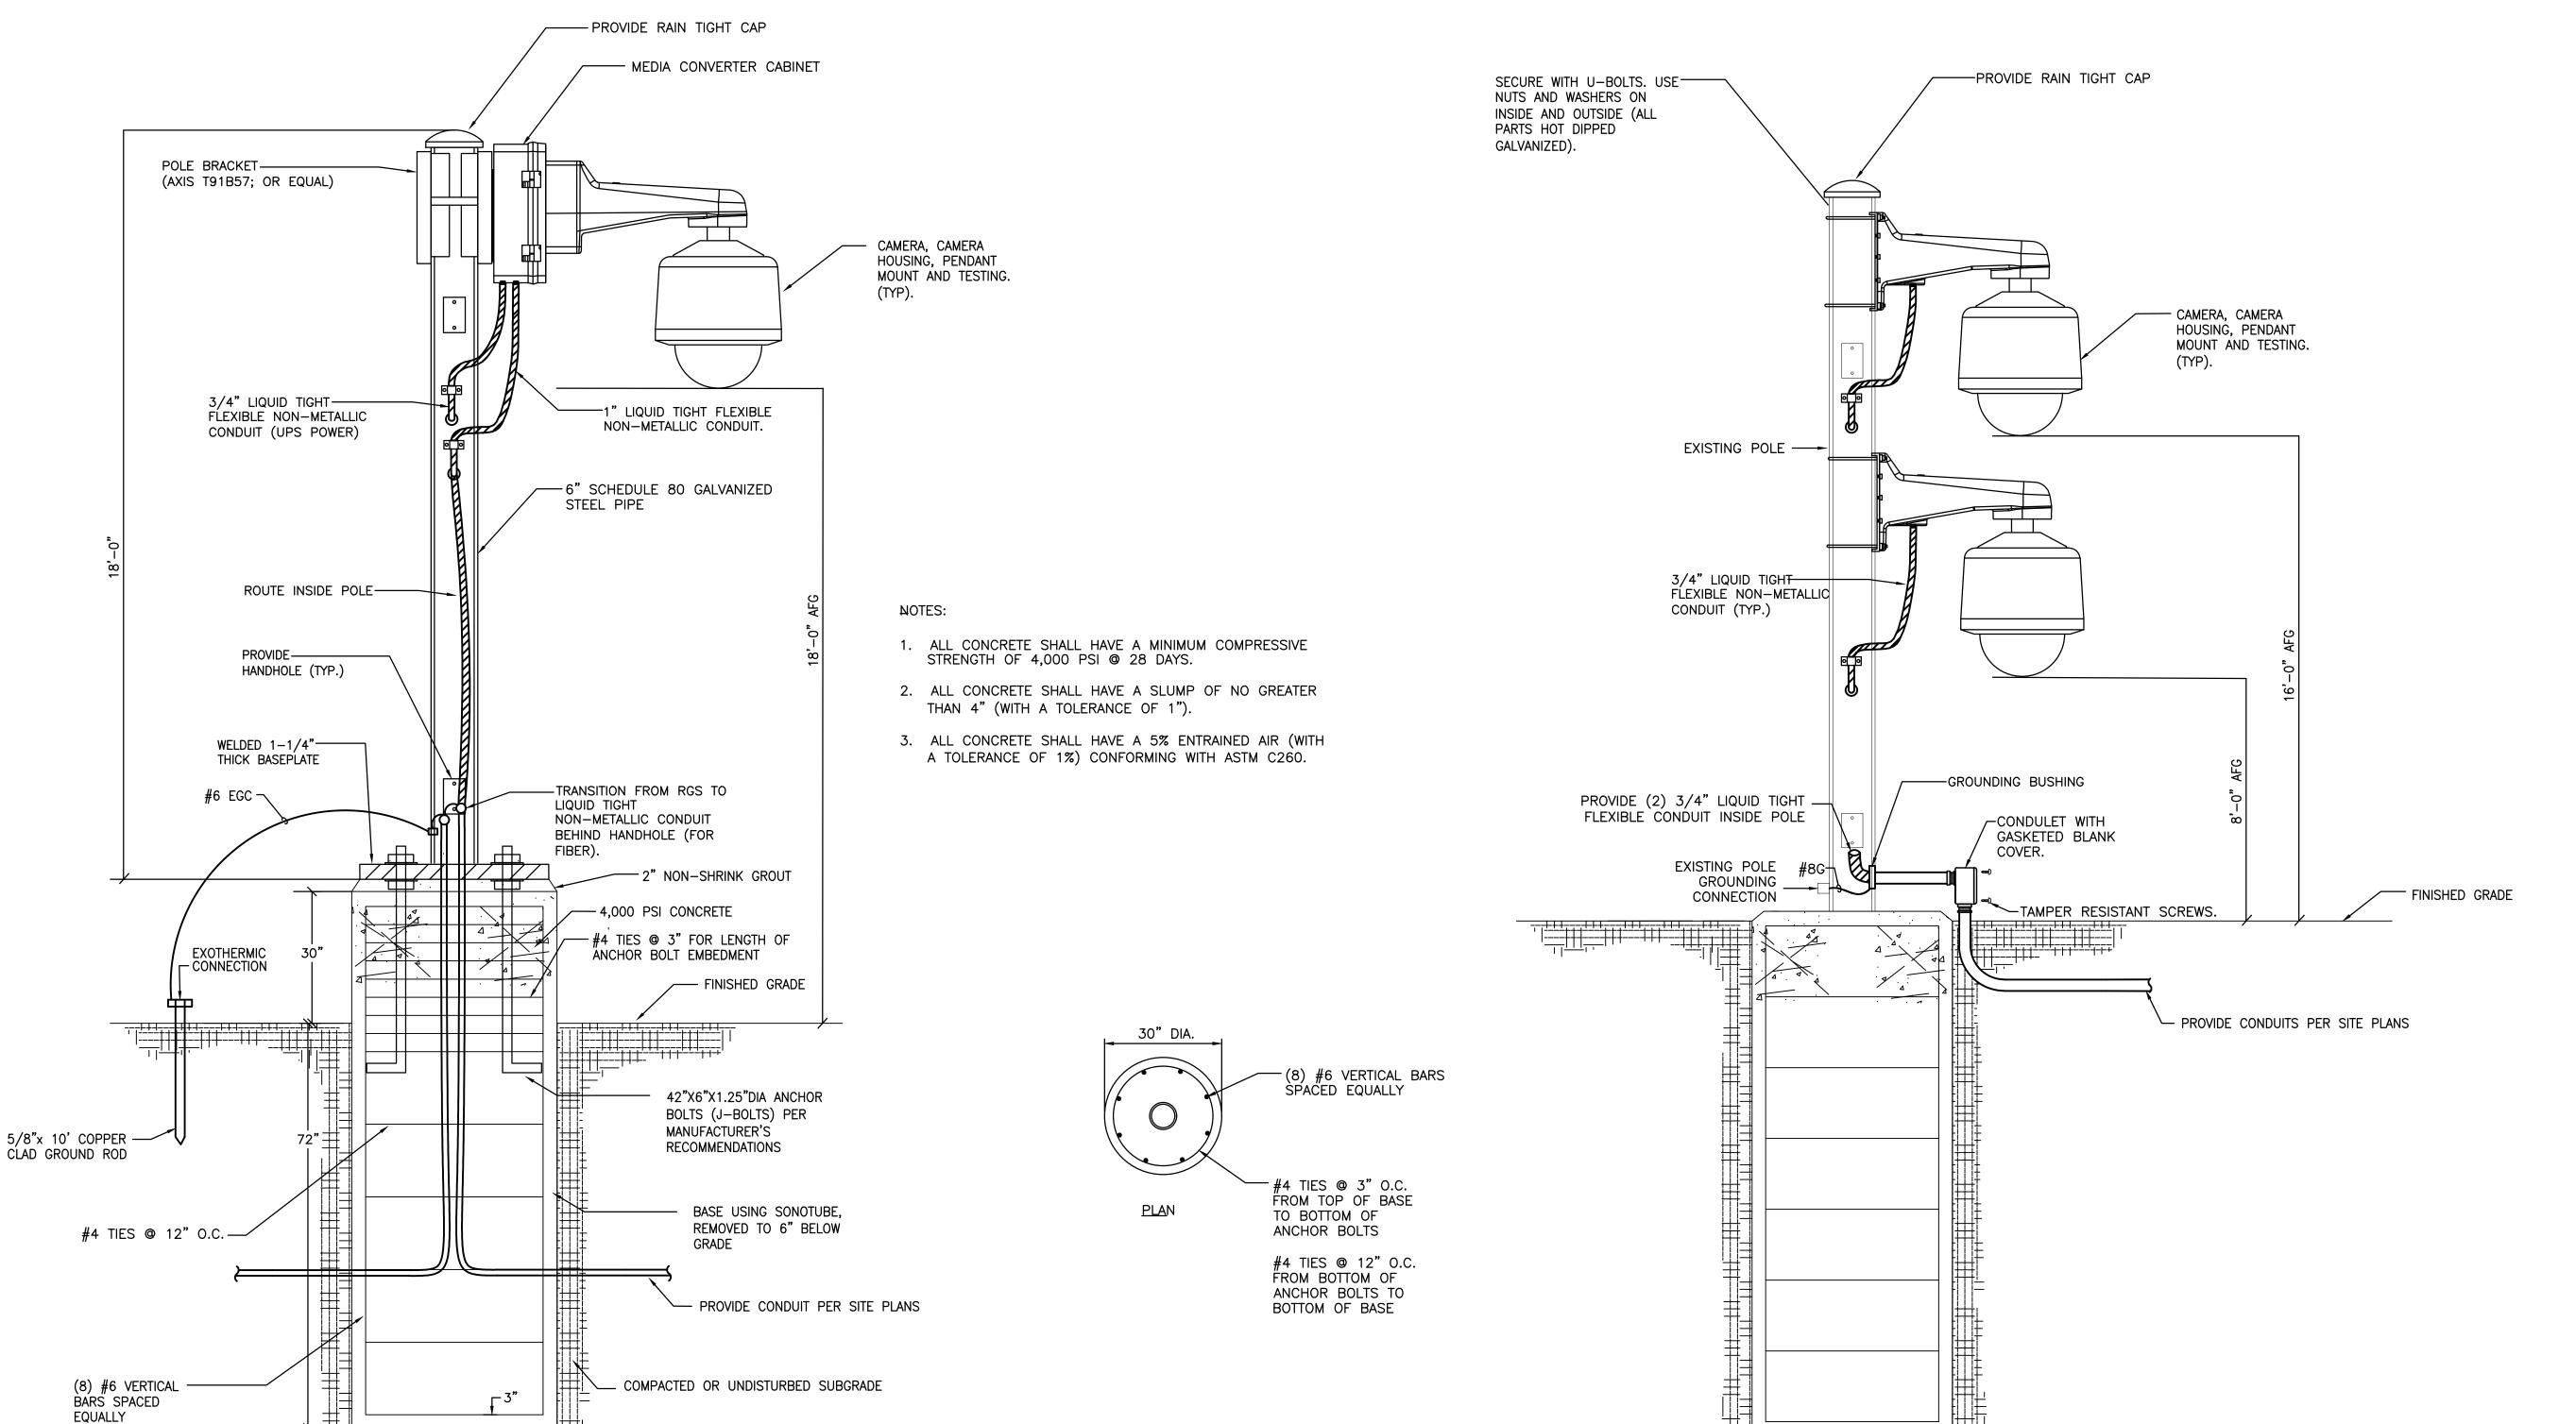


NEW YORK Office of General Services

**DESIGN & CONSTRUCTION** 

CONSULTANT

CERTIFICATE OF AUTHORIZATION #: 0018644

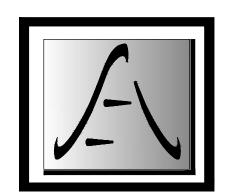

SAGE ENGINEERING ASSOCIATES, LLP

TO THE BEST OF THE REGISTERED DESIGN PROFESSIONAL'S KNOWLEDGE, BELIEF AND PROFESSIONAL JUDGEMENT, THESE PLANS AND/OR SPECIFICATIONS ARE IN COMPLIANCE WITH THE 2020 ENERGY CODE.

TO THE BEST OF THE REGISTERED DESIGN PROFESSIONAL'S KNOWLEDGE, BELIEF AND PROFESSIONAL JUDGEMENT, THESE PLANS AND/OR SPECIFICATIONS ARE IN COMPLIANCE WITH THE 2020 UNIFORM CODE.

THE ALTERATION OF THIS MATERIAL IN ANY WAY, UNLESS DONE UNDER THE DIRECTION OF A COMPARABLE PROFESSIONAL, I.E. ARCHITECT FOR AN ARCHITECT, ENGINEER FOR AN ENGINEER OR LANDSCAPE ARCHITECT FOR A LANDSCAPE ARCHITECT, IS A VIOLATION OF THE NEW YORK STATE EDUCATION LAW AND/OR REGULATIONS AND IS A CLASS 'A' MISDEMEANOR.



10/31/2026

# ELECTRICAL

PROVIDE FACILITY-WIDE CCTV AUDIO MONITORING SYSTEM & CIVILIAN PERSONAL ALARM SYSTEM

MARCY CORRECTIONAL FACILITY 9000 OLD RIVER ROAD MARCY, NY

DEPARTMENT OF CORRECTIONS AND COMMUNITY SUPERVISION

04/15/2025 | ADDDENDUM 1 03/20/2025 | BID DOCUMENT DESCRIPTION 46240-E NUMBER: DESIGNED BY: FIELD CHECK: APPROVED: MOM SHEET TITLE:

CAMERA MOUNTING **DETAILS** 


E - 503

SHEET **136** of **227** 

PTZ CAMERA POLE DETAIL E-503 SCALE: NTS

E-503 /


EXISTING RMHU CAMERA POLE

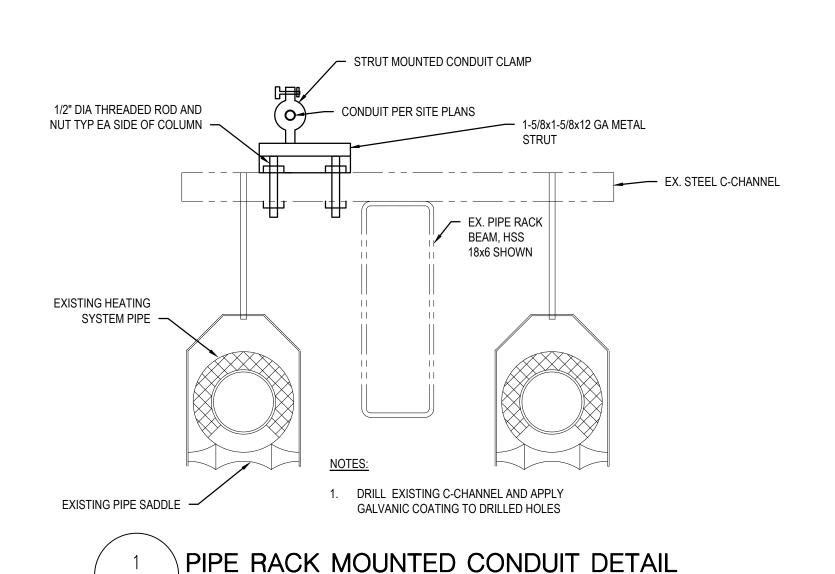


# 1/2" DIA THREADED ROD AND NUT TYP EA SIDE OF COLUMN 1-5/8x1-5/8x12 GA METAL STRUT, TYP TOP AND BOTTOM - EX PIPE STANCHION COLUMN, HSS 10x10 SHOWN STRUT MOUNTED CONDUIT CLAMP — CONDUIT RISER PER SITE PLANS 3" MIN TYP

- NOTES:
- 1. HOT-DIP GALVANIZE ALL STEEL AND ASSOCIATED HARDWARE PER ASTM A123.
- 2. PROVIDE SUPPORT OF CONDUIT RISER AT (2) LOCATIONS ON STANCHION- 2' ABOVE



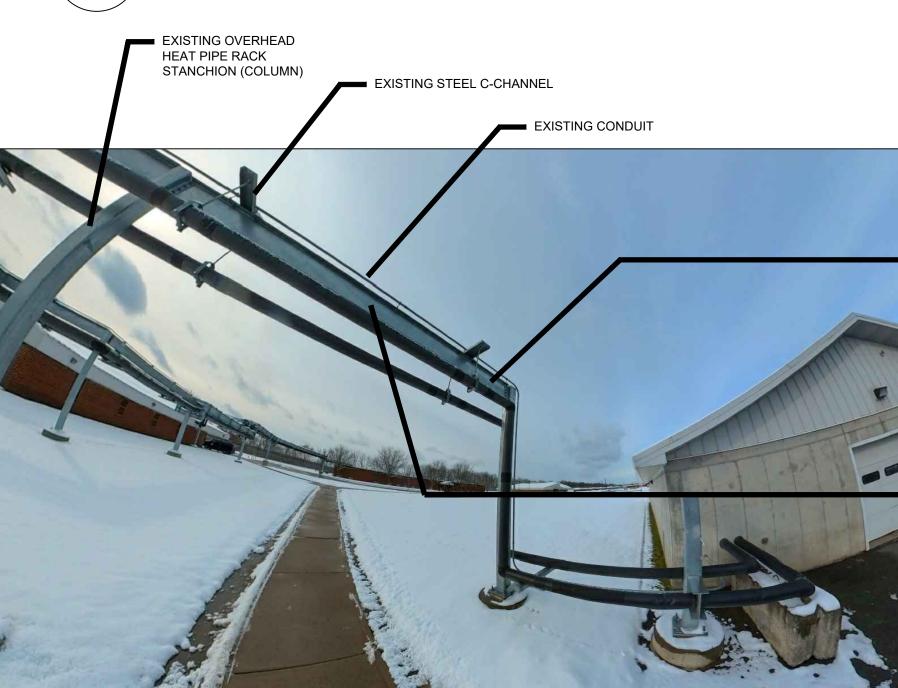

TYPICAL EXISTING OVERHEAD HEATING PIPE RACK PHOTO

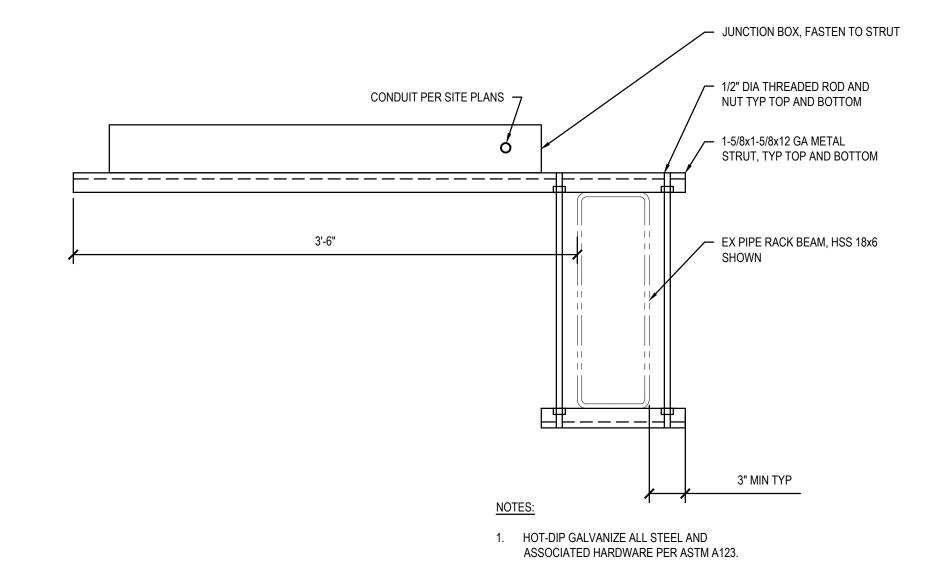

PIPE RACK MOUNTED JUNCTION BOX DETAIL SCALE: NTS



EXISTING OVERHEAD HEATING PIPE RACK ROUTE PHOTO SCALE: NTS

■ EXISTING OVERHEAD HEAT PIPE RACK BEAM

EXISTING OVERHEAD HEAT PIPE RACK BEAM

- 1. GENERAL NOTES ON SHEET E-001 APPLY TO ALL SHEETS.
- 2. PROVIDE PIPE RACK MOUNTED JUNCTION BOXES (PER DETAIL 2 WHERE INDICATED ON SITE PLANS, AND FOR ANY SUPPLEMENTAL BOXES REQUIRED BY FIELD CONDITIONS.
- 3. PROVIDE SUPPORT FOR CONDUIT MOUNTED ON PIPE RACK PER DETAIL 1. MAXIMUM SUPPORT SPACING (PER NEC) SHALL BE 20' FOR 3" CONDUIT AND 16' FOR 2" CONDUIT. SPACING OF EXISTING STEEL C-CHANNEL IS 19' PER AS-BUILT DRAWINGS. WHERE MAXIMUM SPACING CANNOT BE ACHIEVED PROVIDE ADDITIONAL CONDUIT SUPPORTS WITH UNISTRUT MOUNTED TO PIPE RACK BEAM PER DETAIL 2. PROVIDE CONDUIT SUPPORTS WITHIN 3' OF ALL PULLBOXES.
- 4. USE CONDUIT ELBOWS IN ALL FIBER CONDUIT RUNS. CONDUIT LB'S ARE NOT ALLOWED.


**GENERAL NOTES:** 

NEW YORK Office of STATE OF GENERAL Services

**DESIGN & CONSTRUCTION** 

CONSULTANT

CERTIFICATE OF AUTHORIZATION #: 0018644

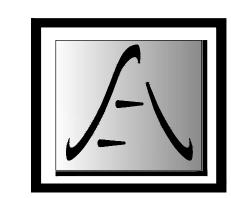

SAGE ENGINEERING ASSOCIATES, LLP

TO THE BEST OF THE REGISTERED DESIGN PROFESSIONAL'S KNOWLEDGE, BELIEF AND PROFESSIONAL JUDGEMENT, THESE PLANS AND/OR SPECIFICATIONS ARE IN COMPLIANCE WITH THE 2020 ENERGY CODE.

TO THE BEST OF THE REGISTERED DESIGN PROFESSIONAL'S KNOWLEDGE, BELIEF AND PROFESSIONAL JUDGEMENT, THESE PLANS AND/OR SPECIFICATIONS ARE IN COMPLIANCE WITH THE 2020 UNIFORM CODE.

THE ALTERATION OF THIS MATERIAL IN ANY WAY, UNLESS DONE UNDER THE DIRECTION OF A COMPARABLE PROFESSIONAL, I.E. ARCHITECT FOR AN ARCHITECT, ENGINEER FOR AN ENGINEER OR LANDSCAPE ARCHITECT FOR A LANDSCAPE ARCHITECT, IS A VIOLATION OF THE NEW YORK STATE EDUCATION LAW AND/OR REGULATIONS AND IS A CLASS 'A' MISDEMEANOR.



**REGISTRATION EXPIRES:** 10/31/2026

# ELECTRICAL

PROVIDE FACILITY-WIDE CCTV AUDIO MONITORING SYSTEM & CIVILIAN PERSONAL ALARM SYSTEM

MARCY CORRECTIONAL FACILITY 9000 OLD RIVER ROAD MARCY, NY

DEPARTMENT OF CORRECTIONS AND COMMUNITY SUPERVISION

04/15/2025 | ADDDENDUM 1 03/20/2025 | BID DOCUMENT DESCRIPTION 46240-E NUMBER: DESIGNED BY: FIELD CHECK: APPROVED: MOM SHEET TITLE: **DETAILS** 

E - 509

SHEET 142

of **227** 

ADDENDUM DRAWING 04/15/2025