

## DESIGN & CONSTRUCTION GROUP THE GOVERNOR NELSON A. ROCKEFELLER EMPIRE STATE PLAZA ALBANY, NY 12242

## ADDENDUM NO. 3 TO PROJECT NO. 47513

## CONSTRUCTION, HVAC, PLUMBING AND ELECTRICAL WORK REHABILITATE STORAGE SPACE, BUILDING 140 WASHINGTON CORRECTIONAL ANNEX BUILDING 72 LOCK 11 LANE COMSTOCK, NY

June 27, 2024

**NOTE:** This Addendum forms a part of the Contract Documents. Insert it in the Project Manual. Acknowledge receipt of this Addendum in the space provided on the Bid Form.

## **GENERAL REQUIREMENTS – COMMON DOCUMENTS**

- 1. Page 011000 2: Article 1.06: ADD Paragraph B to Read:
  - "B. Any work requiring access to the occupied areas of this building will be required to take place from 9:00AM to 5:00PM. Work in the unoccupied areas is acceptable starting at 7:00AM for normal work shifts."

## **ELECTRICAL WORK SPECIFICATIONS**

- 2. Page 260519 2, Subparagraph 2.01.D.1.d: DELETE Subparagraph and all mention of MC type cable.
- 3. Page 260519 9, Subparagraph 3.10.A.8: DELETE Subparagraph in its entirety.

## **CONSTRUCTION WORK DRAWINGS**

- 4. Revised Drawings:
  - a. Drawing No. A-001, noted "Addendum 3 6/27/24", accompanies this Addendum and supersedes the same numbered originally issued drawing.

## ELECTRICAL WORK DRAWINGS

- 5. Revised Drawings:
  - a. Drawing Nos. E-101, ED-101, E-201, E-301, E-601, and SE-101, noted "Addendum 3 6/27/24", accompany this Addendum and supersede the same numbered originally issued drawings.

## **END OF ADDENDUM**

Brady Sherlock, P.E. Director, Division of Design Design & Construction

Updated 05/24/2018 Printed 06/27/2024

	ABBREVIATIONS
A A/C	AIR CONDITIONING
A/C AB	ANCHOR BOLT
ACC	ACCESIBLE
ACS PNL	ACCESS PANEL ADDENDUM
ADJ	ADJUSTABLE
AFF	ABOVE FINISH FLOOR
AHR ALT	ANCHOR(AGE) ALTERNATE
ALUM	ALUMINUM
ann Pnl	ANNUNCIATOR PANEL
ANOD APC	ANODIZED ACOUSTICAL PANEL CEILING
APC APPROX	APPROXIMATE
ARCH	ARCHITECT(URAL)
ASB ASPH	ASBESTOS
ASPR ATC	ASPHALT ACOUSTICAL TILE CEILING
B BD	BOARD
BEV	BEVELED
BLDG	BUILDING
BLKG BLKT	BLOCKING BLANKET
BLK I BM	BLANKE I BEAM, BENCHMARK
BOT OF	BOTTOM OF
BRG	BEARING
BSMT BUR	BASEMENT BUILT-UP ROOF
C	
CAB CEM	CABINET CEMENT
CEM CH BD	CHALKBOARD
CIP	CAST-IN-PLACE
CJ CLG	CONTROL JOINT CEILING
CLL	CONTRACT LIMIT LINE
CLO	CLOSET
	CLEAR CORRUGATED METAL PIPE
CMP CMPST	COMPOSITE
CMT	CERAMIC MOSAIC TILE
CMU	CONCRETE MASONRY UNIT
CNTR COL	COUNTER COLUMN
COMB	COMBINATION
CONC	CONCRETE
CONSTR CONT	CONSTRUCTION CONTINUOUS
CONTR	CONTRACTOR
COORD	COORDINATE
CORR CPRS FL	CORRIDOR COMPRESSIBLE FILLER
CPT	CARPET
CR	CARD READER
CRS CT	COLD ROLLED STEEL
01	
D	1
D DET	DEPTH DETAIL
DF	DRINKING FOUNTAIN
DFLCT	DEFLECTION
DH	DOUBLE HUNG
DIA DIAG	DIAMETER DIAGONAL
DIM	DIMENSION
DL	DEAD LOAD DAMPPROOFING
	DOOR
DR	DOWNSPOUT
DR DS	DOWNSPOUT DRAWING / DRAWINGS
DR DS DWG / DWGS	
DR DS DWG / DWGS E EA	DRAWING / DRAWINGS
DR DS DWG / DWGS E EA	DRAWING / DRAWINGS EACH EXTERIOR INSULATION AND
DR DS DWG / DWGS E EA EIFS	DRAWING / DRAWINGS
DR DS DWG / DWGS E EA EIFS EJ EL	DRAWING / DRAWINGS EACH EXTERIOR INSULATION AND FINISH SYSTEM EXPANSION JOINT ELEVATION
DR DS DWG / DWGS E EA EIFS EJ EL ELEC	DRAWING / DRAWINGS EACH EXTERIOR INSULATION AND FINISH SYSTEM EXPANSION JOINT ELEVATION ELECTRIC(AL)
DR DS DWG / DWGS E EA EIFS EJ EL ELEC ELEV	DRAWING / DRAWINGS EACH EXTERIOR INSULATION AND FINISH SYSTEM EXPANSION JOINT ELEVATION ELECTRIC(AL) ELEVATOR
DR DS DWG / DWGS E EA EIFS EJ EL ELEC ELEC ELEV EMHO	DRAWING / DRAWINGS         EACH         EXTERIOR INSULATION AND         FINISH SYSTEM         EXPANSION JOINT         ELEVATION         ELECTRIC(AL)         ELECTROMAGNETIC HOLD         OPEN
DR DS DWG / DWGS E EA EIFS EJ EL ELEC ELEC ELEV EMHO ENTR	DRAWING / DRAWINGS         EACH         EXTERIOR INSULATION AND         FINISH SYSTEM         EXPANSION JOINT         ELEVATION         ELECTRIC(AL)         ELECTROMAGNETIC HOLD         OPEN         ENTRANCE
DR DS DWG / DWGS E EA EIFS EJ EL ELEC ELEV EMHO ENTR EP	DRAWING / DRAWINGS         EACH         EXTERIOR INSULATION AND         FINISH SYSTEM         EXPANSION JOINT         ELEVATION         ELECTRIC(AL)         ELECTROMAGNETIC HOLD         OPEN         ENTRANCE         ELECTRIC PANEL
DR DS DWG / DWGS E EA EIFS EJ EL ELEC ELEC ELEV EMHO ENTR EP EQ	DRAWING / DRAWINGS         EACH         EXTERIOR INSULATION AND         FINISH SYSTEM         EXPANSION JOINT         ELEVATION         ELECTRIC(AL)         ELECTROMAGNETIC HOLD         OPEN         ENTRANCE
DR DR DS DWG / DWGS E EA EIFS EL ELEC ELEC ELEV EMHO ENTR EP EQ EQUIP EST	DRAWING / DRAWINGS         EACH         EXTERIOR INSULATION AND         FINISH SYSTEM         EXPANSION JOINT         ELEVATION         ELECTRIC(AL)         ELECTROMAGNETIC HOLD         OPEN         ENTRANCE         ELECTRIC PANEL         EQUAL         EQUIPMENT         ESTIMATE
DR DR DS DWG / DWGS E EA EIFS EL ELEC ELEV EMHO ENTR EP EQ EQ EQUIP EST EWC	DRAWING / DRAWINGS         EACH         EXTERIOR INSULATION AND         FINISH SYSTEM         EXPANSION JOINT         ELEVATION         ELECTRIC(AL)         ELECTRIC(AL)         ELECTROMAGNETIC HOLD         OPEN         ENTRANCE         ELECTRIC PANEL         EQUAL         EQUIPMENT         ESTIMATE         ELECTRIC WATER COOLER
DR DR DS DWG / DWGS E EA EIFS EL ELEC ELEC ELEV EMHO ENTR EP EQ EQUIP EST EWC EXH	DRAWING / DRAWINGS         EACH         EXTERIOR INSULATION AND         FINISH SYSTEM         EXPANSION JOINT         ELEVATION         ELECTRIC(AL)         ELECTROMAGNETIC HOLD         OPEN         ENTRANCE         ELECTRIC PANEL         EQUAL         EQUIPMENT         ESTIMATE
DR DR DS DWG / DWGS E EA EIFS EL ELEC ELEC ELEV EMHO ENTR EP EQ EQUIP EST EQUIP EST EWC EXH EXIST EXP	DRAWING / DRAWINGS         EACH         EXTERIOR INSULATION AND         FINISH SYSTEM         EXPANSION JOINT         ELEVATION         ELECTRIC(AL)         ELECTROMAGNETIC HOLD         OPEN         ENTRANCE         ELECTRIC PANEL         EQUIPMENT         ESTIMATE         ELECTRIC WATER COOLER         EXHAUST         EXISTING         EXPOSED, EXPANSION
DR DR DS DWG / DWGS E EA EIFS EL ELEC ELEC ELEV EMHO ENTR EP EQ EQUIP EST EQUIP EST EWC EXH EXIST EXP	DRAWING / DRAWINGS         EACH         EXTERIOR INSULATION AND         FINISH SYSTEM         EXPANSION JOINT         ELEVATION         ELECTRIC(AL)         ELECTRIC(AL)         ELECTRIC PANEL         EQUAL         EQUIPMENT         ESTIMATE         ELECTRIC WATER COOLER         EXHAUST         EXISTING
DR DR DS DWG / DWGS E EA EIFS EL ELEC ELEC ELEV EMHO ENTR EP EQ EQUIP EST EWC EXH EXST EXP EXT	DRAWING / DRAWINGS         EACH         EXTERIOR INSULATION AND         FINISH SYSTEM         EXPANSION JOINT         ELEVATION         ELECTRIC(AL)         ELECTROMAGNETIC HOLD         OPEN         ENTRANCE         ELECTRIC PANEL         EQUIPMENT         ESTIMATE         ELECTRIC WATER COOLER         EXHAUST         EXISTING         EXPOSED, EXPANSION
DR DR DS DWG / DWGS E EA EIFS EL ELEC ELEC ELEV EMHO ENTR EQ EQUIP EST EQ EQUIP EST EWC EXH EXST EXP EXT F	DRAWING / DRAWINGS         EACH         EXTERIOR INSULATION AND         FINISH SYSTEM         EXPANSION JOINT         ELEVATION         ELECTRIC(AL)         ELECTROMAGNETIC HOLD         OPEN         ENTRANCE         ELECTRIC PANEL         EQUAL         EQUIPMENT         ESTIMATE         ELECTRIC WATER COOLER         EXHAUST         EXISTING         EXTERIOR
DR DR DS DWG / DWGS E EA EIFS EIFS EL ELEC ELEV EMHO ENTR EP EQ EQUIP EST EQUIP EST EWC EXH EXIST EXH EXIST EXP EXT F AAP	DRAWING / DRAWINGS         EACH         EXTERIOR INSULATION AND         FINISH SYSTEM         EXPANSION JOINT         ELEVATION         ELECTRIC(AL)         ELECTROMAGNETIC HOLD         OPEN         ENTRANCE         ELECTRIC PANEL         EQUAL         EQUIPMENT         ESTIMATE         ELECTRIC WATER COOLER         EXHAUST         EXISTING         EXTERIOR
DR DR DS DWG / DWGS E EA EIFS EIFS EL ELEC ELEC ELEV EMHO ENTR EP EQ EQUIP EST EQ EQUIP EST EWC EXH EXT EXP EXT F AAP FCU	DRAWING / DRAWINGS         EACH         EXTERIOR INSULATION AND         FINISH SYSTEM         EXPANSION JOINT         ELEVATION         ELECTRIC(AL)         ELECTROMAGNETIC HOLD         OPEN         ENTRANCE         ELECTRIC PANEL         EQUAL         EQUIPMENT         ESTIMATE         ELECTRIC WATER COOLER         EXHAUST         EXISTING         EXTERIOR
DR DR DS DWG / DWGS E EA EIFS EIFS EL ELEC ELEC ELEV EMHO ENTR EP EQ EQUIP EST EQ EQUIP EST EWC EXH EXT EXH EXIST EXT EXT F F FAAP FCU FD FDTN	DRAWING / DRAWINGS         EACH         EXTERIOR INSULATION AND         FINISH SYSTEM         EXPANSION JOINT         ELEVATION         ELECTRIC(AL)         ELECTRIC(AL)         ELECTRIC PANEL         EQUAL         EQUIPMENT         ESTIMATE         ELECTRIC WATER COOLER         EXHAUST         EXISTING         EXTERIOR         FIRE ALARM ANNUNCIATOR         PANEL         FLOOR DRAIN         FOUNDATION
DR DR DS DWG / DWGS E EA EIFS EIFS EL ELEC ELEV EMHO ENTR EP EQ EQUIP EQUIP EST EQUIP EST EWC EXH EXIST EXT EXP EXT F FAAP FCU FD FD FD FD FE	DRAWING / DRAWINGS         EACH         EXTERIOR INSULATION AND         FINISH SYSTEM         EXPANSION JOINT         ELEVATION         ELECTRIC(AL)         ELECTRIC(AL)         ELECTRIC PANEL         EQUAL         EQUIPMENT         EXISTING         EXTERIOR         EXISTING         EXTERIOR         FIRE ALARM ANNUNCIATOR         PANEL         FLOOR DRAIN         FOUNDATION         FIRE EXTINGUISHER
DR DR DS DWG / DWGS E EA EIFS EL ELEC ELEC ELEV EMHO ENTR EP EQ EQUIP EST EWC EST EWC EXH EXIST EXF EXT FAAP FCU FD FD FD FD FE FE EC	DRAWING / DRAWINGS         EACH         EXTERIOR INSULATION AND         FINISH SYSTEM         EXPANSION JOINT         ELEVATION         ELECTRIC(AL)         ELECTRIC(AL)         ELECTRIC PANEL         EQUAL         EQUIPMENT         ESTIMATE         ELECTRIC WATER COOLER         EXHAUST         EXISTING         EXTERIOR         FIRE ALARM ANNUNCIATOR         PANEL         FAN COIL UNIT         FLOOR DRAIN         FOUNDATION         FIRE EXTINGUISHER         FIRE EXTINGUISHER CABINET
DMPF DR DR DS DWG / DWGS E EA EA EIFS EJ ELEC ELEC ELEV EMHO ENTR EP EQ EQUIP EST EWC EXH EXIST EXP EXT FAAP FCU FD FD FD FCU FD FE FC FH FIN	DRAWING / DRAWINGS         EACH         EXTERIOR INSULATION AND         FINISH SYSTEM         EXPANSION JOINT         ELEVATION         ELECTRIC(AL)         ELECTRIC(AL)         ELECTRIC PANEL         EQUAL         EQUIPMENT         ELECTRIC WATER COOLER         EXHAUST         EXISTING         EXTERIOR         FIRE ALARM ANNUNCIATOR         PANEL         FLOOR DRAIN         FOUNDATION         FIRE EXTINGUISHER


	1
	ABBREVIATIONS
.G .R	FLOORING FLOOR
лх Л	FACTORY MUTUAL
) )F	FACE OF FACE OF FINISH
DS	FACE OF STUD
> {	FIREPROOFING FRAME
RMG	FRAMING
<b>Υ</b> Ρ	FIBERGLASS REINFORCED PLASTIC/PANEL
RTW	FIRE RETARDANT TREATED WOOD
-	FOOT/FEET
G	FOOTING
JRG JRN	FURRING FURNISHED/FURNITURE
VC	FABRIC WALL COVERING
A	GAUGE
ALV B	GALVANIZED GRAB BAR
)	GENERAL CONTRACTOR
CT	GLAZED CERAMIC TILE GLASS/GLAZING
- VB	GYPSUM WALLBOARD
/P	GYPSUM
)	HOLLOW CORE
P	HANDICAPPED
)BD )W	HARDBOARD HARDWARE
)WD	HARDWOOD
	HOLLOW METAL
IDRL DRIZ	HANDRAIL HORIZONTAL
2	HOUR
- /AC	HEIGHT HEATING/VENTILATING/AIR
	CONDITIONING
CL	INSIDE DIAMETER INCLUDE(D)(-ING)
SUL	INSULATE(D)(-ION)(-ING)
T V	INTERIOR INVERT
•	
N	JANITOR
	JOINT
M	LAMINATE(D)
V	LAVATORY LINEAR FEET
	LIVE LOAD
H	LONG LEG HORIZONTAL
V GA	LONG LEG VERTICAL LIGHT GAUGE
G	LIGHTING
′R	LOUVER
ACH ATL	MACHINE MATERIAL
٩Χ	MAXIMUM
ECH	
EMB EZZ	MEMBRANE MEZZANINE
FR	MANUFACTURER
N SC	MINIMUM MISCELLANEOUS
KR BD	MARKER BOARD
_DG	
<u>२</u> २	MASONRY OPENING MOISTURE RESISTANT
٢L	METAL
JLL	MULLION
A	NOT APPLICABLE
T	NATURAL
C )	NOT IN CONTRACT NUMBER
) DM	NOMINAL
rs	NOMINAL PIPE SIZE
S	NOT TO SCALE
4	
)	ON CENTER OUTSIDE DIAMETER
РН	OPPOSITE HAND
PNG PP	OPENING OPPOSITE
	1
BD	PARTICLE BOARD
Т	PORCELAIN CERAMIC TILE
RIM	PERIMETER
-	PROPERTY LINE PLASTIC LAMINATE
AM AS	PLASTIC LAMINATE PLASTER
AM AS BG YWD	PLASTIC LAMINATE


	ABBREVIATIONS
PNT PNTD	PAINT PAINTED
PR	PAIR
PREFAB PT	PREFABRICAT(D) PRESSURE TREATED
PTD	PAPER TOWER DISPENSER
PTN PVC	PARTITION POLYVINYL CHLORIDE
	(PLASTIC)
PVG	PAVING
Q QT	QUARRY TILE
QTY	QUANTITY
R	
R RB	RADIUS/RISER RESILIENT BASE
RBR	RUBBER
RCP RD	REFLECTED CEILING PLAN ROOF DRAIN
REF	REFRIDGERATOR
REINF REQ'D	REINFORCE(D) REQUIRED
RESIL	RESILIENT
RESIL C	RESILIENT CHANNEL
REV	REVISION
RM RO	ROOM ROUGH OPENING
S	
SC	SOLID CORE
SCHED SECT	SCHEDULE SECTION
SF	SQUARE FEET
SHT SHTHG	SHEET SHEATHING
SIM	SIMILAR
SLNT SND	SEALANT SANITARY NAPKIN
SNDU	DISPENSER SANITARY NAPKIN DISPOSAL
	UNIT
SPEC SPKLR	SPECIFICATION SPRINKLER
SQ SSM	SQUARE SOLID SURFACE MATERIAL
SST	STAINLESS STEEL
STC	SOUND TRANSMISSION CLASS
STD	STANDARD
STL STL JST	STEEL STEEL JOIST
STL LNTL	STEEL LINTEL
STL PLATE	STEEL PLATE STONE
STRUCT SUSP	STRUCTURAL SUSPENDED
SV	SHEET VINYL
SVT SYMM	SHEET VINYL FLOORING SYMMETRICAL
т	ŀ
T	TREAD
T&G TEL	TONGUE AND GROOVE TELEPHONE
TEMP	TEMPERATURE
TER TERM	TERRAZZO TERMINAL
ТНК	THICKNESS
THRES TK BD	THRESHOLD TACKBOARD
TMPD	TEMPERED
TO TOC	TOP OF TOP OF CONCRETE
TOS	TOP OF STEEL TOP OF WALL
TOW TRANS	TRANSOM, TRANSPARENT
TYP	TYPICAL
U	
UC UL	UNDERCUT UNDERWRITER'S LABATORY
	(TEST) UNLESS NOTED OTHERWISE
UNO UR	URINAL
V	
VCT	VINYL COMPOSITION TILE
VERT VEST	VERTICAL VESTIBULE
VIF	VERIFY IN FIELD
VNR VP	VENEER VENEER PLASTER
VR	VAPOR RETARDER
VT VWC	VINYL TILE VINYL WALLCOVERING
W	
W	WIDE
W/ W/O	WITH WITHOUT
WC	WATER CLOSET
WD WDW	WOOD WINDOW
	WINDOW TREATMENT
WDWT	
WDW1 WGL WP	WIRED GLASS WATERPROOFING
WGL	WIRED GLASS WATERPROOFING WORKPOINT WEATHERSTRIP

# ABBREVIATIONS SCALE: NO SCALE (B1)-

FIXTURE


FLASHING

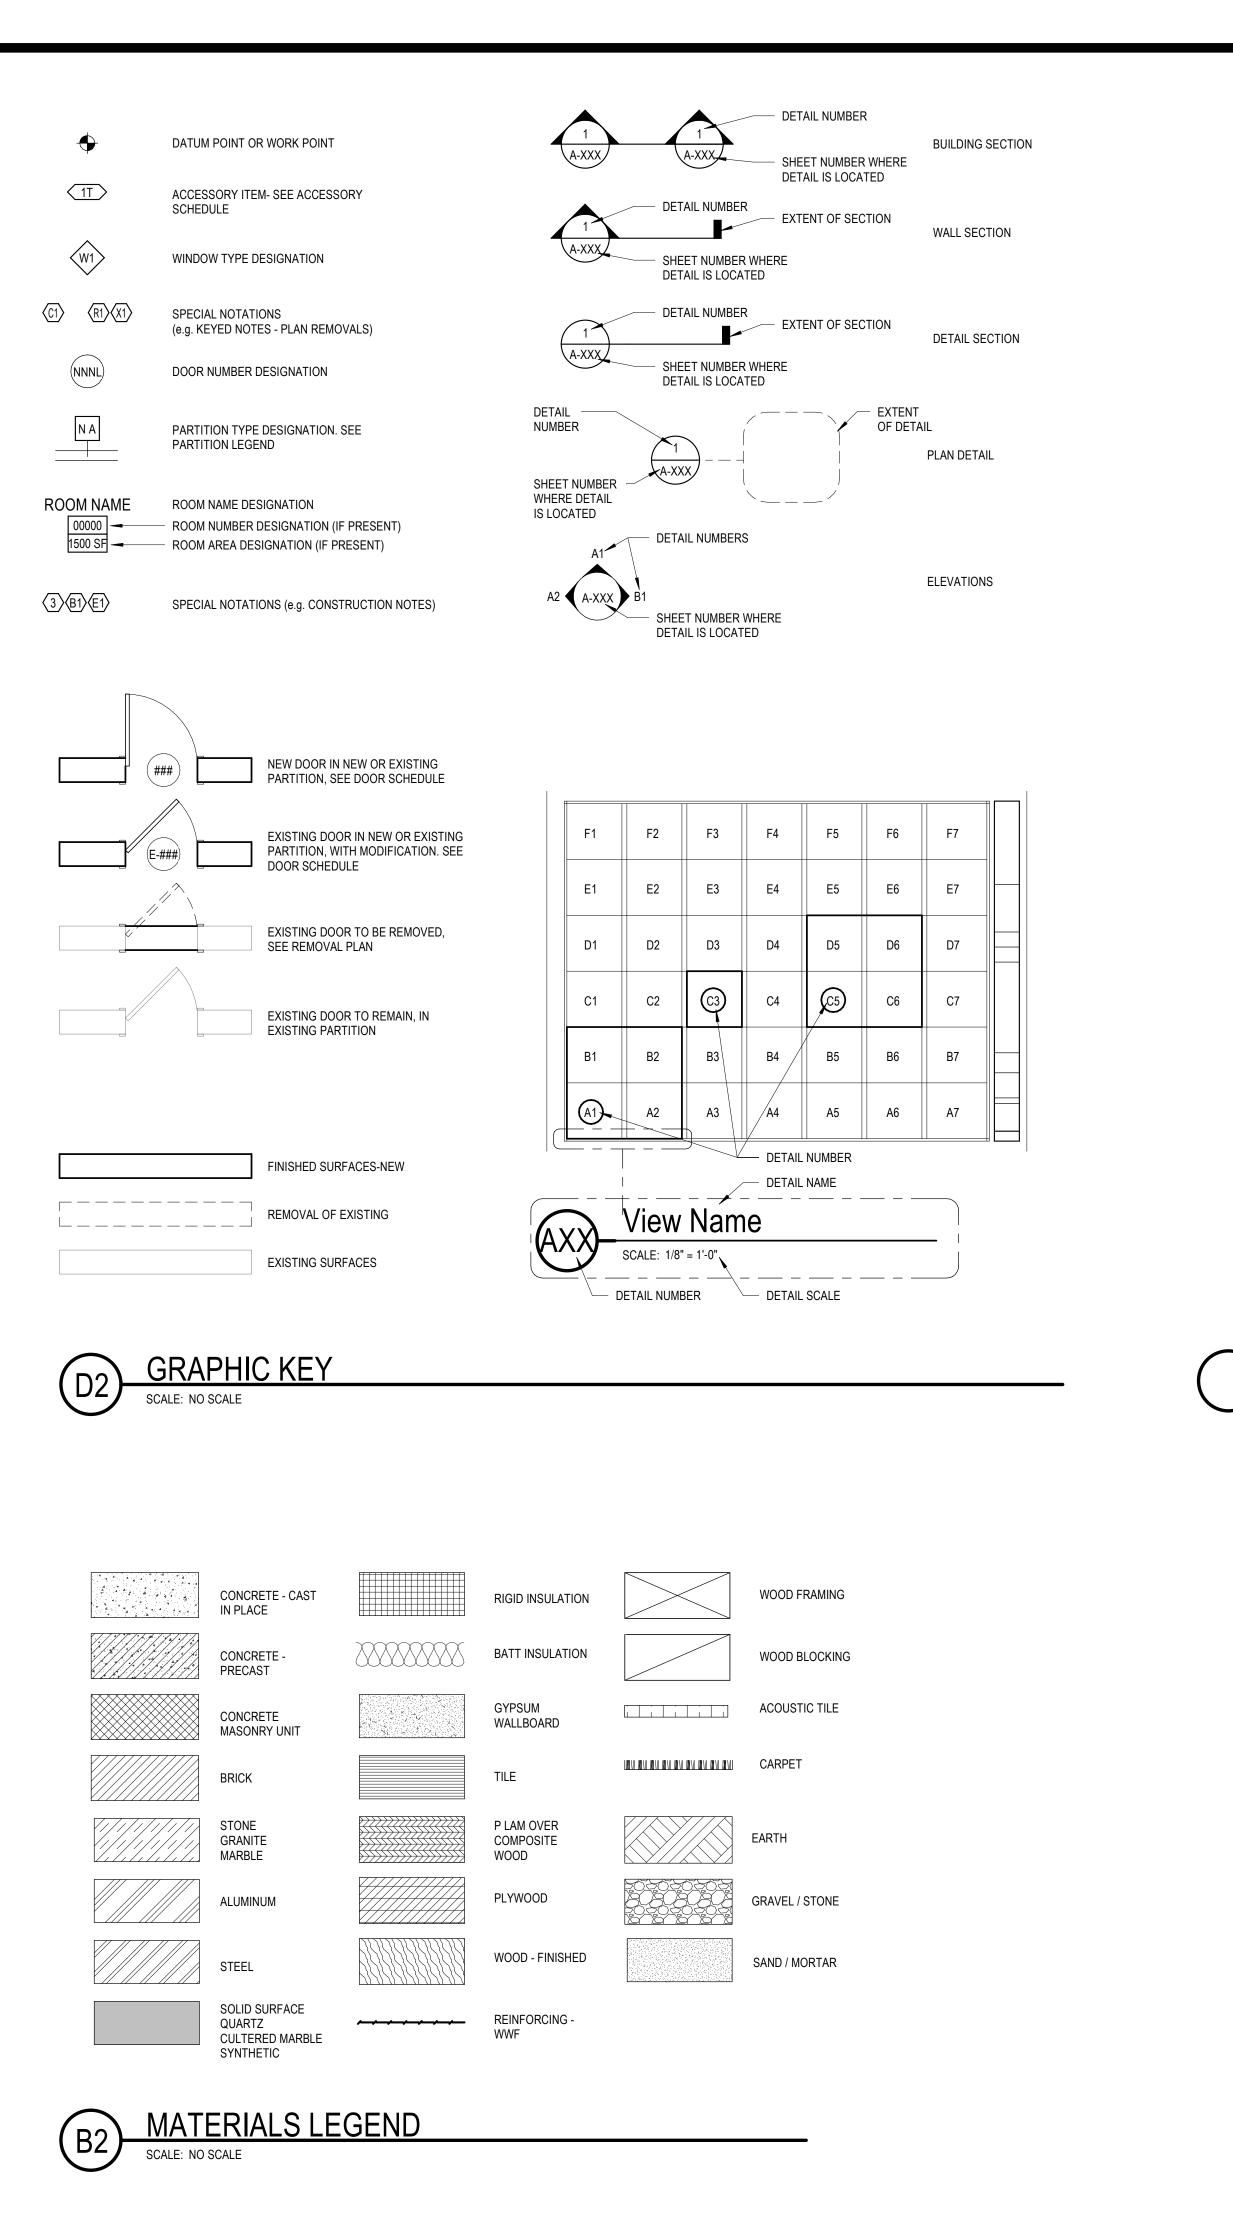

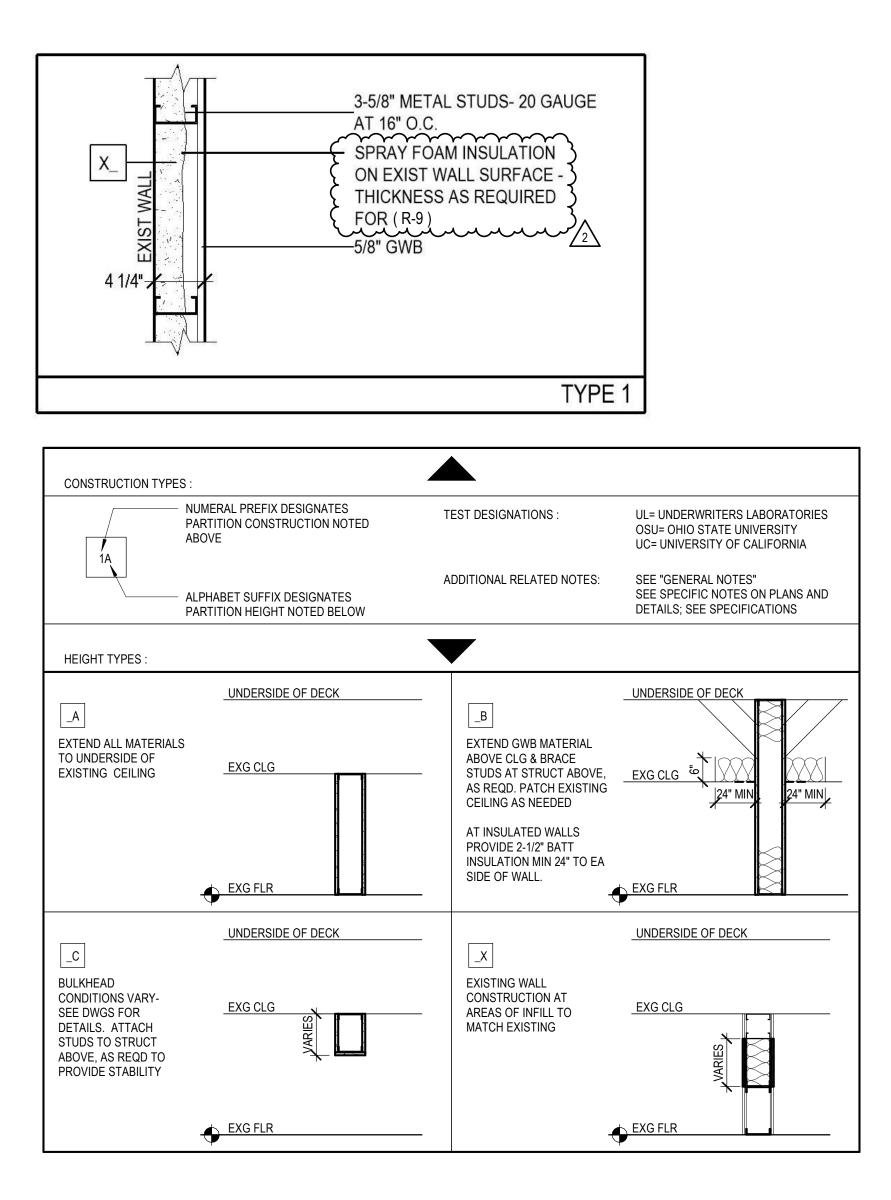



# PARTITION CONSTRUCTION TYPES

SCALE: 1/2" = 1'-0"

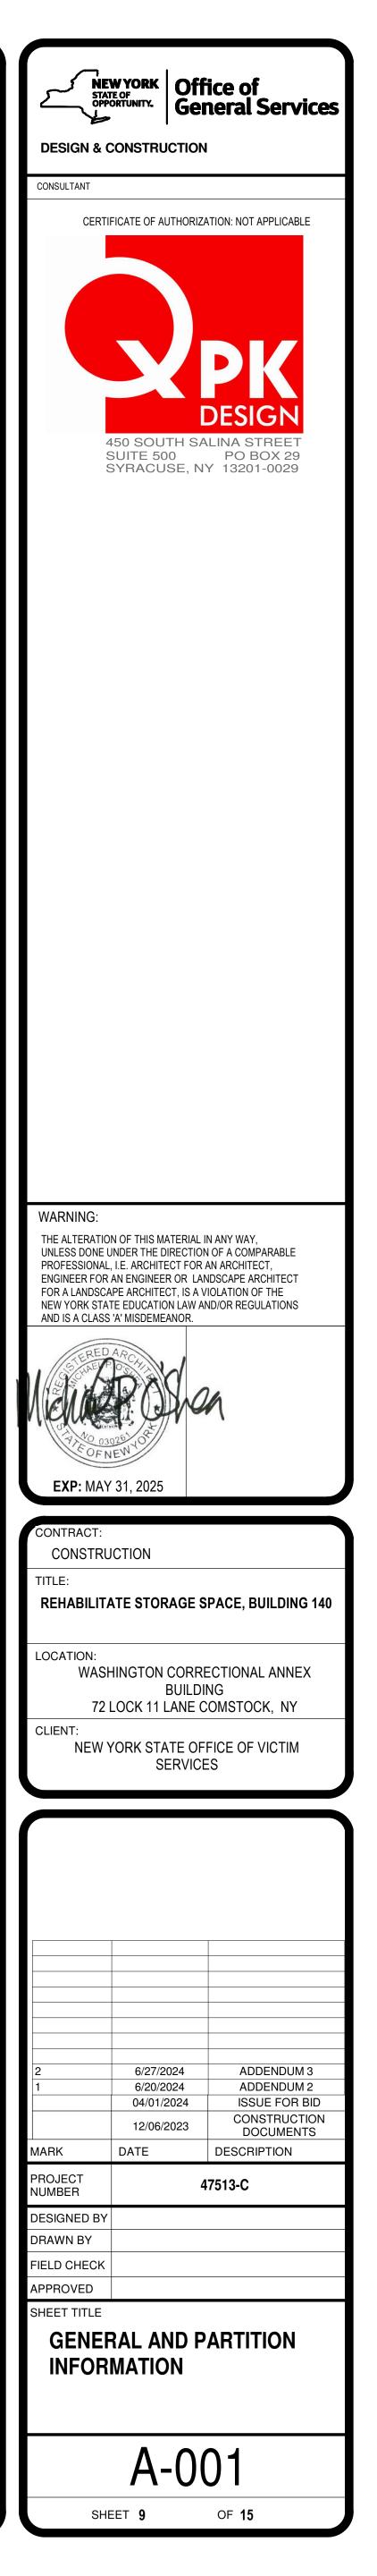





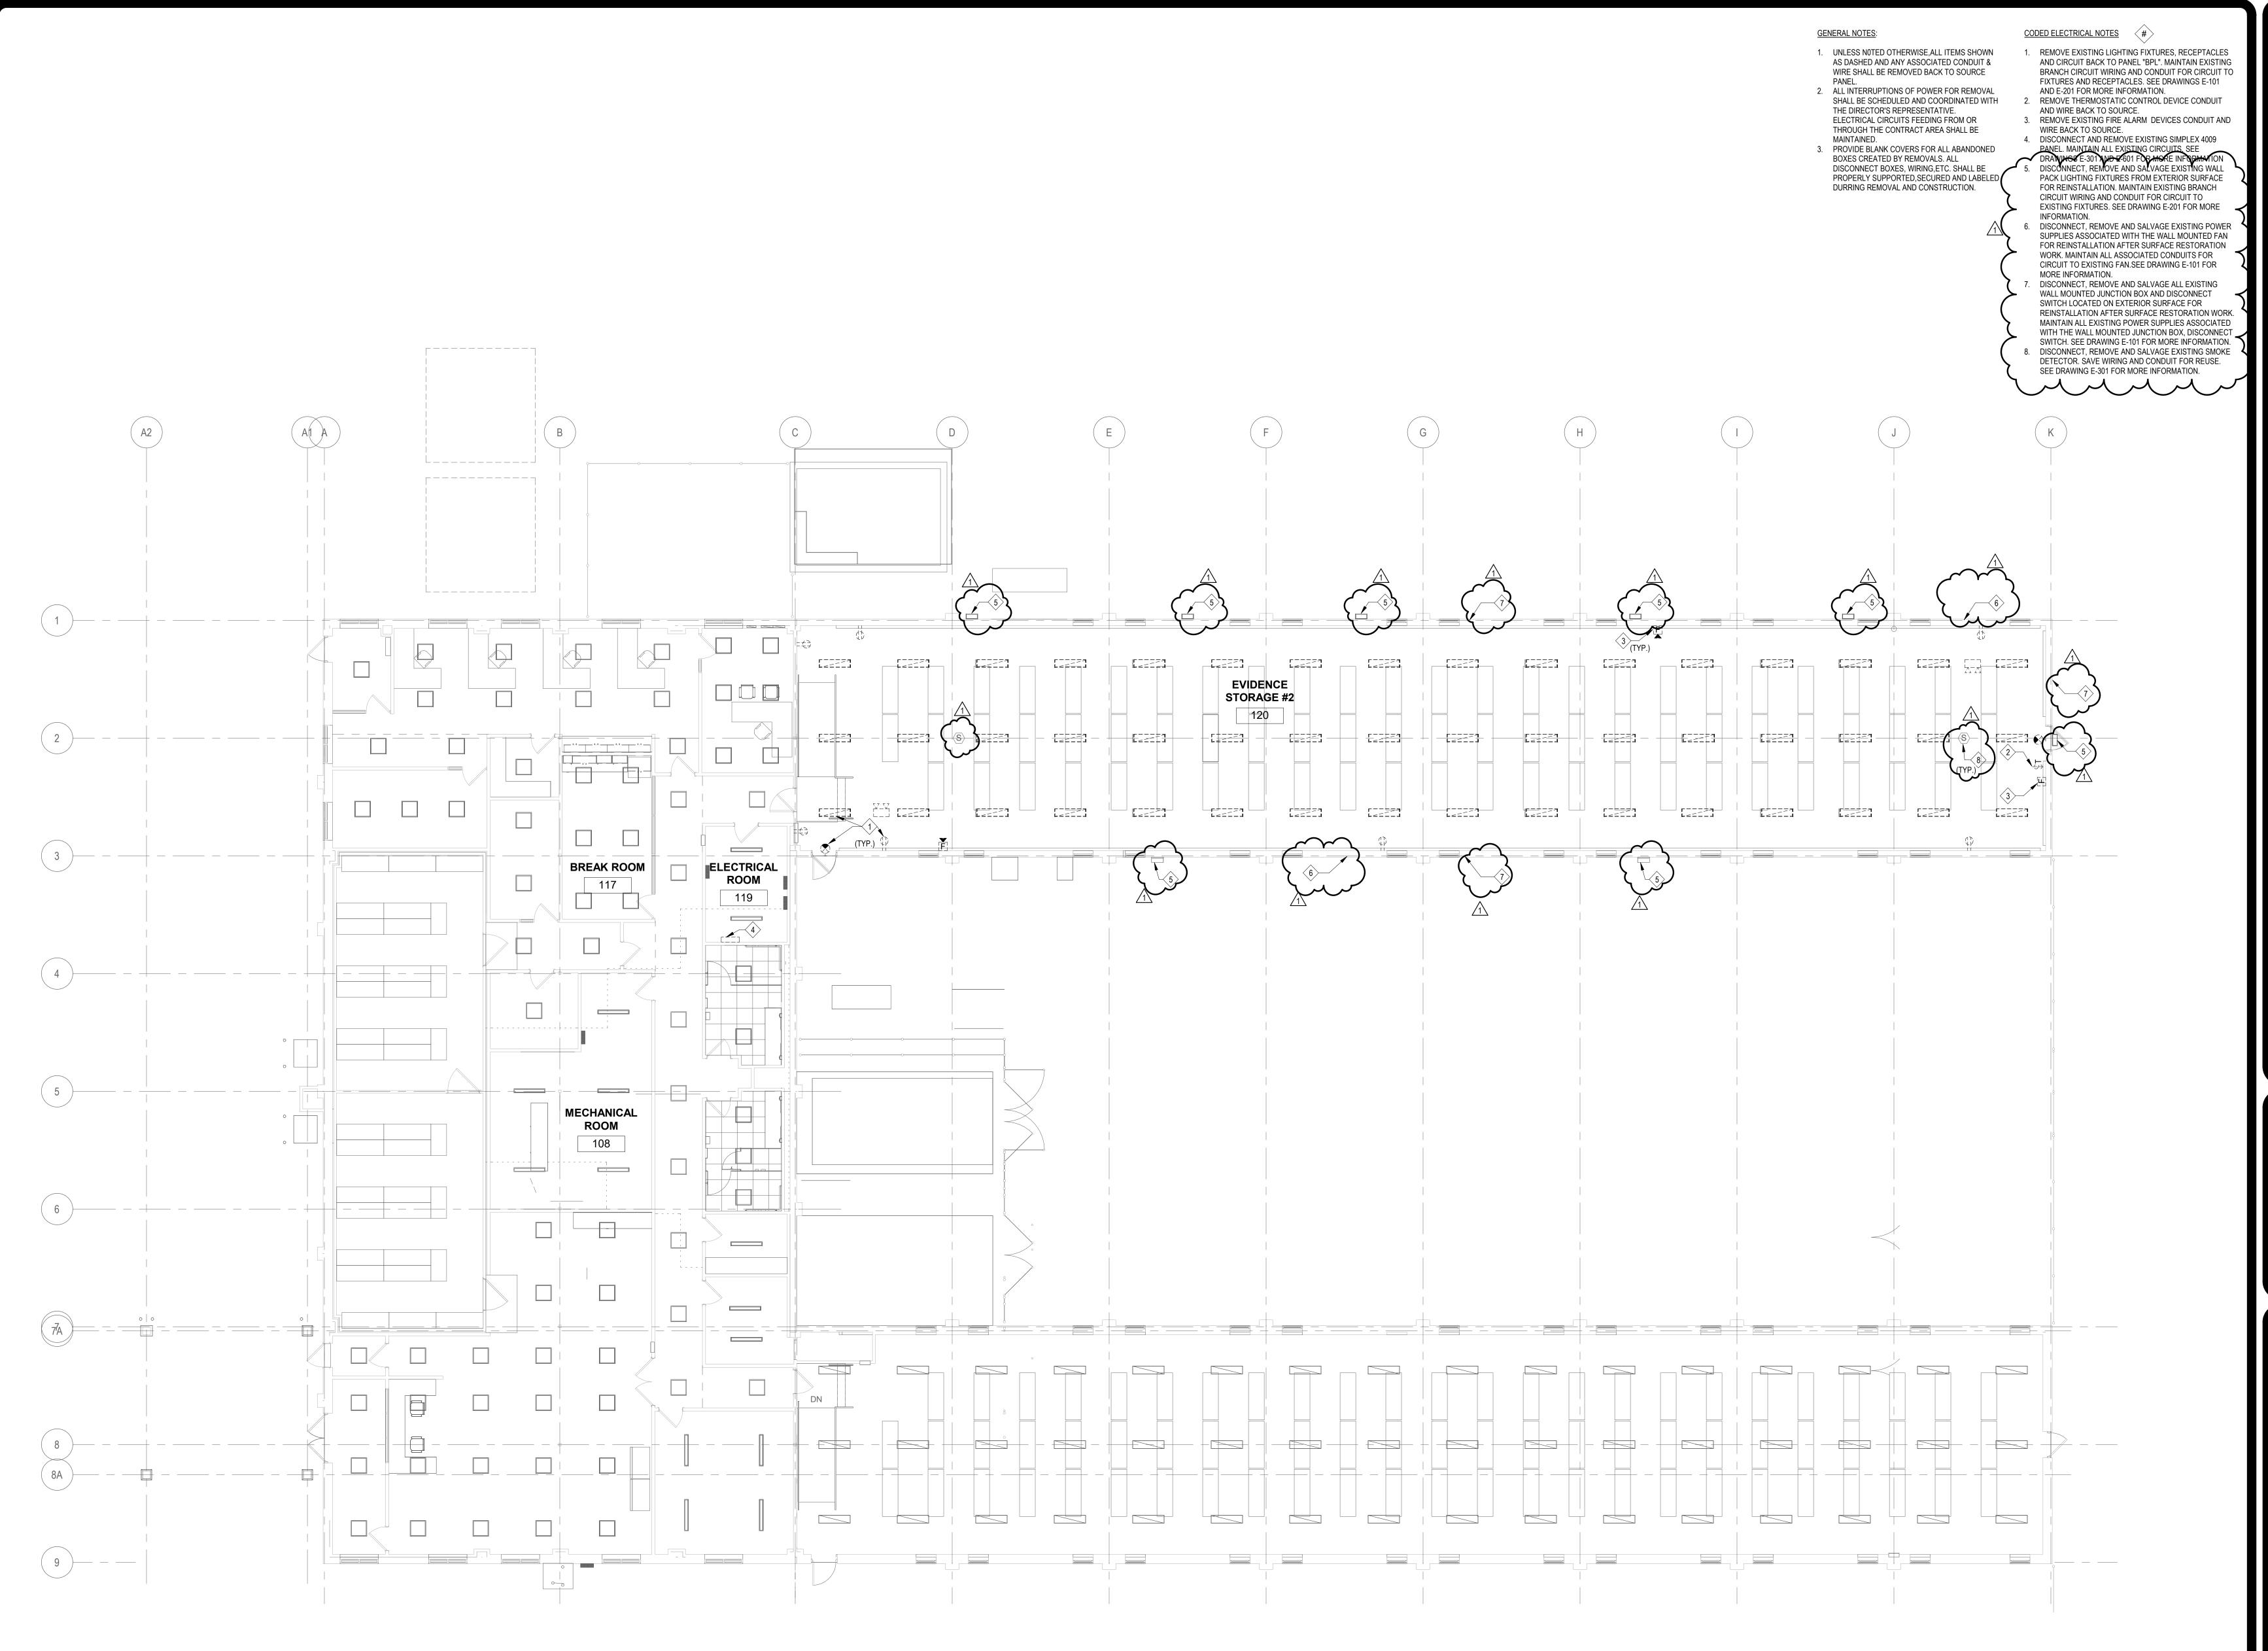

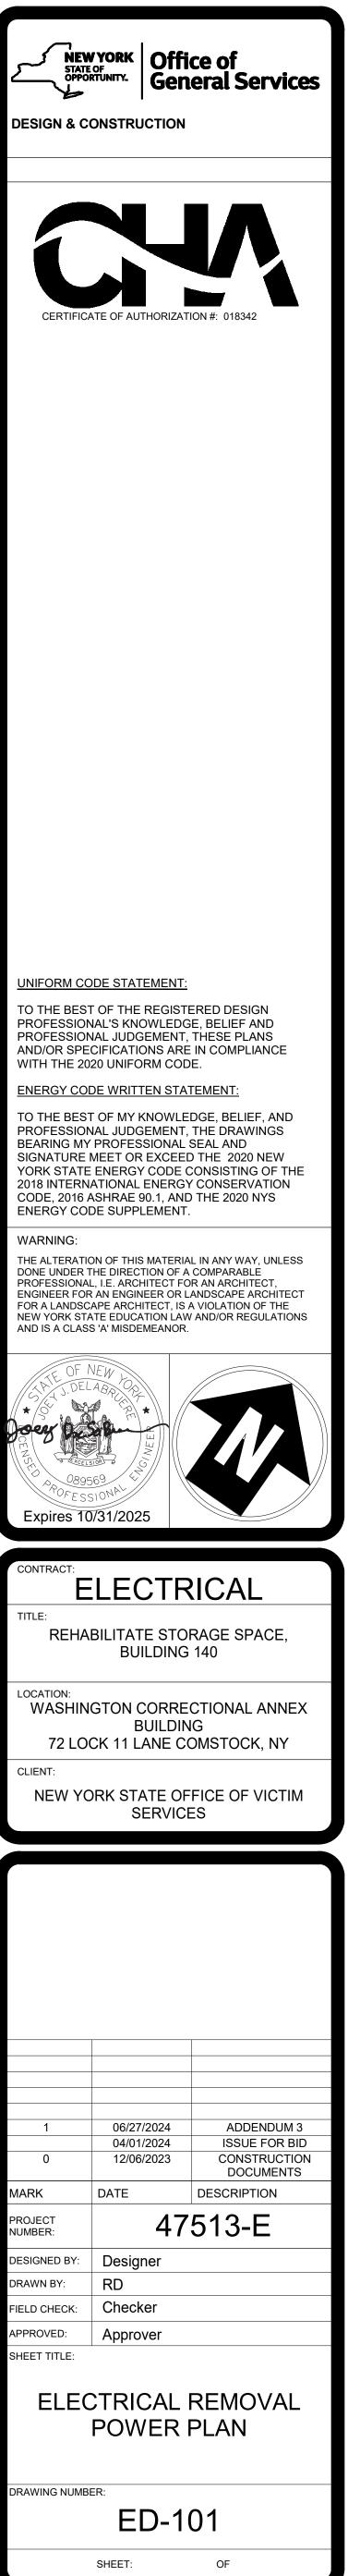



C:\Users\8576\OneDrive - CHA Consulting, Inc\Documents\081408\_ELEC\_R23\_rdesai3A7G2.rvt 6/27/2024 3:14:43 PM

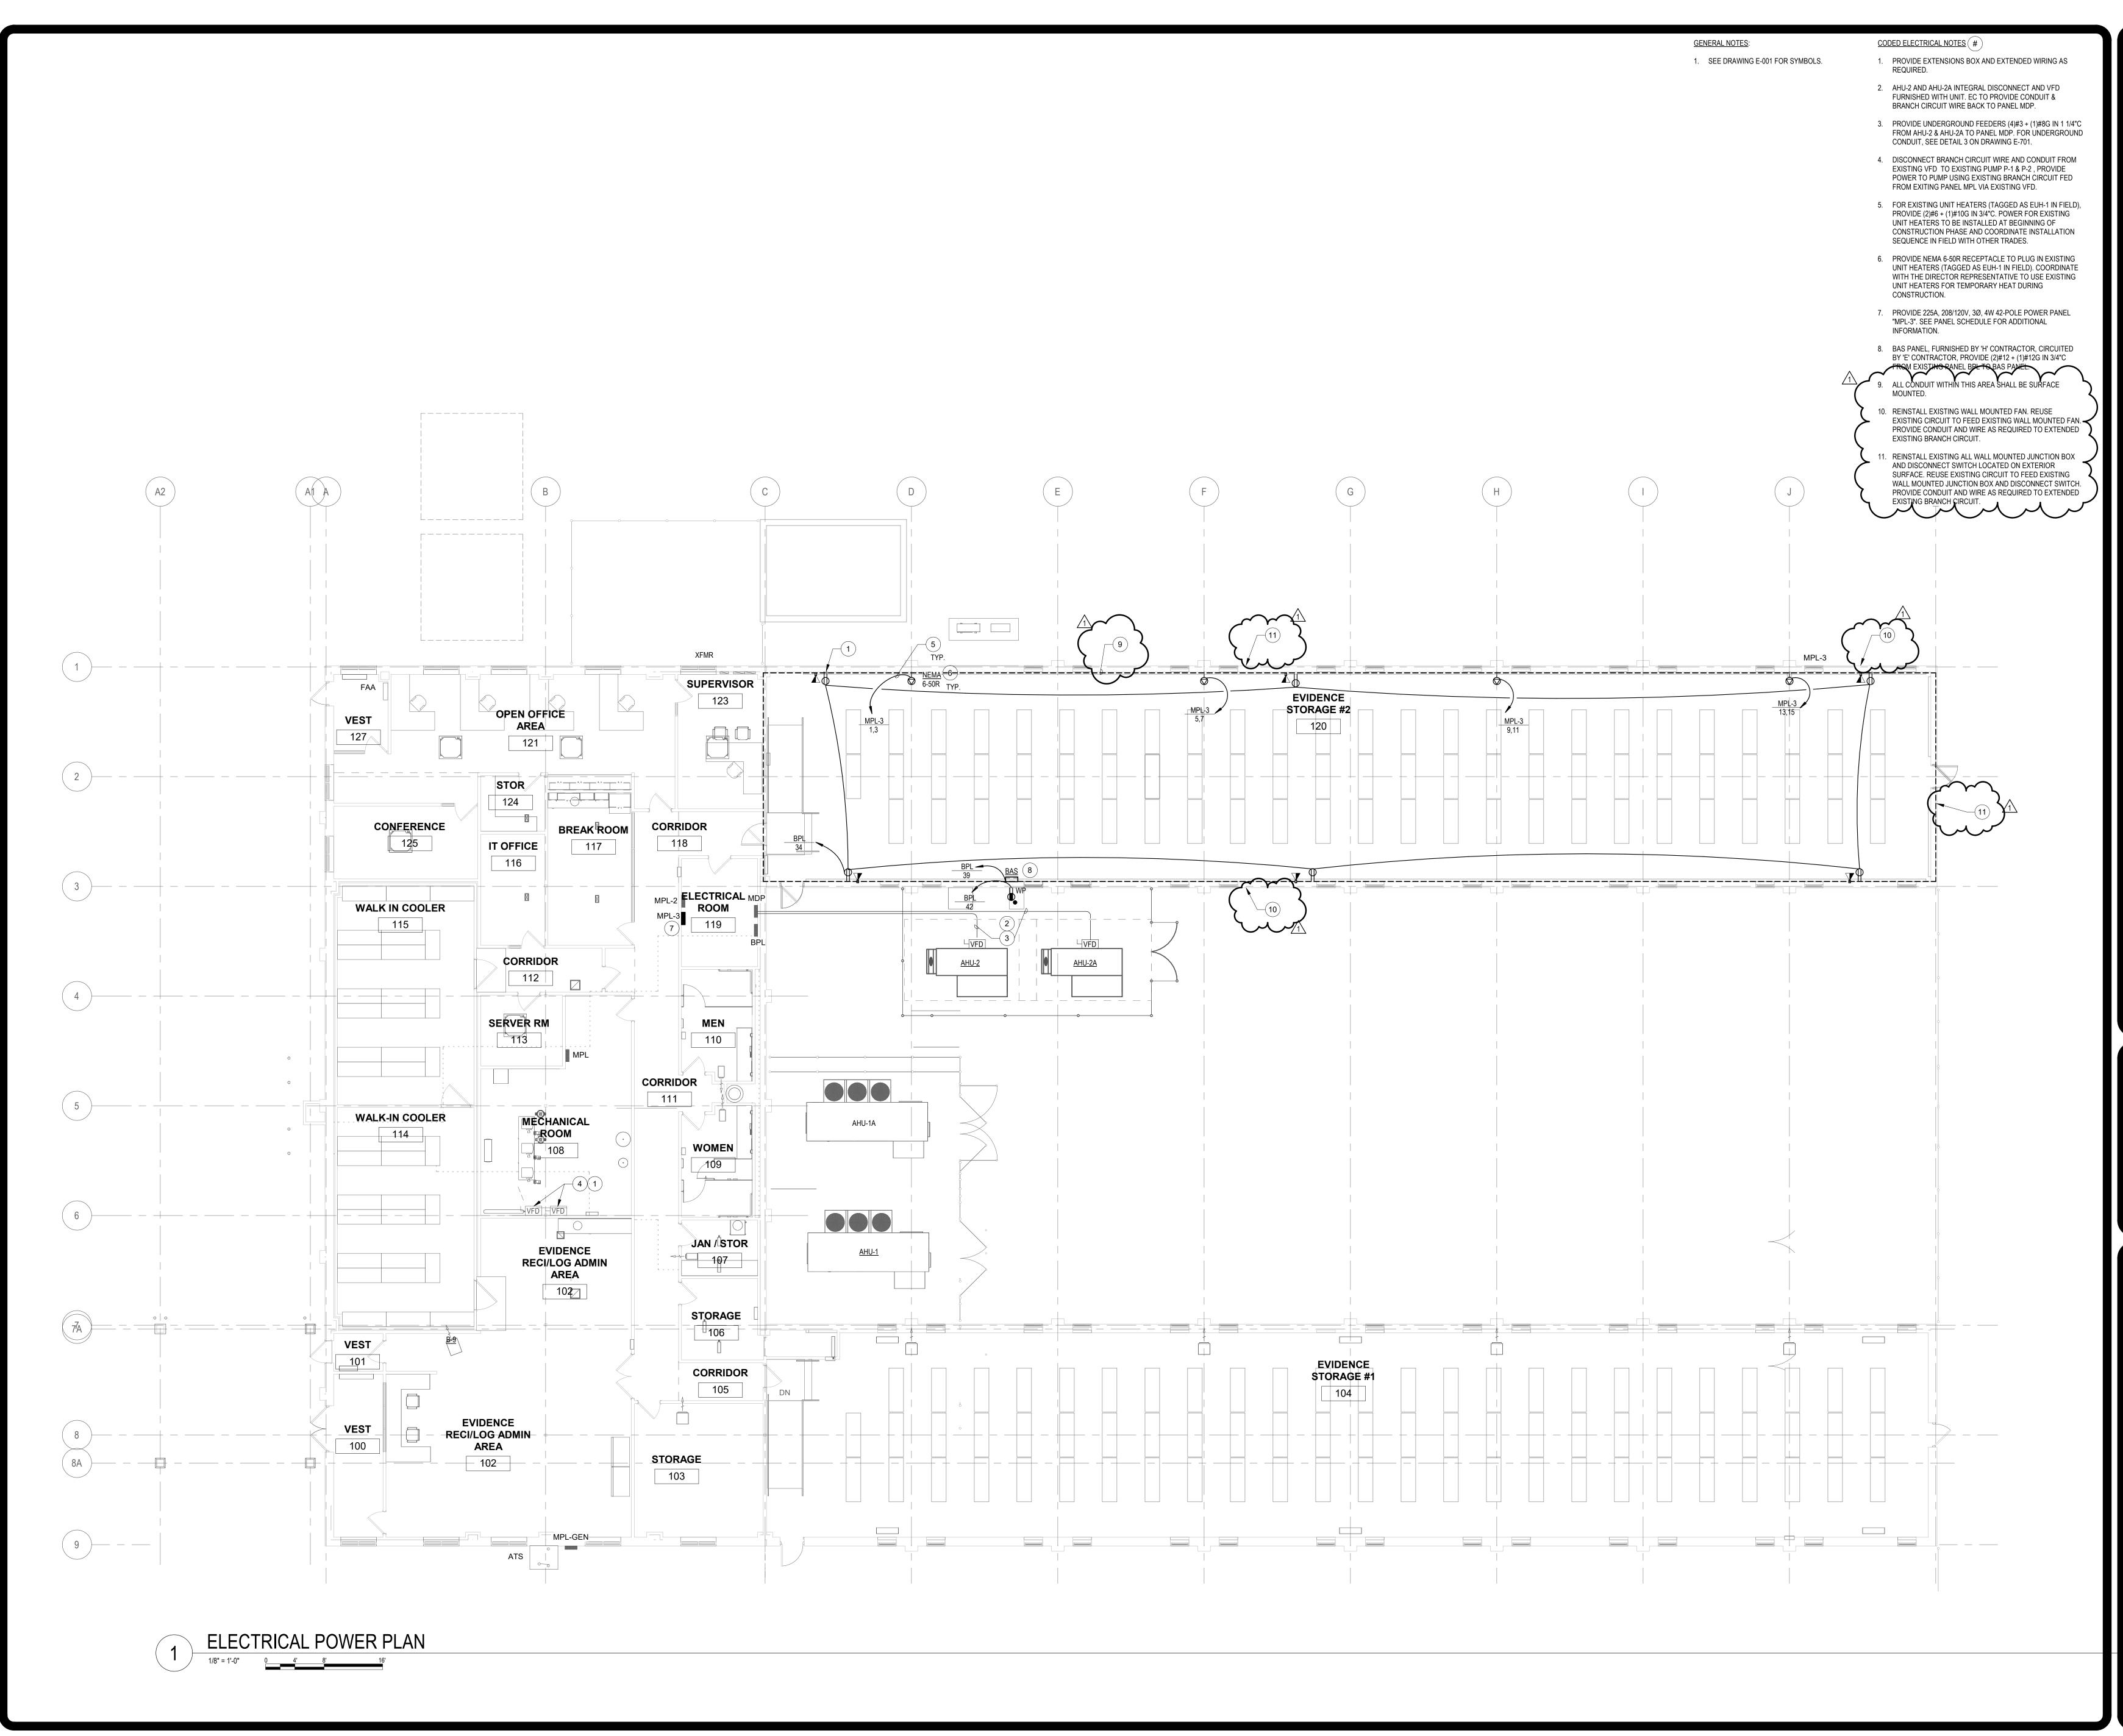


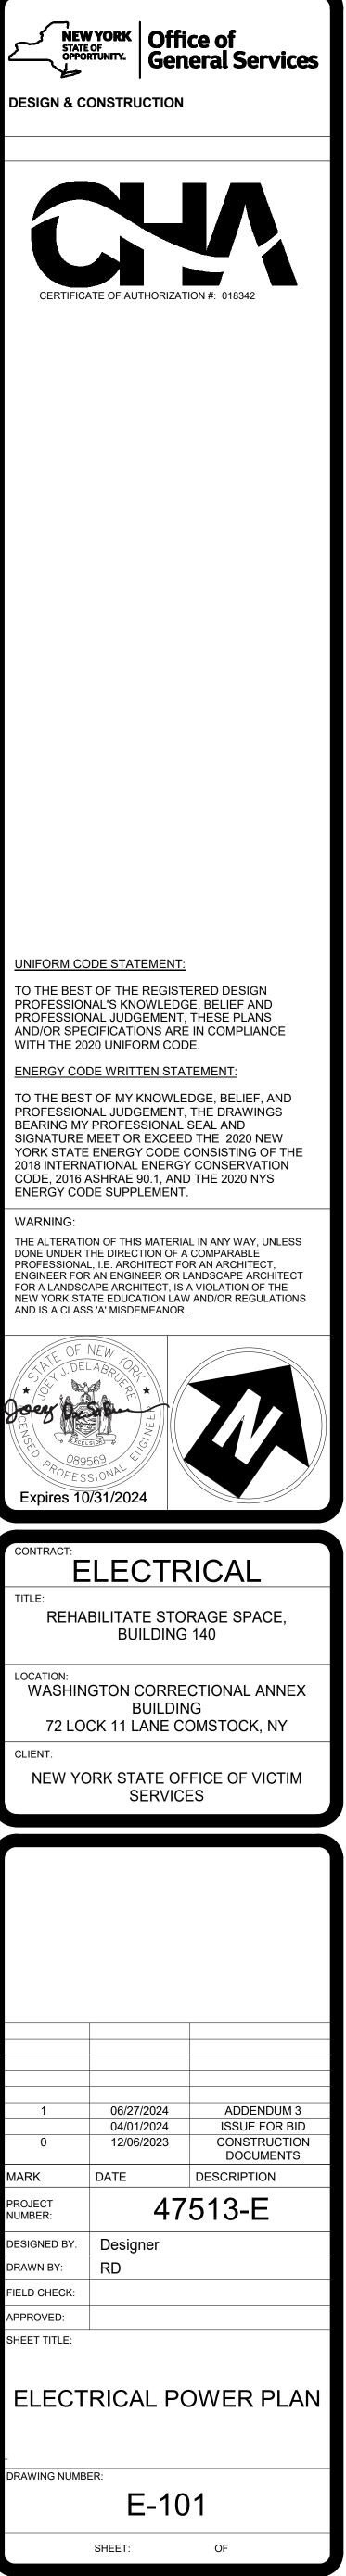

0 2

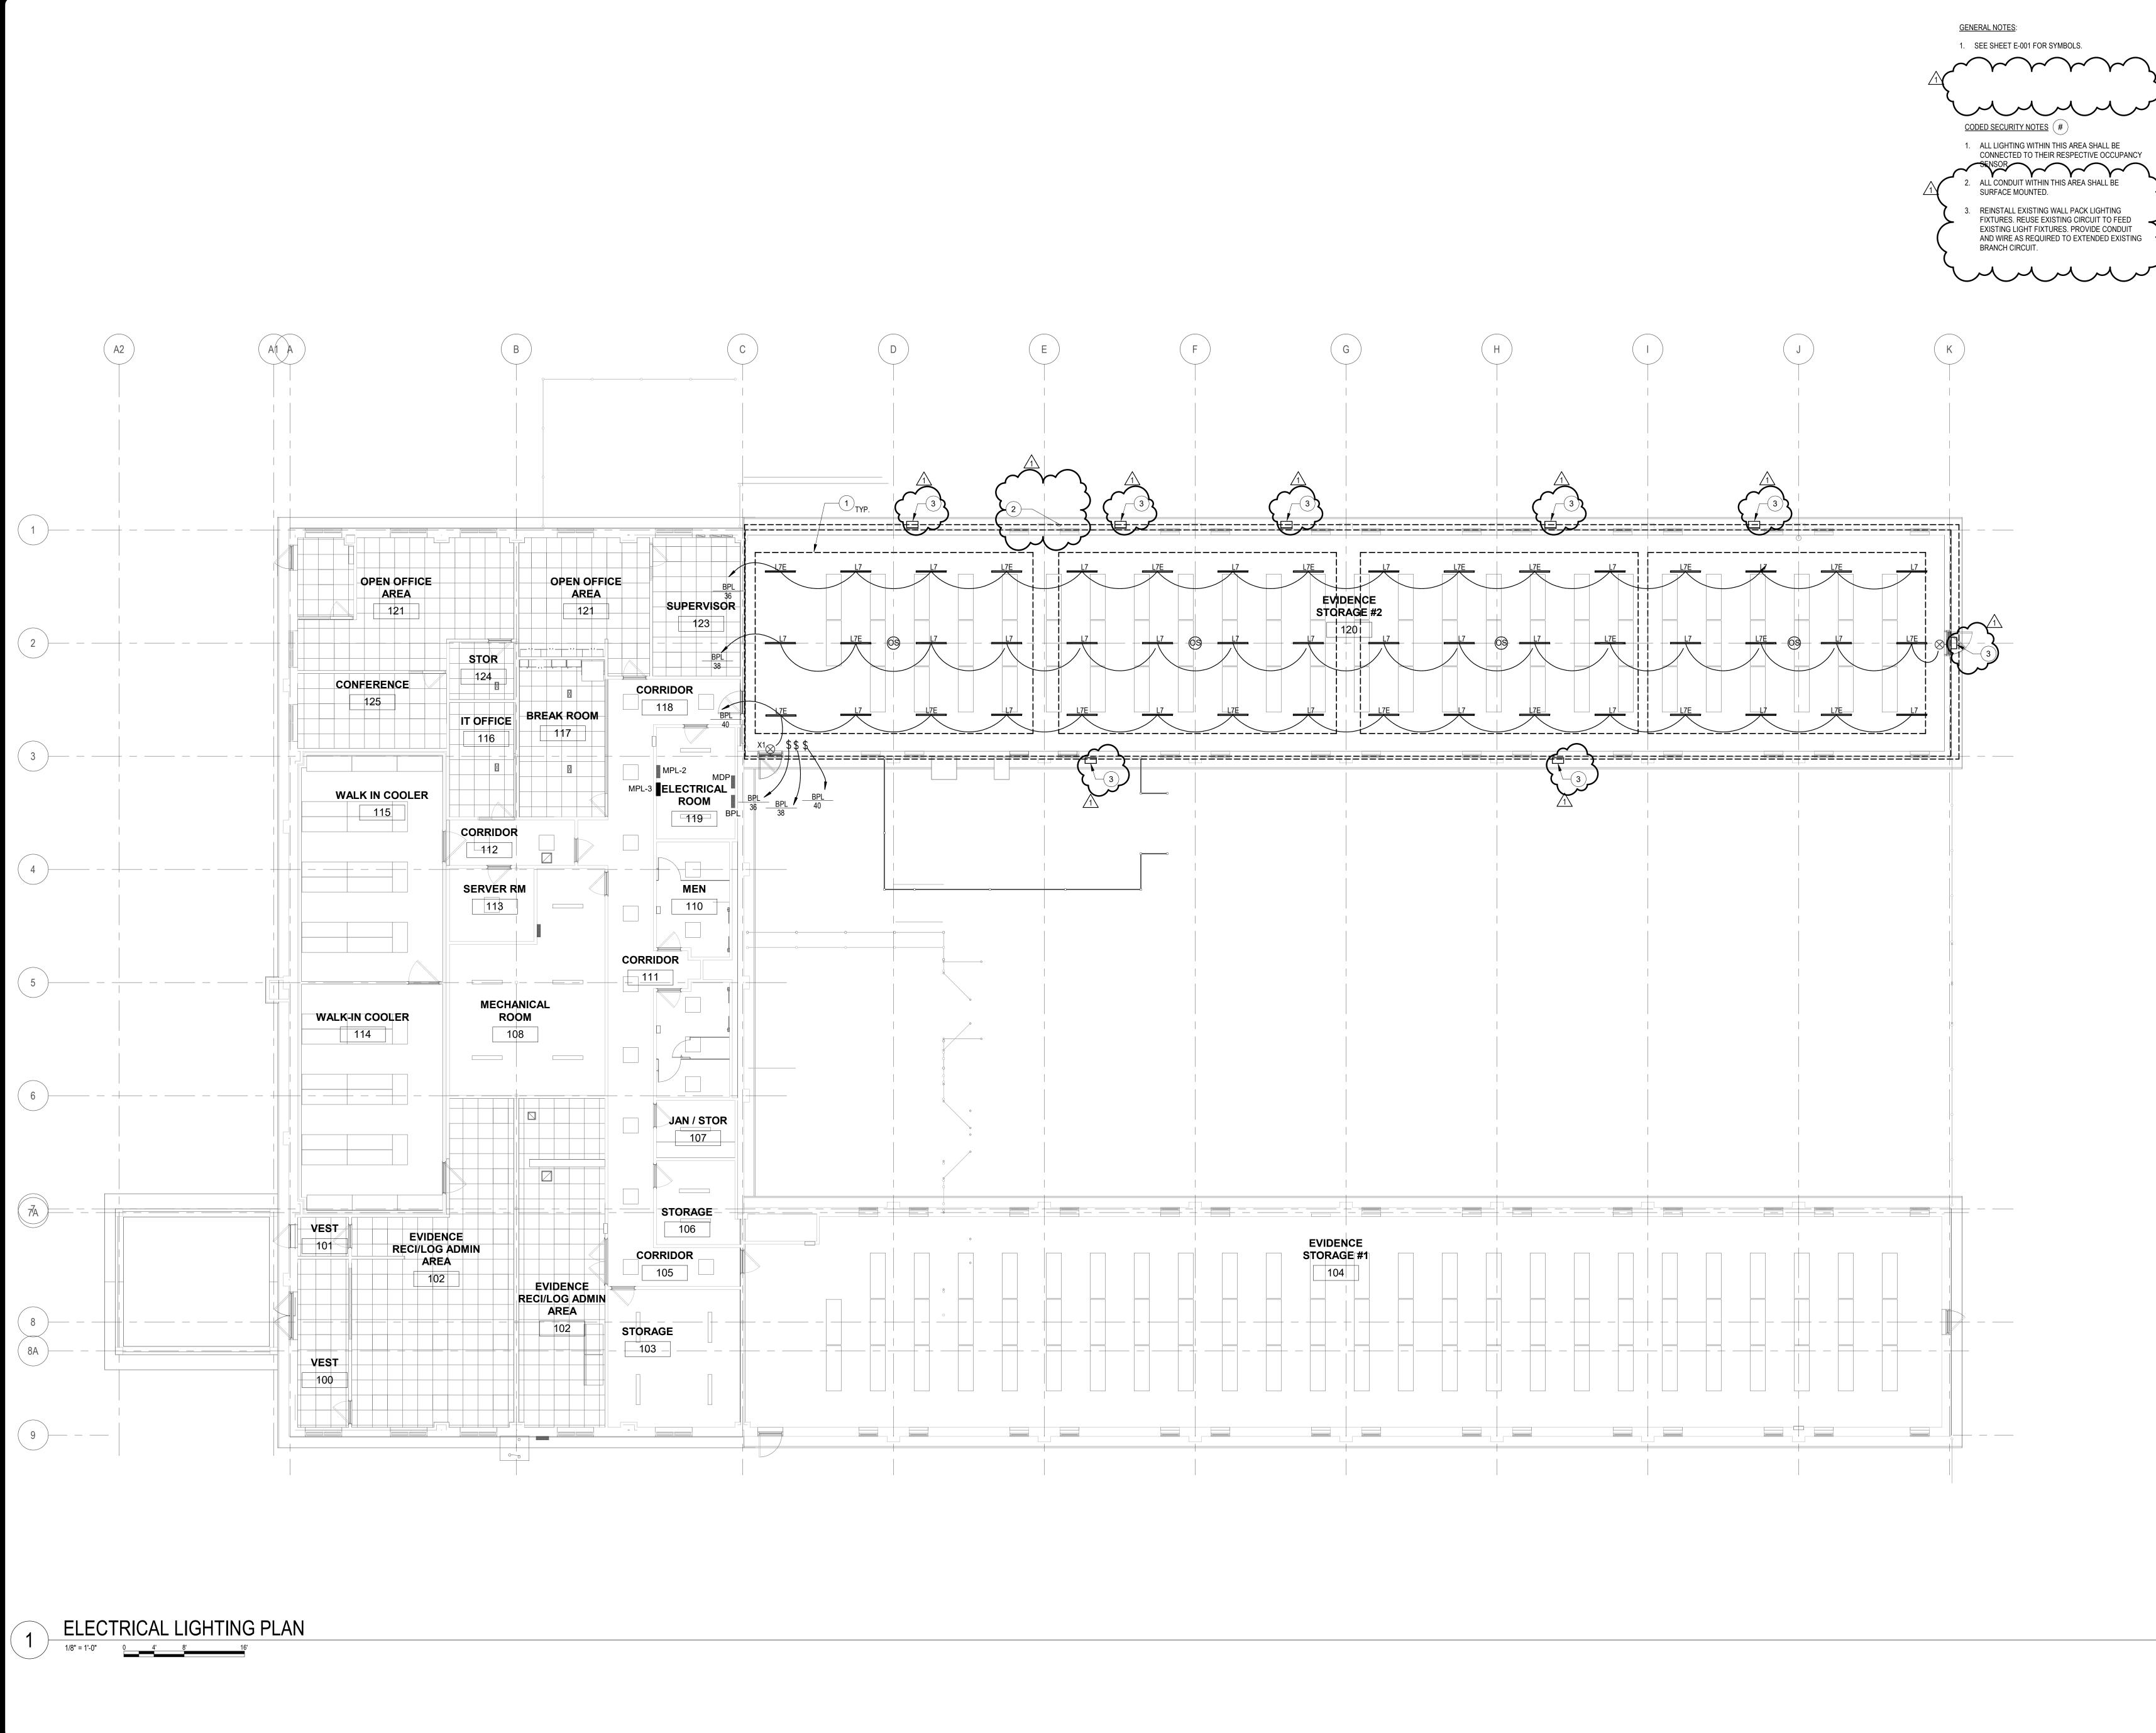

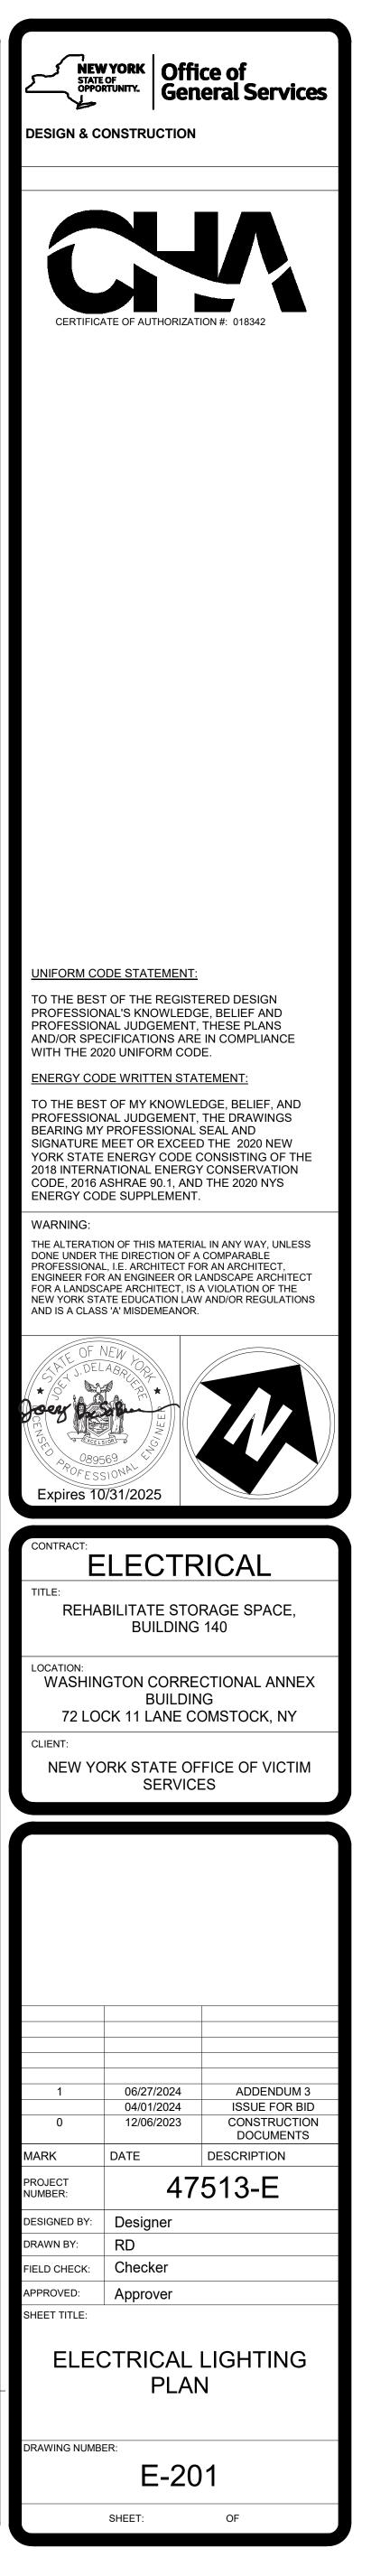

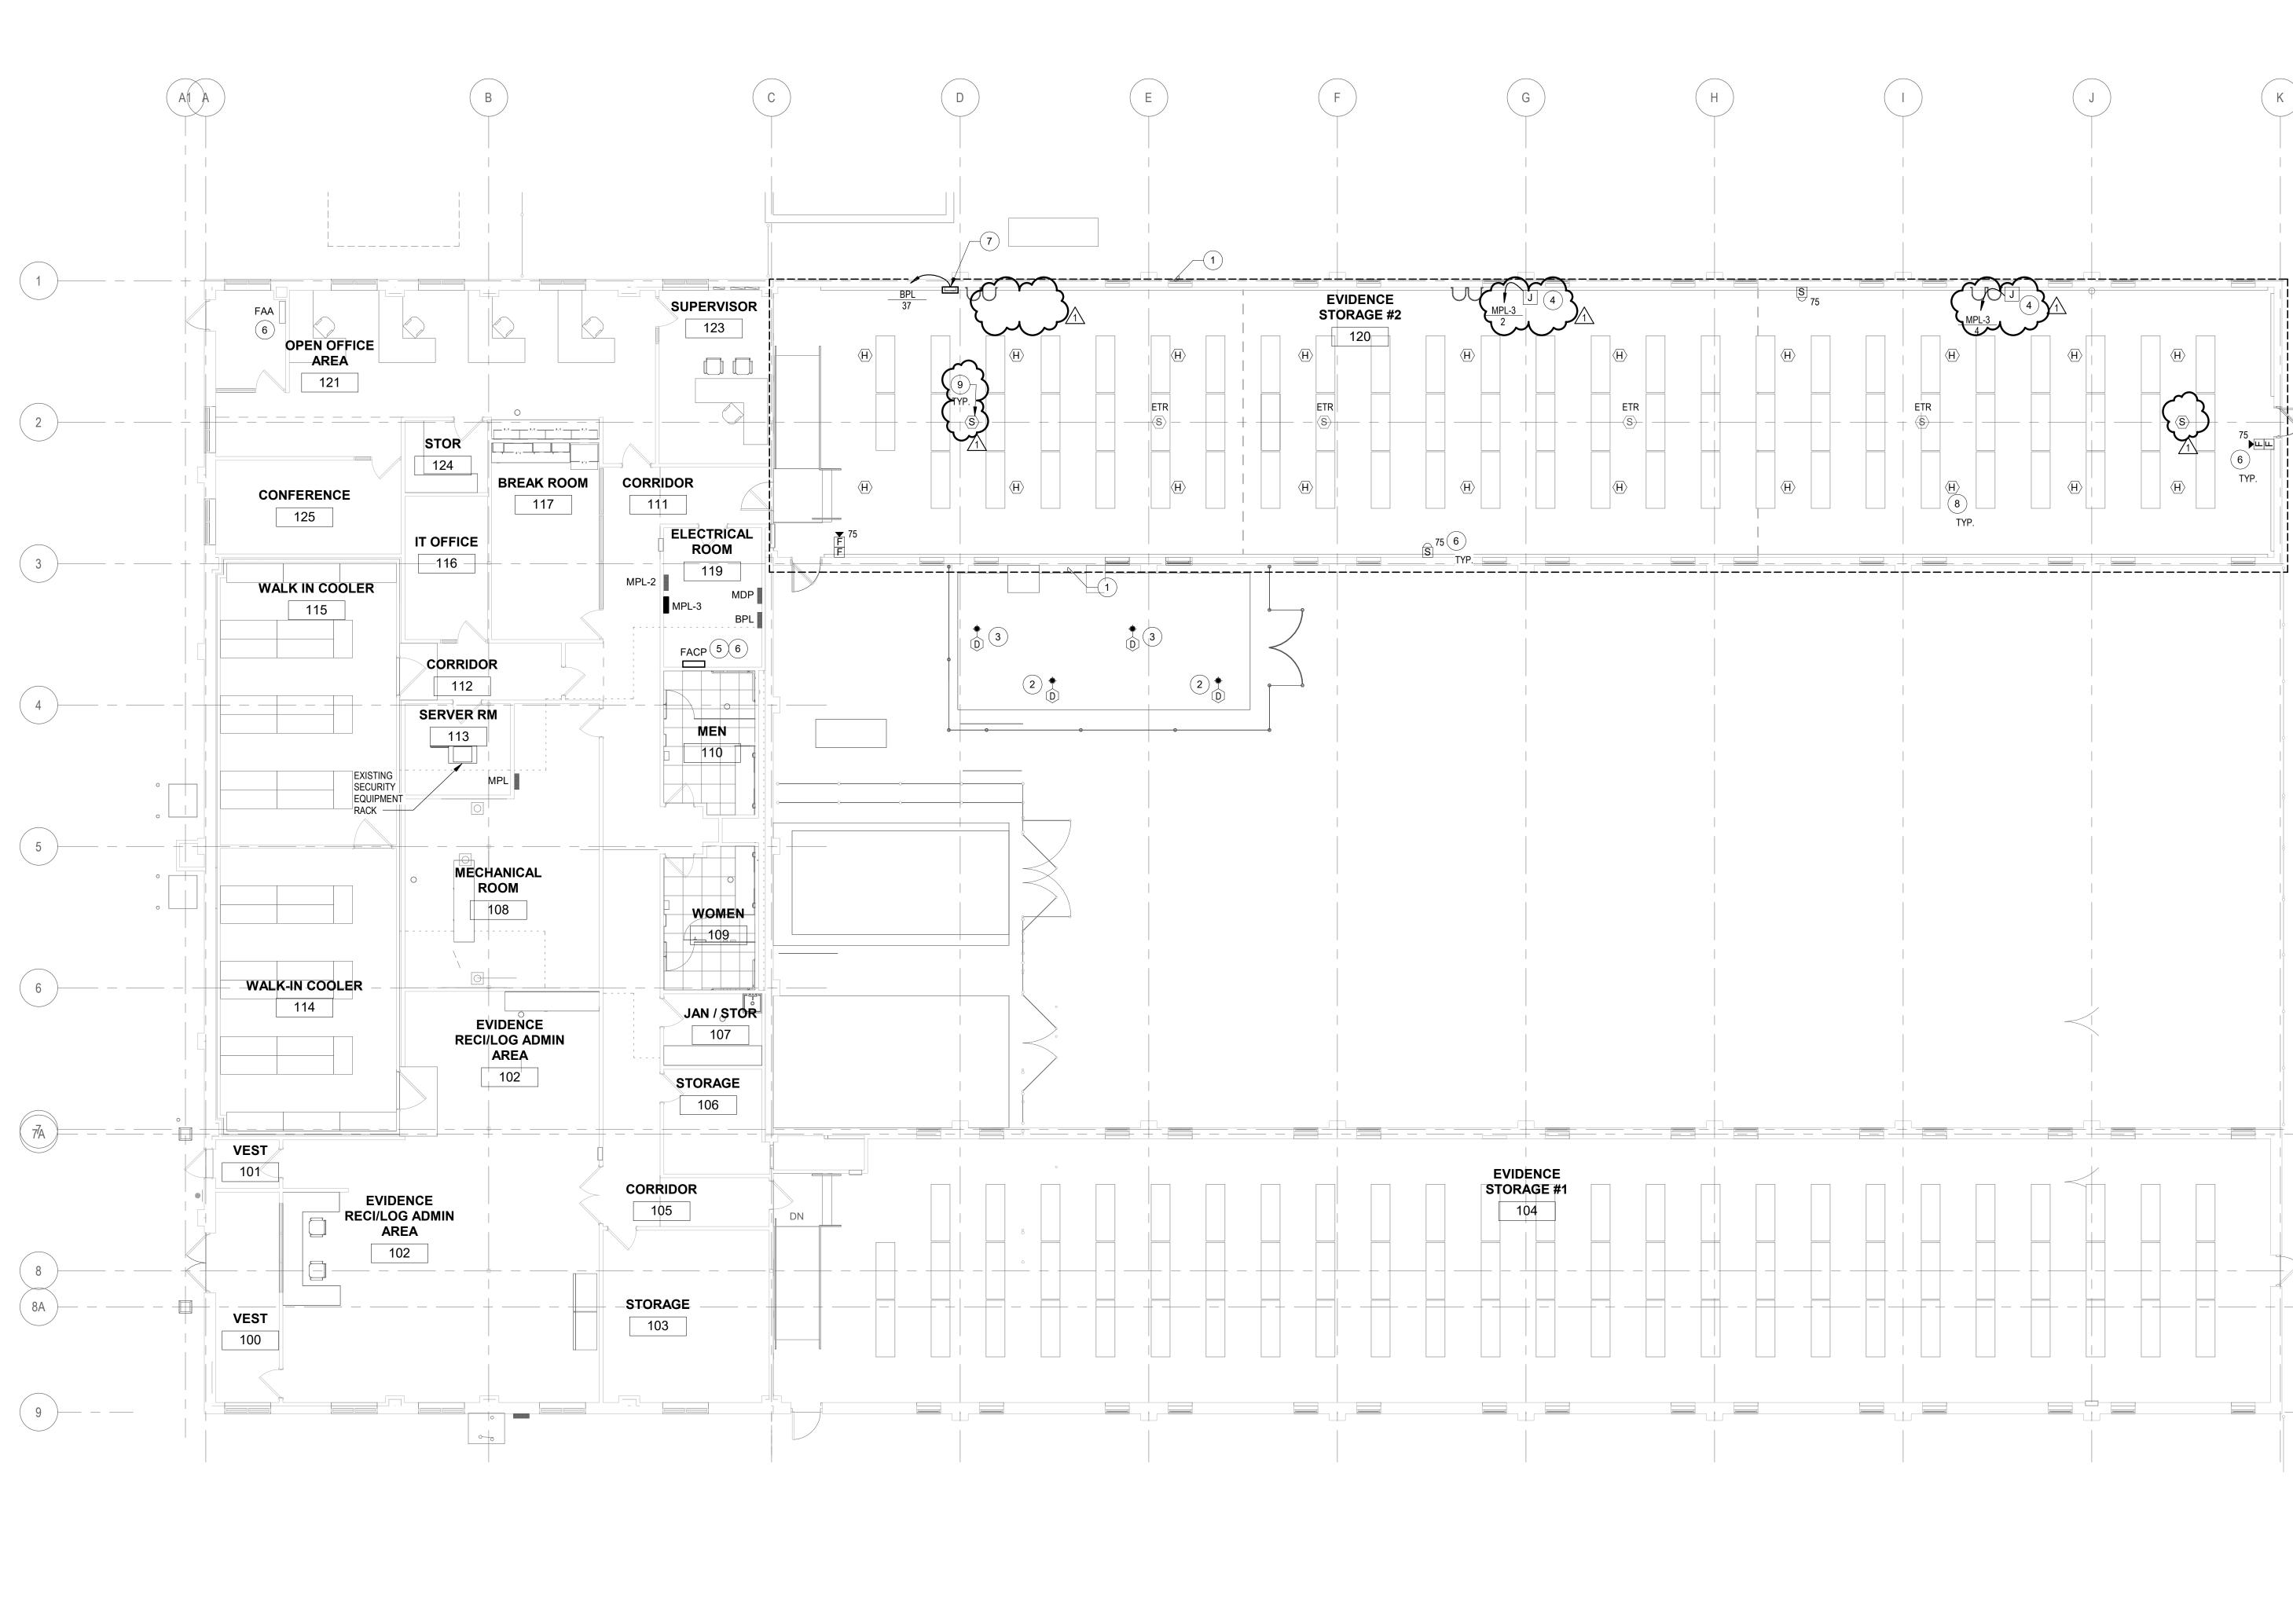



1 <u>ELECTRICAL SYSTEMS PLAN</u> 1/8" = 1'-0" <u>0' 4' 8' 16'</u>

CODED SECURITY NOTES (#) 1. ALL CONDUIT WITHIN THIS AREA SHALL BE SURFACE MOUNTED. 2. DUCT DETECTOR SHALL BE MOUNTED ON THE RETURN AIR DUCTWORK FOR AHU-2 AND AHU-2A. 3. DUCT DETECTOR SHALL BE MOUNTED ON THE SUPPLY CLEAN AGENT PANEL VIA JUCTION BOX PROVIDE SIMPLEX 4100ES FACP PANEL IN PLACE OF REMOVED EXISTING SIMPLEX 4009 PANEL. RECONNECT ALL EXISTING CIRCUITS. AFTER REINSTALLATION OF ALL EXISTING CIRCUITS TO REPLACE FACP TEST/PROGRAM COMPLETE SYSTEM AS PER SPECIFICATION AND MANUFACTURER'S RECOMMENDATIONS. FOR MORE INFORMATION SEE RISER DIAGRAM DETAILS 2 AND 3 ON DRAWING E-601. 6. ALL FIRE ALARM DEVICES SHOWN ON DRAWING CONNECTED TO SIMPLEX 4100ES FACP PANEL AND EXISTING FAA PANEL. FOR MORE INFORMATION SEE RISER DIAGRAM DETAIL 2 ON DRAWING E-601. 7. CLEAN AGENT CONTROL PANEL, FURNISHED BY 'P' CONTRACTOR, CIRCUITED BY 'E' CONTRACTOR, CONNECTED TO FIRE ALARM SYSTEM BY 'E' CONTRACTOR. THE CONTROL PANEL MUST BE CONNECTED TO EARTH GROUND. ( K PROVIDE HEAT DETECTOR IN ATTIC SPACE AND CONNECTED TO SIMPLEX 4100ES FACP PANEL AND EXISTING FAA PANEL. FOR MORE INFORMATION SEE RISER DIAGRAM DETAIL 2 ON DRAWING E-601. REINSTALL EXISTING SMOKE DETECTOR CONNECT TO THE EXISTING CIRCUIT <del>╺╾╤┙</del>┿┷<del>╒╼╤╸</del>╸╸╸╸╸╸╸╸<sub>┺</sub>╼╸╺╺┝╻╴ ETR  $\langle H \rangle$ 

GENERAL NOTES:

1. SEE DRAWING E-001 FOR SYMBOLS.

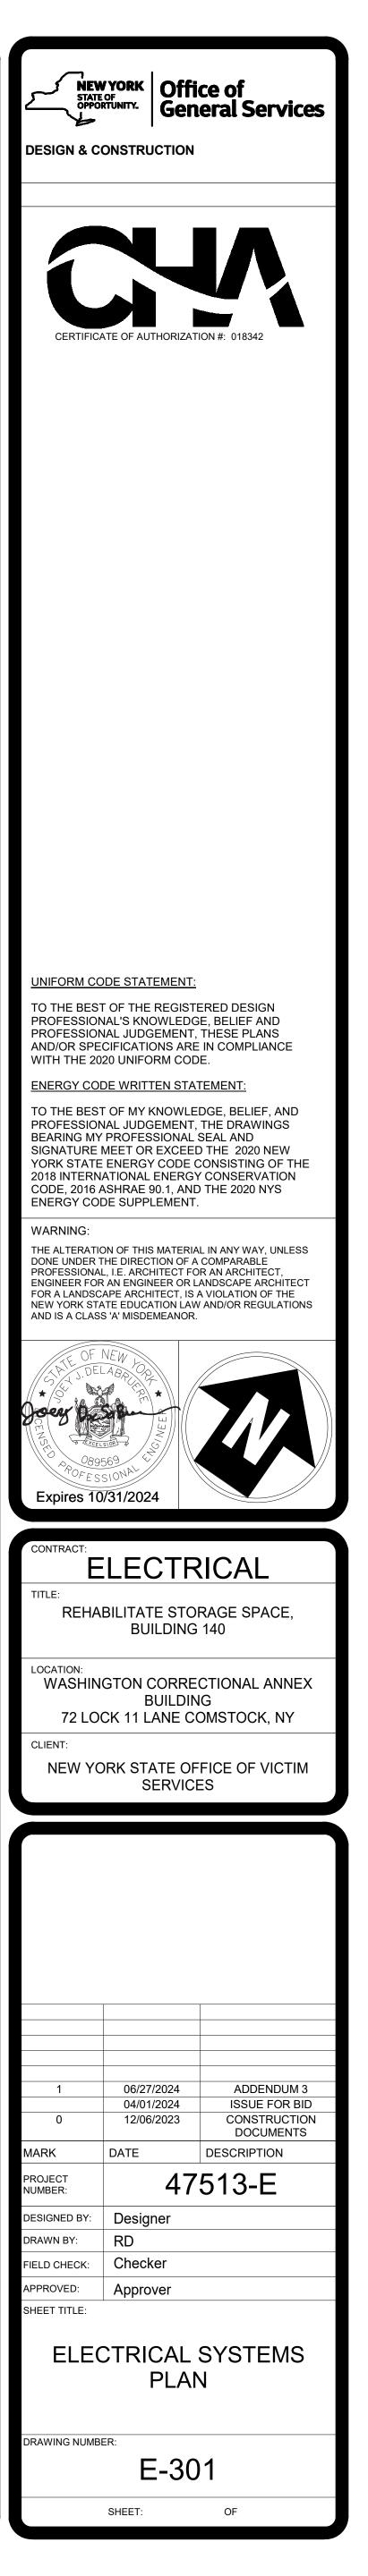


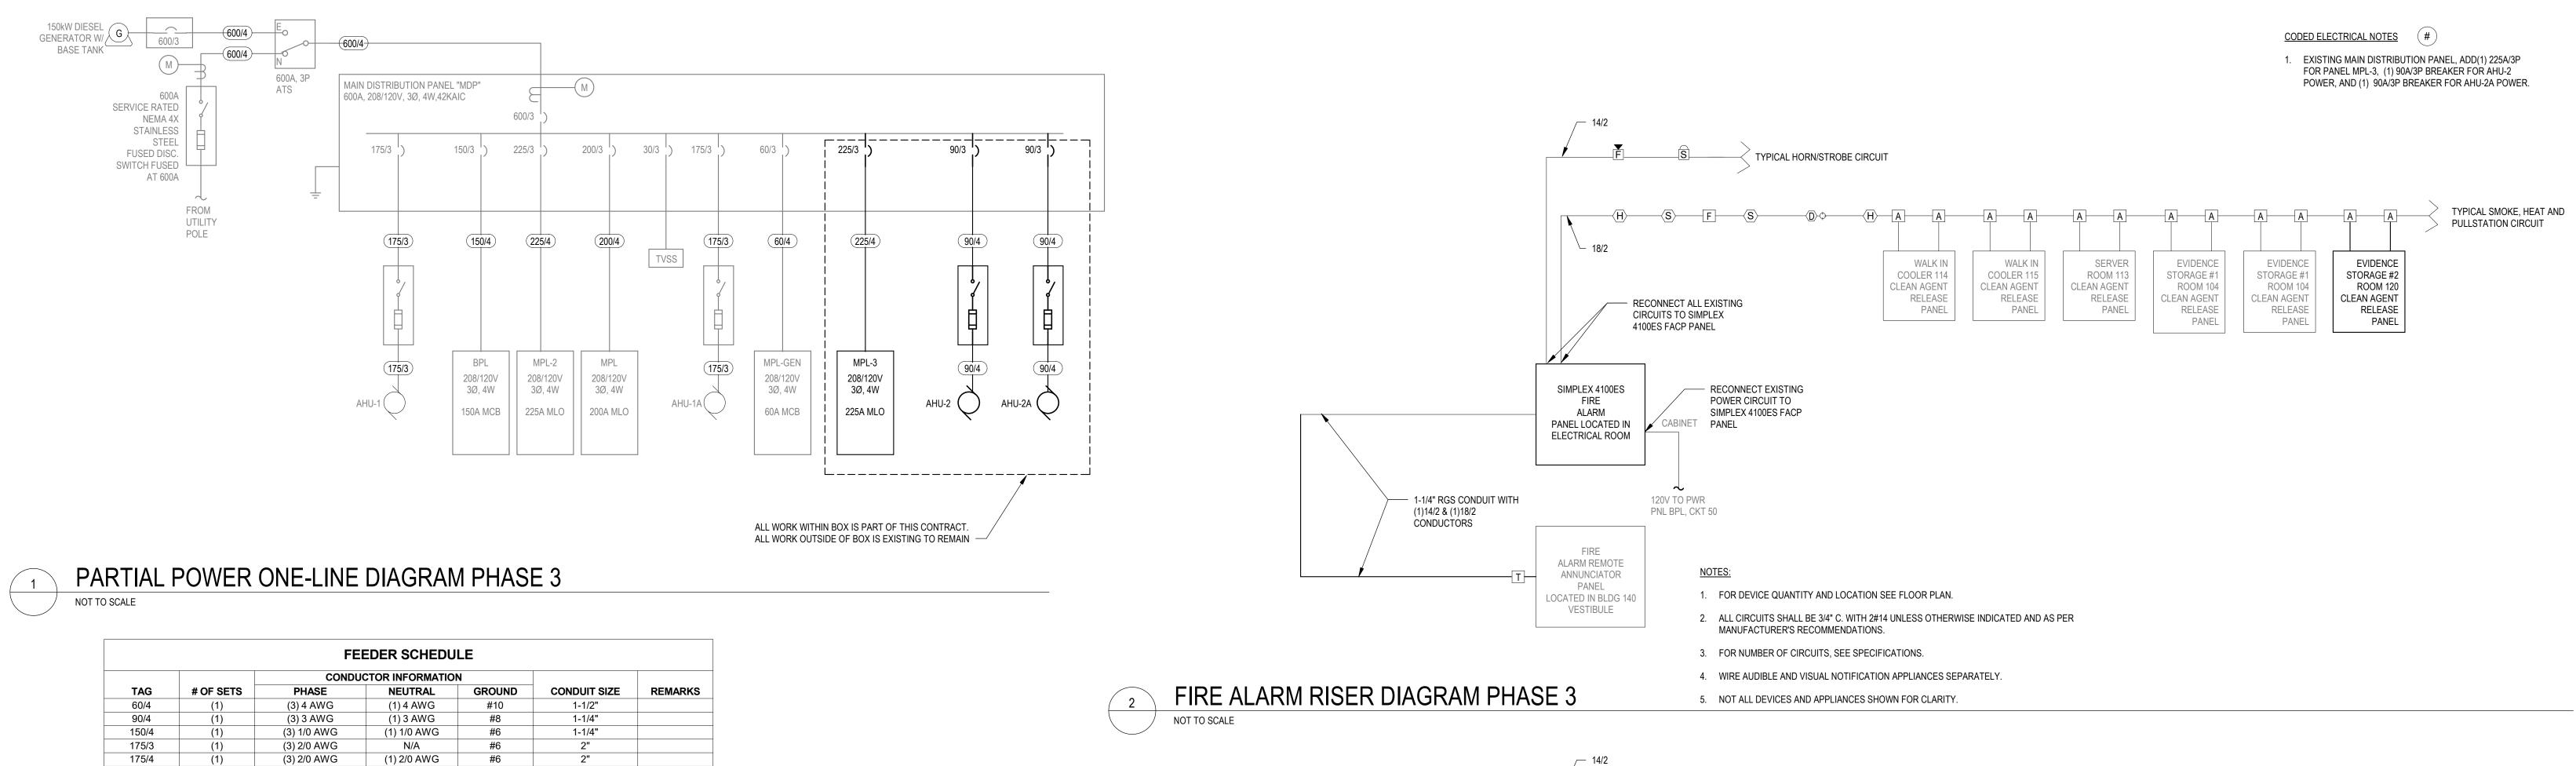



	FEEDER SCHEDULE								
		CONDU							
TAG	# OF SETS	PHASE	NEUTRAL	GROUND	CONDUIT SIZE	REMARKS			
60/4	(1)	(3) 4 AWG	(1) 4 AWG	#10	1-1/2"				
90/4	(1)	(3) 3 AWG	(1) 3 AWG	#8	1-1/4"				
150/4	(1)	(3) 1/0 AWG	(1) 1/0 AWG	#6	1-1/4"				
175/3	(1)	(3) 2/0 AWG	N/A	#6	2"				
175/4	(1)	(3) 2/0 AWG	(1) 2/0 AWG	#6	2"				
200/4	(1)	(3) 3/0 AWG	(1)3/0 AWG	#6	2"				
225/4	(1)	(3) 4/0 AWG	(1) 4/0 AWG	#4	2-1/2"				
350/4	(2)	(3) 350 KCMIL	(1) 350 KCMIL	#1/0	3"				
600/4	(2)	(3) 350 KCMIL	(1) 350 KCMIL	#1/0	3"				

Location: ELECTRICAL ROOM 119 Mounting: Surface Source: MDP					PANEL ID MPL-3							
СКТ	Circuit Description	Trip	Poles	F		E	3	C	;	Poles	Trip	
1	EXISTING EUH-1	50 A	2	3750 VA	360 VA						20 A	NAC CLE
3			_			3750 VA	360 VA				20 A	NAC CLE
5 7	EXISTING EUH-1	50 A	2					3750 VA	0 VA	$\mathbf{\lambda}^{1}$	20 A	SPARE
				3750 VA	0 VA	0750 \/A	0.) (A				20 A	SPARE
9 11	EXISTING EUH-1	50 A	2			3750 VA	0 VA	3750 VA	0 VA		20 A	SPARE SPARE
13				3750 VA	0 VA			3750 VA	UVA	1	20 A 20 A	SPARE
15	EXISTING EUH-1	50 A	2	3750 VA	UVA	3750 VA	0 VA			1	20 A 20 A	SPARE
17	SPARE	20 A	1			5750 VA	0 14	0 VA	0 VA	1	20 A	SPARE
19	SPARE	20 A	1	0 VA	0 VA			0 1/1	0 1/1	1	20 A	SPARE
21	SPARE	20 A	1	0 171	0 171	0 VA	0 VA			1	20 A	SPARE
23	SPARE	20 A	1				-	0 VA	0 VA	1	20 A	SPARE
25	SPARE	20 A	1	0 VA	0 VA					1	20 A	SPARE
27	SPARE	20 A	1			0 VA	0 VA			1	20 A	SPARE
29	SPARE	20 A	1					0 VA	0 VA	1	20 A	SPARE
31	SPARE	20 A	1	0 VA	0 VA					1	20 A	SPARE
33	SPARE	20 A	1			0 VA	0 VA			1	20 A	SPARE
35	SPACE		1							1		SPACE
37	SPACE		1							1		SPACE
39	SPACE		1							1		SPACE
41	SPACE		1							1		SPACE
			tal Load: al Amps:	1161	0 VA	1161 85		7500	VA			

	Location: ELECTRICAL ROOM 119 Mounting: SURFACE Source: MDP					EXISTING PANEL ID BPL						
скт	Circuit Description	Trip	Poles		4	E	3	(		Poles	Trip	
1	REC: OPEN OFFICE 121 & VEST 127	20 A	1	900 VA	720 VA					1	20 A	REC: OP
3	Receptacle CONFERENCE 125	20 A	1			720 VA	1260 VA			1	20 A	REC: OPE
5	REC: SUPERVISOR 123	20 A	1					900 VA	600 VA	1	20 A	Receptac
7	Receptacle BREAK ROOM 117	20 A	1	800 VA	780 VA					1	20 A	Receptac
9	Receptacle BREAK ROOM 117	20 A	1			1080 VA	540 VA			1	20 A	Receptac
11	HD-1 IN RM 110	20 A	1					1440 VA	720 VA	1	20 A	REC: RM
13	Receptacle MEN 110	20 A	1	180 VA	360 VA					1	20 A	Receptac
15	REC: SERVER RM 113	20 A	1			720 VA	360 VA			1	20 A	REC: DAT
17	Receptacle JAN / STOR 107	20 A	1					540 VA	600 VA	1	20 A	Receptac
19	Receptacle EVIDENCE RECI/LOG ADMIN AREA 102	20 A	1	800 VA	180 VA					1	20 A	Receptac
21	Receptacle WOMEN 109	20 A	1			180 VA	720 VA			1	20 A	Receptac
23	Receptacle EVIDENCE RECI/LOG ADMIN AREA 102	20 A	1					720 VA	720 VA	1	20 A	REC: AD
25	Receptacle EVIDENCE RECI/LOG ADMIN AREA 102	20 A	1	780 VA	780 VA					1	20 A	Receptac
27	Receptacle EVIDENCE STORAGE #1 104	20 A	1			540 VA	540 VA			1	20 A	Receptac
29	LGT: ROOMS 121, 123, 126, 127, 124, 125	20 A	1					814 VA	383 VA	1	20 A	LGT: ROO
31	LGT: ROOMS 101, 102, 100, 103, 113, 108	20 A	1	925 VA	262 VA					1	20 A	LGT: ROO
33	LGT: EVIDENCE STORAGE #1 104 - SOUTH	20 A	1			544 VA	1080 VA			1	20 A	Receptac
35	LGT: EVIDENCE STOR. #1 104 - NORTH	20 A	1					544 VA	544 VA	1	20 A	EXIST LG
37	CLEAN AGENT PNL - EVIDENCE STOR. #2 120	20 A	1	0 VA	547 VA					1	20 A	EXIST LG
39	BAS PNL - EVIDENCE STOR. #2 120	20 A	1			0 VA	547 VA			1	20 A	EXIST LG
41	SPARE	20 A	1					0 VA	180 VA	1	20 A	Receptac
43	LGT: WALK IN COOLERS 114 & 115	20 A	1	464 VA	0 VA					1	20 A	SPARE
45	LGT: EVIDENCE STORAGE #1 104 - CENTER	20 A	1			544 VA	1440 VA			1	20 A	HD-2 IN F
47	Receptacle CORRIDOR 111	20 A	1					1200 VA	0 VA	1	20 A	NACT/BA
49	LGT: EXTERIOR	20 A	1	312 VA	0 VA					1	20 A	NAC
51	SPARE	20 A	1			0 VA	0 VA			1	20 A	SPARE
53	SPACE		1							1		SPACE
		Tot	tal Load:	879	0 VA	1081	5 VA	990	5 VA			
		Tota	al Amps:	L		82	A	1				

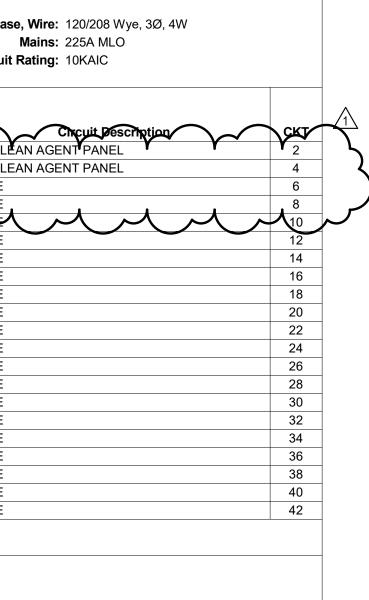

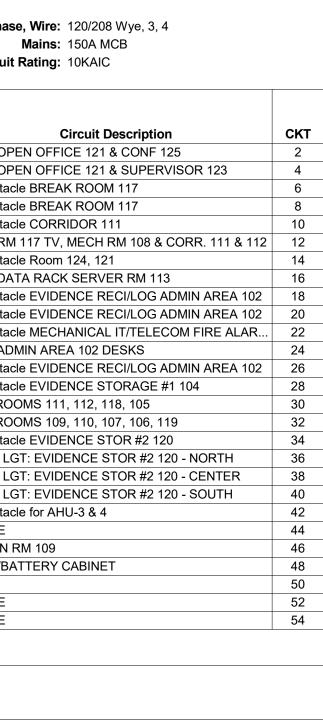

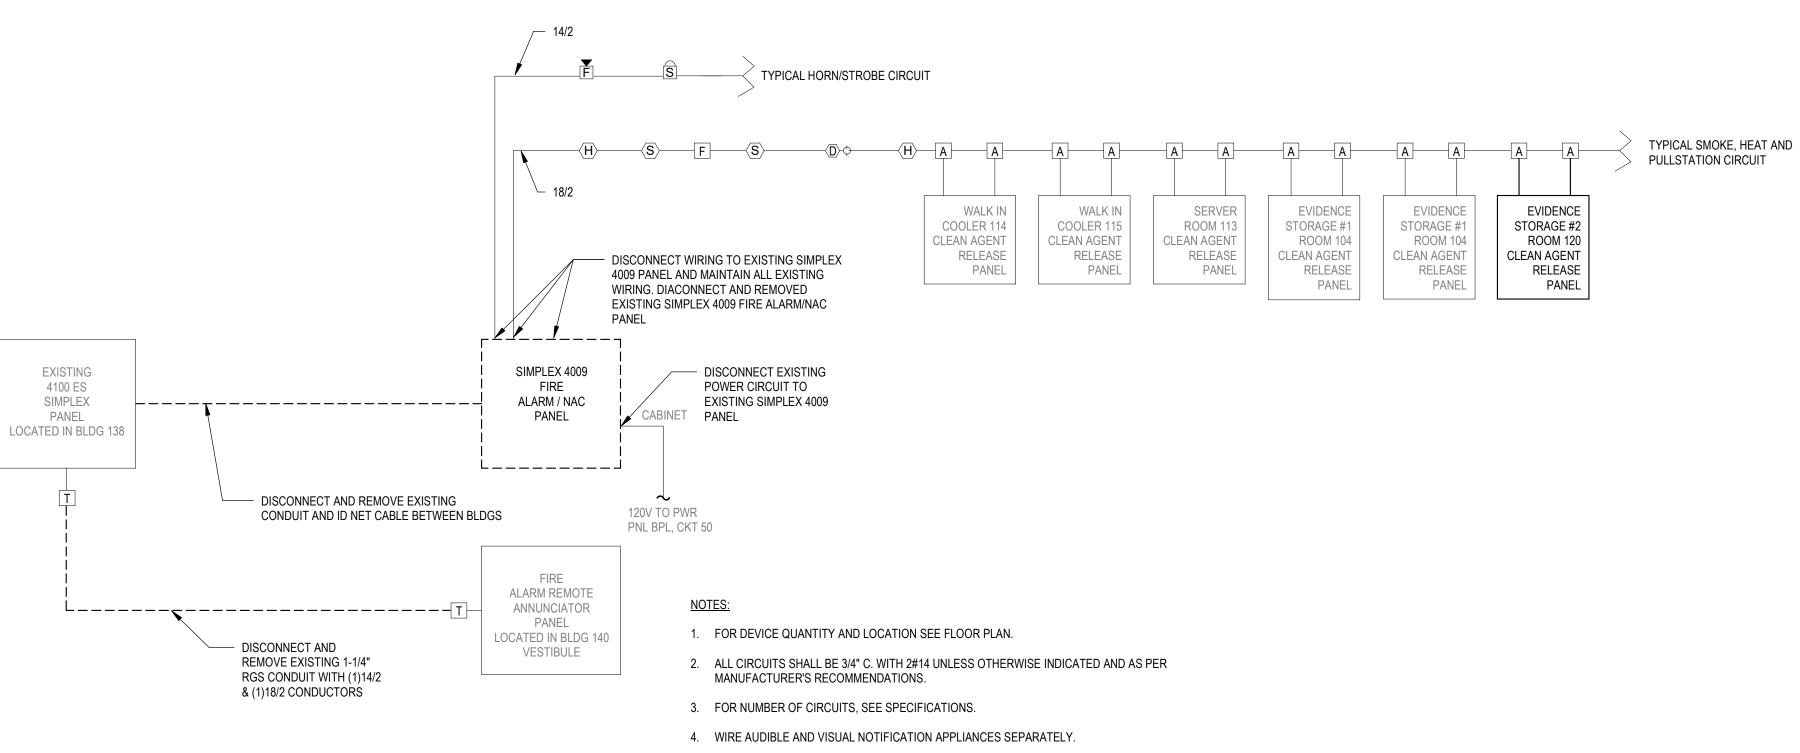



# FIRE ALARM RISER REMOVAL DIAGRAM PHASE 3 NOT TO SCALE

Location: ELECTRICAL ROOM 119 Mounting: SURFACE Source: ATS							MDP				Volts, Phase, Wire: 120/208 Wye, 3Ø, 4W Mains: 600A MCB Short Circuit Rating: 42KAIC			
СКТ	Circuit Description	Trip	Poles		4		В		C	Poles	Trip	Circuit Description	ск	
1				16573	8790 VA								2	
3	AHU-1(EXISTING)	175 A	3			16573	10815			3	150 A	BPL (EXISTING)	4	
5								16573	9905 VA				6	
7				15898	2000 VA								8	
9	MPL (EXISTING)	200 A	3			19072	2000 VA			3	30 A	TVSS (EXISTING)	10	
11								12471	2000 VA				12	
13				0 VA	2000 VA								14	
15	AHU-1A (EXISTING)	175 A	3			0 VA	1200 VA			3	60 A	MPL-GEN(EXISTING)	16	
17								0 VA	0 VA				18	
19				7445 VA	553 VA								20	
21	AHU-2 (1)	90 A	3			7445 VA	553 VA			3	90 A	AHU-2A (1)	22	
23								7445 VA	553 VA				24	
25				66 VA	11610							$\square$	26	
27	MPL-2	225 A	3			66 VA	11610			3	225 A	MPL-3 (1)	28	
29								66 VA	7500 VA				30	
		Tot	al Load:	6593	6 VA	6933	34 VA	5651	4 VA					
		Tota	al Amps:			53	2 A							

LIGHTING FIXTURE SCHEDULE PHASE 3								
Туре	DESCRIPTION	COLOR TEMP.	LAMP(S)	MOUNTING TYPE	VOLTAGE	WATTAGE	BASIS OF DESIGN	COMMENTS
CHA_2x2								
L6E	LED WALL PACK WITH EMERGENCY BATTERY BACKUP	3000K	LED	WALL	120/277V	52W	LITHONIA: WDGE3 LED-P1-30K-80CRI-R3-MVOLT-SRM-E20WCPE-DDBXD OR EQUAL	MOUNT FIXTURE 8'-0" AFF
L7	4' LED STRIP LIGHT	3500K	LED	SURFACE	120/277V	34W	LITHONIA: ZL1N-L48-SMR-5000LM-FST-MVOLT-35K-90CRI-WH OR EQUAL	
L7E	4' LED STRIP LIGHT WITH EMERGENCY BATTERY BACKUP	3500K	LED	SURFACE	120/277V	34W	LITHONIA: ZL1N-L48-SMR-5000LM-FST-MVOLT-35K-90CRI-E15WLCP-WH OR EQUAL	
X1	WALL MOUNTED EXIT SIGN		LED	WALL	120/277V	2.6W	DUAL LITE: SE-S-R-W-E-I OR EQUAL	

5. NOT ALL DEVICES AND APPLIANCES SHOWN FOR CLARITY.

Expires 10	/31/2024								
TITLE: REHAI	ELECTRICAL TITLE: REHABILITATE STORAGE SPACE, BUILDING 140								
CLIENT:	· · · · · · · · · · · · · · · · · · ·								
1	06/27/2024 04/01/2024 12/06/2023	ADDENDUM 3 ISSUE FOR BID CONSTRUCTION DOCUMENTS							
MARK	DATE	DESCRIPTION							
PROJECT NUMBER:	4	7513-E							
DESIGNED BY: Designer DRAWN BY: RD FIELD CHECK: APPROVED: SHEET TITLE: RISER DIAGRAMS, SCHEDULES AND DETAILS									
SCHL									
DRAWING NUMBE	DRAWING NUMBER: E-601								
	SHEET:	OF							


PROFESSIONAL JUDGEMENT, THE DRAWINGS BEARING MY PROFESSIONAL SEAL AND SIGNATURE MEET OR EXCEED THE 2020 NEW YORK STATE ENERGY CODE CONSISTING OF THE 2018 INTERNATIONAL ENERGY CONSERVATION CODE, 2016 ASHRAE 90.1, AND THE 2020 NYS ENERGY CODE SUPPLEMENT. WARNING: THE ALTERATION OF THIS MATERIAL IN ANY WAY, UNLESS

DONE UNDER THE DIRECTION OF A COMPARABLE PROFESSIONAL, I.E. ARCHITECT FOR AN ARCHITECT,


AND IS A CLASS 'A' MISDEMEANOR.

ENGINEER FOR AN ENGINEER OR LANDSCAPE ARCHITECT FOR A LANDSCAPE ARCHITECT, IS A VIOLATION OF THE NEW YORK STATE EDUCATION LAW AND/OR REGULATIONS

UNIFORM CODE STATEMENT: TO THE BEST OF THE REGISTERED DESIGN PROFESSIONAL'S KNOWLEDGE, BELIEF AND PROFESSIONAL JUDGEMENT, THESE PLANS AND/OR SPECIFICATIONS ARE IN COMPLIANCE WITH THE 2020 UNIFORM CODE. ENERGY CODE WRITTEN STATEMENT: TO THE BEST OF MY KNOWLEDGE, BELIEF, AND

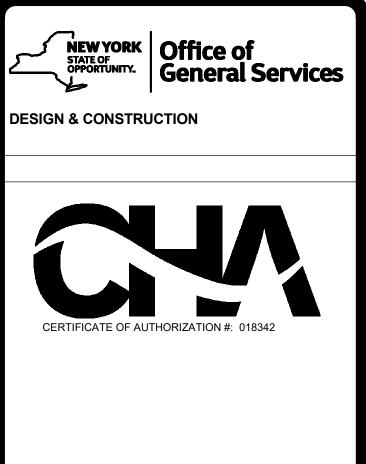

C:\Users\8026\OneDrive - CHA Consulting, Inc\Documents\081408\_SEC\_R23\_SAlvarez3X6DA.r<sup>v</sup> 6/26/2024 5:31:21 PM

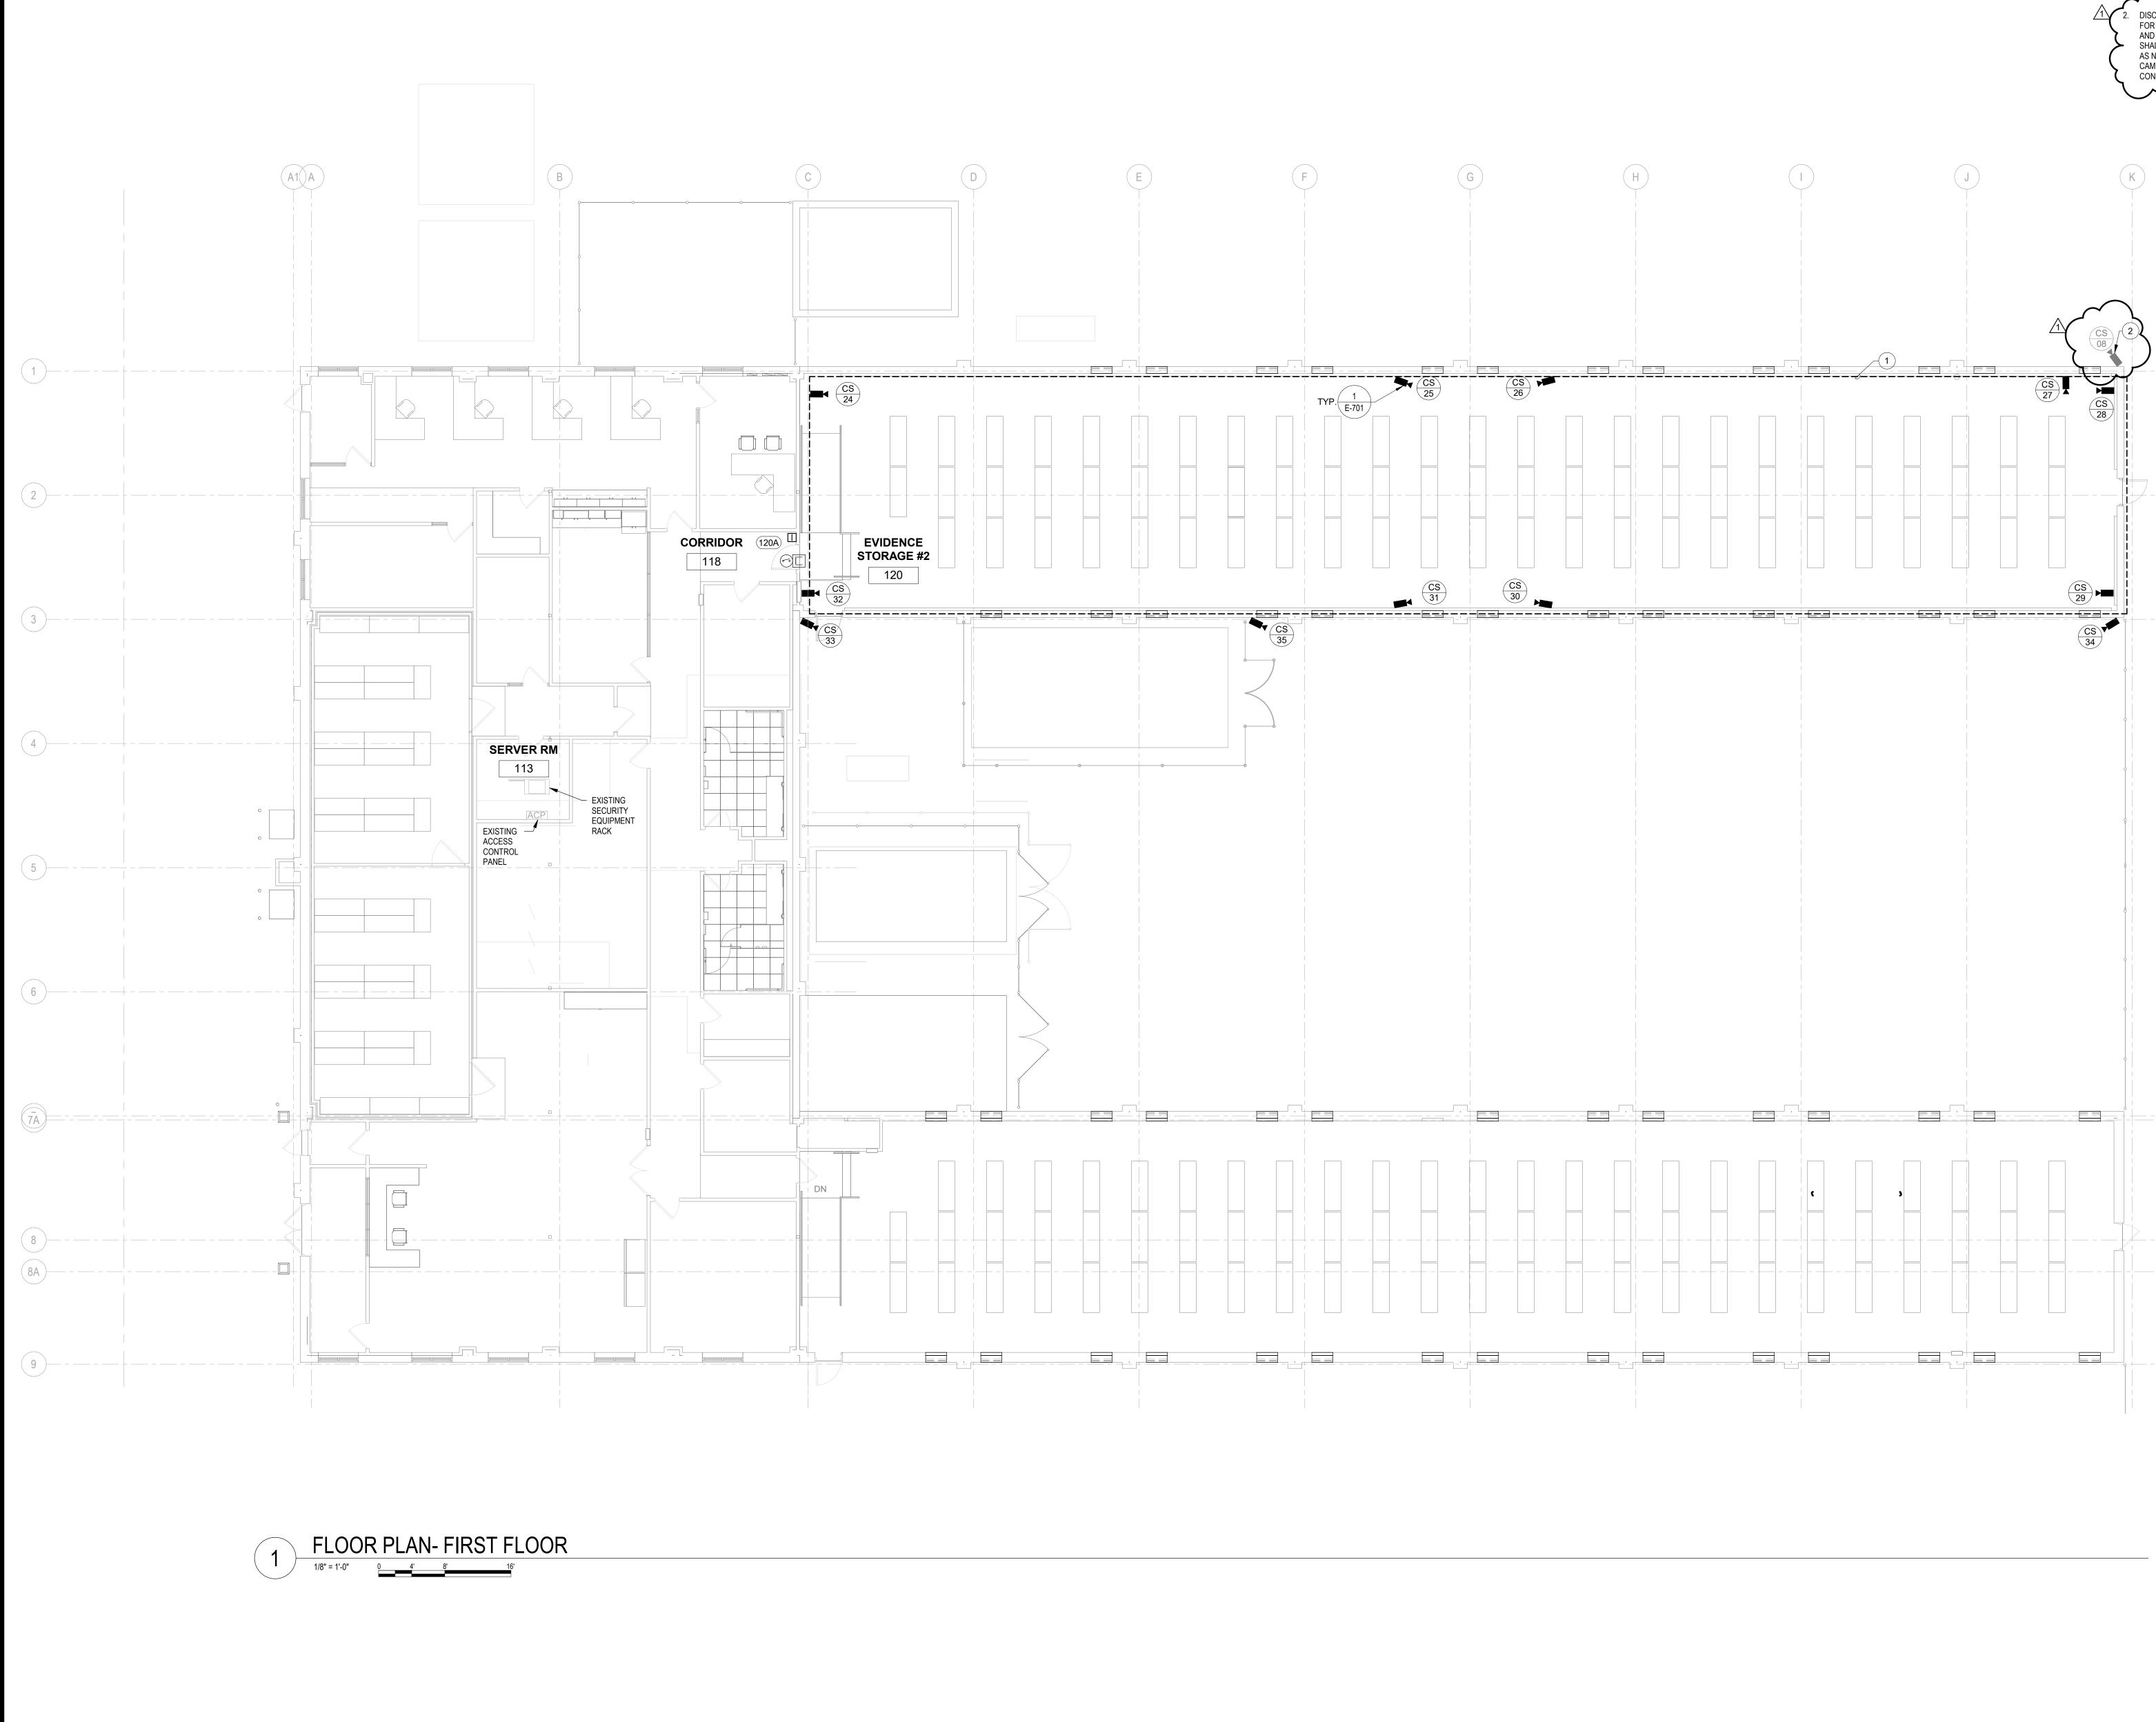

GENERAL NOTES:

1. SEE DRAWING SE-001 FOR SYMBOLS.

## CODED SECURITY NOTES

