NEW YORK STATE | Office of General Services

DESIGN & CONSTRUCTION GROUP
THE GOVERNOR NELSON A. ROCKEFELLER
EMPIRE STATE PLAZA
ALBANY, NY 12242

ADDENDUM NO. 1 TO PROJECT NO. 44782

ELECTRICAL WORK
PROVIDE FIRE ALARM AND EMERGENCY VOICE EVACUATION SYSTEM
EMPIRE STATE PLAZA
ALBANY, NY 12242

April 24, 2025

NOTE: This Addendum forms a part of the Contract Documents. Insert it in the Project Manual. Acknowledge receipt of this Addendum in the space provided on the Bid Form.

DRAWINGS

1. Revised Drawings:
   a. Drawing Nos. F-C-601, F-C-604, F-P-131, F-P-602, F-P-605, and F-P-607, noted "ADDENDUM 1 4/24/2025" accompanies this Addendum and supersedes the same originally issued drawings.

2. Addendum Reference Drawings:
   a. 44782 REFERENCE DRAWING SET 1 (pages 1-25), noted "44782 REFERENCE DRAWING SET 1" accompanies this Addendum. Reference drawings were prepared for other projects and are furnished only to show related conditions. Examine the Reference Drawings to ascertain the relationship of the Work to the indicated conditions.

END OF ADDENDUM

Brady M. Sherlock, P.E.
Director, Division of Design
Design & Construction


ALL FIRE ALARM AND EMERGENCY COMMUNICATION CIRCUITS		
	PATHWAY CLASS	**PATHWAY SURVIVABILITY**
NETWORK SLC	CLASS A	LEVEL 3
LOW LEVEL VOICE BUSS	CLASS A	LEVEL 3
SIGNALING LINE CIRCUIT (SLC)	CLASS A	
INITIATING DEVICE CIRCUIT	CLASS B	
AUDIO NOTIFICATION SPEAKER CIRCUIT	CLASS A	LEVEL 3
VISUAL STROBE CIRCUIT	CLASS A	LEVEL 3
CONTROL	CLASS B	
ALL RISERS (INCLUDING FROM RISER TO PANELS ON FLOORS)	CLASS A	LEVEL 3

RISER KEYNOTES

1. FIBER OPTIC PATCH PANEL SHALL BE PROVIDED AT THE LOCATION OF THE EXISTING MASTER FIRE ALARM CONTROL PANEL AND CIRCUITED INTO THE FIBER LOOP.
2. ABRAMS FIBER OPTIC PATCH PANEL AND MASTER ICU AND FIBER CONNECTION FROM AND BACK TO ICM 8 TO BE PROVIDED UNDER OGS PROJECT #45884.
3. LEGISLATIVE OFFICE BUILDING FIBER OPTIC PATCH PANEL AND MASTER ICU AND FIBER OPTIC CONNECTION FROM AND BACK TO ICM 7 TO BE PROVIDED UNDER OGS PROJECT #45884.
4. PROVIDE TWO(2) 2-#12 AND 1-#12 GROUND IN ¾"C FOR EACH ICU AND ONE (1) FOR EACH REMOTE AUXILIARY POWER SUPPLIES AND ONE (1) FOR EACH AMPLIFIER. ADD 20A-1P CIRCUIT BREAKERS TO EACH EXISTING ELECTRICAL POWER PANEL. BREAKERS SHALL BE RED AND LOCKABLE. LABEL BREAKERS.
5. REMOVE EXISTING ELEVATOR RECALL FIRE ALARM CONTROL PANEL.
6. EXISTING ICU'S FOR AGENCY BUILDINGS AND CORNING TOWER ARE OUT OF SCOPE. PROVIDE FOPP AT LOCATION SHOWN (SEE FLOOR PLANS) FOR FUTURE CONNECTION.
7. FIBER OPTIC PATHWAY ADDED TO SHOW CONNECTIVITY FROM CONCOURSE LEVEL TO PARKING LEVELS.
8. REMOTE ANNUNCIATORS (RA) ARE TO BE PROVIDED AT THESE TWO LOCATIONs. SEE SHEET NOTE 3 FOR ADDITIONAL POWER REQUIREMENTS.
9. SWAN STREET FIBER OPTIC PATCH PANEL AND MASTER ICU AND FIBER CONNECTION FROM AND BACK TO ICM 7 TO BE PROVIDED UNDER OGS PROJECT #44894.
10. CAPITOL BUILDING FIBER OPTIC PATCH PANEL AND MASTER ICU AND FIBER CONNECTION FROM AND BACK TO ICM 4 TO BE PROVIDED UNDER OGS PROJECT #47010.

SHEET NOTES

1. PROVIDE MULTI MODE MULTI STRAND FIBER OPTIC NETWORK CABLE TO CONNECT P LEVELS TO THE NEW YORK STATE FIRE COMMAND CENTER ON THE CONCOURSE LEVEL.
2. NOT ALL DEVICES AND EQUIPMENT SHOWN. REFER TO PLAN DRAWINGS FOR EXACT QUANTITIES OF EQUIPMENT TO PROVIDE.
3. FOR EACH CONTROL UNIT ENCLOSURE AND NAP POWER SUPPLY, PROVIDE A 120 VAC, 20 AMP, 1 POLE CIRCUIT INCLUDING 200 FEET OF TWO NO. 12 AWG, THHN/THWN, 600 VAC INSULATED CONDUCTORS, WITH ONE NO. 12 AWG EQUIPMENT GROUND. COORDINATE WITH OWNER FOR CONNECTION TO EXISTING 120 VAC DISTRIBUTION PANEL. PROVIDE COMPATIBLE 20 AMP, 22,000 AIC CIRCUIT BREAKER TO MATCH DISTRIBUTION PANEL SPECIFICATIONS.
4. ALL WIRING SHALL BE PROVIDED IN EMT CONDUIT, ¾ INCH TRADE SIZE MINIMUM UNLESS OTHERWISE NOTE (UON) RISER EMT CONDUIT SHALL BE 2 INCH TRADE SIZE MINIMUM.
5. FOR CLARITY, CLASS A CIRCUIT RETURN PATHWAYS NOT SHOWN AND SHALL BE PROVIDED IN ACCORDANCE WITH NFPA 72 REQUIREMENTS.
6. PROVIDE 4-1 INCH INNERDUCT IN EACH ICM ROOM OR SIGNAL VAULT IN THE AVAILABLE 4 INCH DUCT BANK. USE ONE FOR FIRE ALARM ONLY, THE REMAINING INNERDUCT ARE FOR SPARE USAGE.
7. SEE DRAWINGS F-C-604 AND DRAWING F-C-607 FOR WIRE AND CONDUIT SCHEDULES.

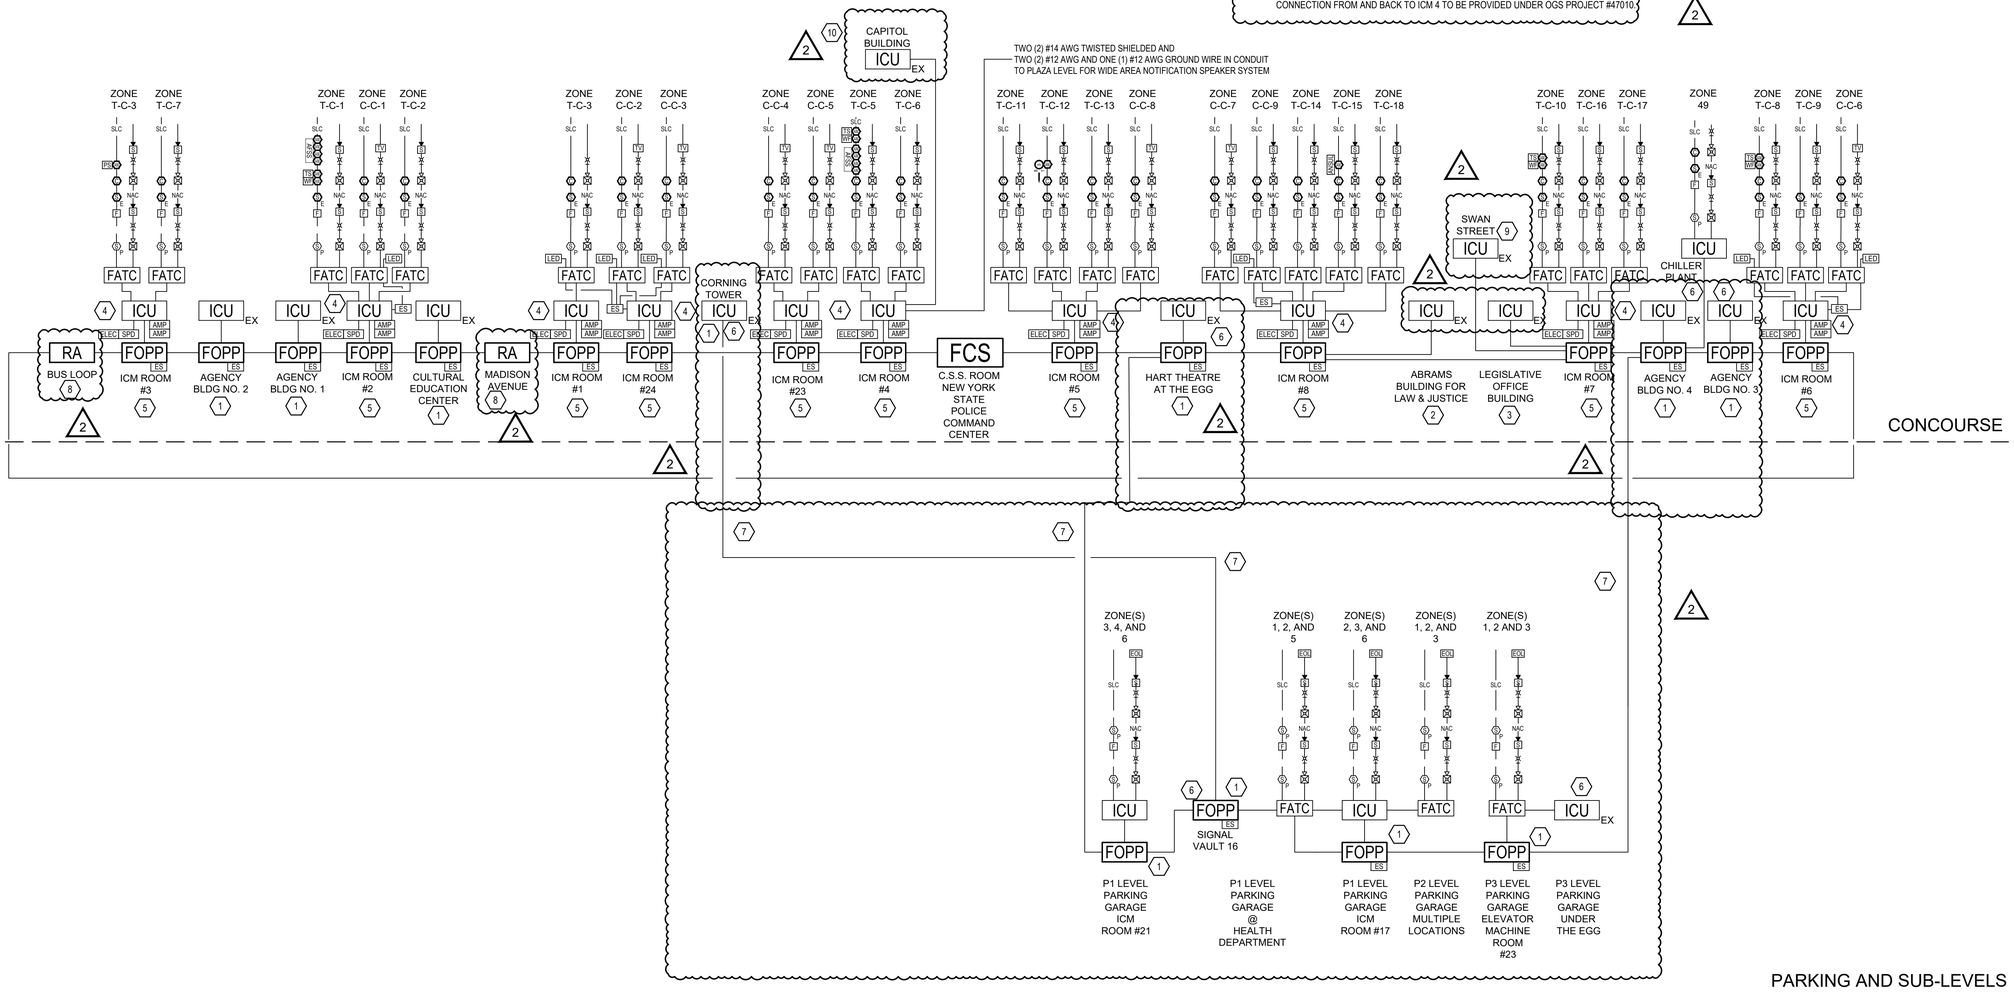

1 ESP SITE-WIDE REPORTING RISER DIAGRAM
SCALE: N.T.S

NEW YORK STATE OF OPPORTUNITY. Office of General Services
DESIGN & CONSTRUCTION

CONSULTANT

CERTIFICATE OF AUTHORIZATION #: 018416

GHD Consulting Services Inc.

WARNING:
THE ALTERATION OF THIS MATERIAL IN ANY WAY, UNLESS DONE UNDER THE DIRECTION OF A COMPARABLE PROFESSIONAL, I.E. ARCHITECT FOR AN ARCHITECT, ENGINEER FOR AN ENGINEER OR LANDSCAPE ARCHITECT FOR A LANDSCAPE ARCHITECT, IS A VIOLATION OF THE NEW YORK STATE EDUCATION LAW AND/OR REGULATIONS AND IS A CLASS 'A' MISDEMEANOR.

STATE OF NEW YORK · ROBERT T. KOVACS · 077708 · LICENSED PROFESSIONAL ENGINEER
REGISTRATION EXPIRES: 06/30/2026

CONTRACT:
ELECTRICAL

TITLE:
PROVIDE FIRE ALARM AND EMERGENCY VOICE EVACUATION

LOCATION:
MAIN PLATFORM
EMPIRE STATE PLAZA
ALBANY, NY

CLIENT:
OGS REAL PROPERTY MANAGEMENT

MARK	DATE	DESCRIPTION
2	04/24/2025	ADDENDUM 1
1	08/30/2024	BID DOCUMENTS


PROJECT NUMBER:	44782 – E
DESIGNED BY:	RTK
DRAWN BY:	BJW
FIELD CHECK:	RGW
APPROVED:	RTK

SHEET TITLE:
ESP SITE-WIDE REPORTING RISER DIAGRAM

DRAWING NUMBER:
F-C-601

SHEET 30 OF 137

Apr. 23,2025 – 2:24pm
\\ghdnet\ghd\US\Cozenovia\Projects\564\126390541\Digital_Design\ACAD\Sheets\F-C-601 – Addendum 1.dwg
36x24 PLOT SHEET

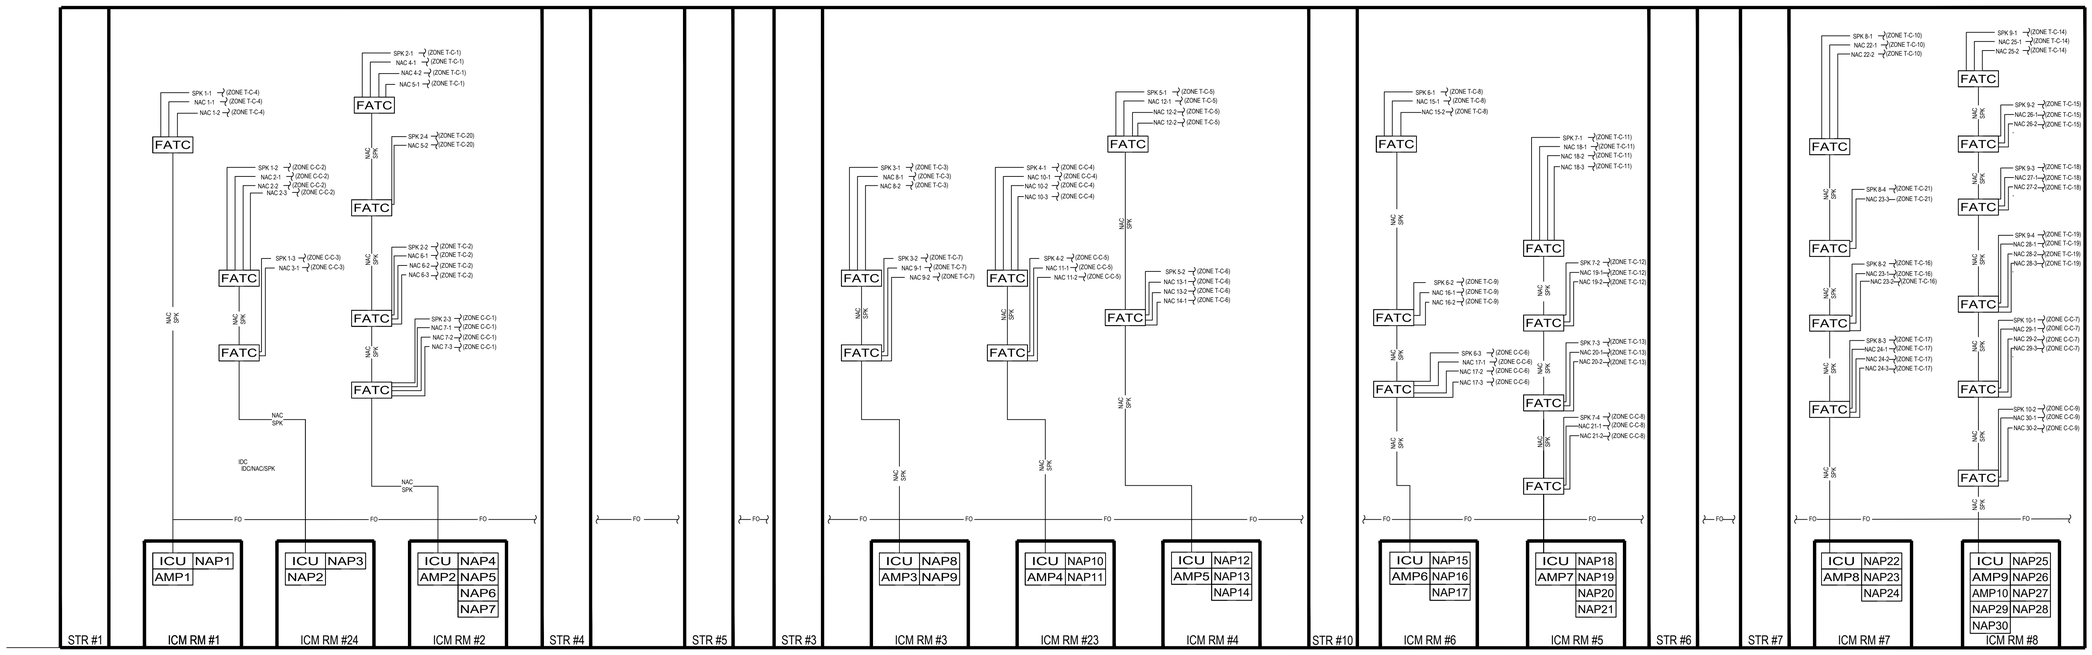

1 CONCOURSE LEVEL RISER DIAGRAM

SCALE: NONE

All Fire Alarm and Emergency Communication Circuits shall be Supervised as Follows

Network SLC	Class A, 2 Hour Rated
Low Level Voice Buss	Class A, 2 Hour Rated
Signaling Line Circuit (SLC)	Class A
Initiating Device Circuit (IDC)	Class B
Audio Notification Speaker (NAC)	Class A
Visual Strobe Circuit (NAC)	Class A
Control	Class B
All Risers (including from Riser to panels on floors)	Class A, 2 Hour Rated

2 PARKING GARAGE CIRCUIT SCHEDULE

SCALE: NONE

CONDUIT SCHEDULE	
CONDUIT TYPE	LOCATION CONDUIT UTILIZED
RIGID GALVANIZED STEEL (RGS)	VERTICAL RISERS
ELECTRICAL METALLIC TUBING (EMT)	EXPOSED UNFINISHED AREAS
SURFACE RACEWAY	EXPOSED FINISHED AREAS
FLEXIBLE LIQUID TIGHT	WET ARE CONNECTIONS
NONE	CONCEALED

NOTES: CONDUITS SHALL BE MINIMUM 3/4" UNLESS OTHERWISE NOTED (UON)

3 PARKING GARAGE CONDUIT SCHEDULE

SCALE: NONE

CONDUCTOR/WIRE SCHEDULE	
CIRCUIT TYPE	NUMBER AND TYPE OF CONDUCTOR
NAC STROBE (NAC)	2-#12 FPLP WIRE
NAC SPEAKER (SPK)	2-#18 TWISTED SHIELDED PAIR FPLP WIRE
24 VDC AUX POWER (PWR)	2-#12 FPLP WIRE
NETWORK TO ICM ROOM (FO)	TYPE LAN-O 6-STRAND OPTICAL FIBER CABLE
NETWORK ICU'S TO ICU'S 7 ICU'S TO FACT'S (IDC)	CIRCUIT INTEGRITY WIRE (CI)
SIGNALING LINE CIRCUIT (SLC)	2-#16 TWISTED PAIR - UNSHIELDED WIRE
REMOTE ANNUNCIATOR (RA)	TYPE LAN-O 6-STRAND OPTICAL FIBER CABLE AND TWO NO. 12 AWG, THHN/THWN, 600 VAC INSULATED CONDUCTORS, WITH ONE NO. 12 AWG EQUIPMENT GROUND WIRE
LED SIGN COMMUNICATION AND POWER	2-#12 FPLP WIRE

2

4 PARKING GARAGE CONDUCTOR/WIRE SCHEDULE

SCALE: NONE

SHEET GENERAL NOTES

1. NOT ALL DEVICES AND EQUIPMENT SHOWN. REFER TO PLAN DRAWINGS FOR EXACT QUANTITIES OF EQUIPMENT TO PROVIDE.
2. FOR EACH CONTROL UNIT ENCLOSURE AND NAP POWER SUPPLY PROVIDE A 120 VAC, 20 AMP, 1 POLE CIRCUIT INCLUDING 200 FEET OF TWO (2) NO. 12 AWG, THHN/THWN, 600 VAC INSULATED CONDUCTORS, WITH ONE (1) NO. 12 AWG EQUIPMENT GROUND. COORDINATE WITH OWNER FOR CONNECTION TO EXISTING 120 VAC DISTRIBUTION PANEL. PROVIDE COMPATIBLE 20 AMP, 22,000 AIC CIRCUIT BREAKER TO MATCH DISTRIBUTION PANEL SPECIFICATIONS. PROVIDE LOCKABLE BREAKER, RED IN COLOR.

NEW YORK STATE OF OPPORTUNITY. Office of General Services

DESIGN & CONSTRUCTION

CONSULTANT

CERTIFICATE OF AUTHORIZATION #: 018416

GHD Consulting Services Inc.

WARNING:

THE ALTERATION OF THIS MATERIAL IN ANY WAY, UNLESS DONE UNDER THE DIRECTION OF A COMPARABLE PROFESSIONAL, I.E. ARCHITECT FOR AN ARCHITECT, ENGINEER FOR AN ENGINEER OR LANDSCAPE ARCHITECT FOR A LANDSCAPE ARCHITECT, IS A VIOLATION OF THE NEW YORK STATE EDUCATION LAW AND/OR REGULATIONS AND IS A CLASS 'A' MISDEMEANOR.

STATE OF NEW YORK · ROBERT T. KOVACS · LICENSED PROFESSIONAL ENGINEER · 077706

REGISTRATION EXPIRES: 06/30/2026

CONTRACT:

ELECTRICAL

TITLE:

PROVIDE FIRE ALARM AND EMERGENCY VOICE EVACUATION

LOCATION:

MAIN PLATFORM
EMPIRE STATE PLAZA
ALBANY, NY

CLIENT:

OGS REAL PROPERTY MANAGEMENT

MARK	DATE	DESCRIPTION
2	04/24/2025	ADDENDUM 1
1	08/30/2024	BID DOCUMENTS

PROJECT NUMBER:	44782 – E
DESIGNED BY:	RTK
DRAWN BY:	BJW
FIELD CHECK:	RGW
APPROVED:	RTK

SHEET TITLE:


CONCOURSE LEVEL RISER DIAGRAM

DRAWING NUMBER:

F-C-604

SHEET 33 OF 137

Apr 23,2025 – 2:24pm
\\ghdnet\ghd\US\Cazenovia\Projects\64\12639064\Digital_Design\ACAD\Sheets\F-C-604 – Addendum 1.dwg
36x24 PLOT SHEET

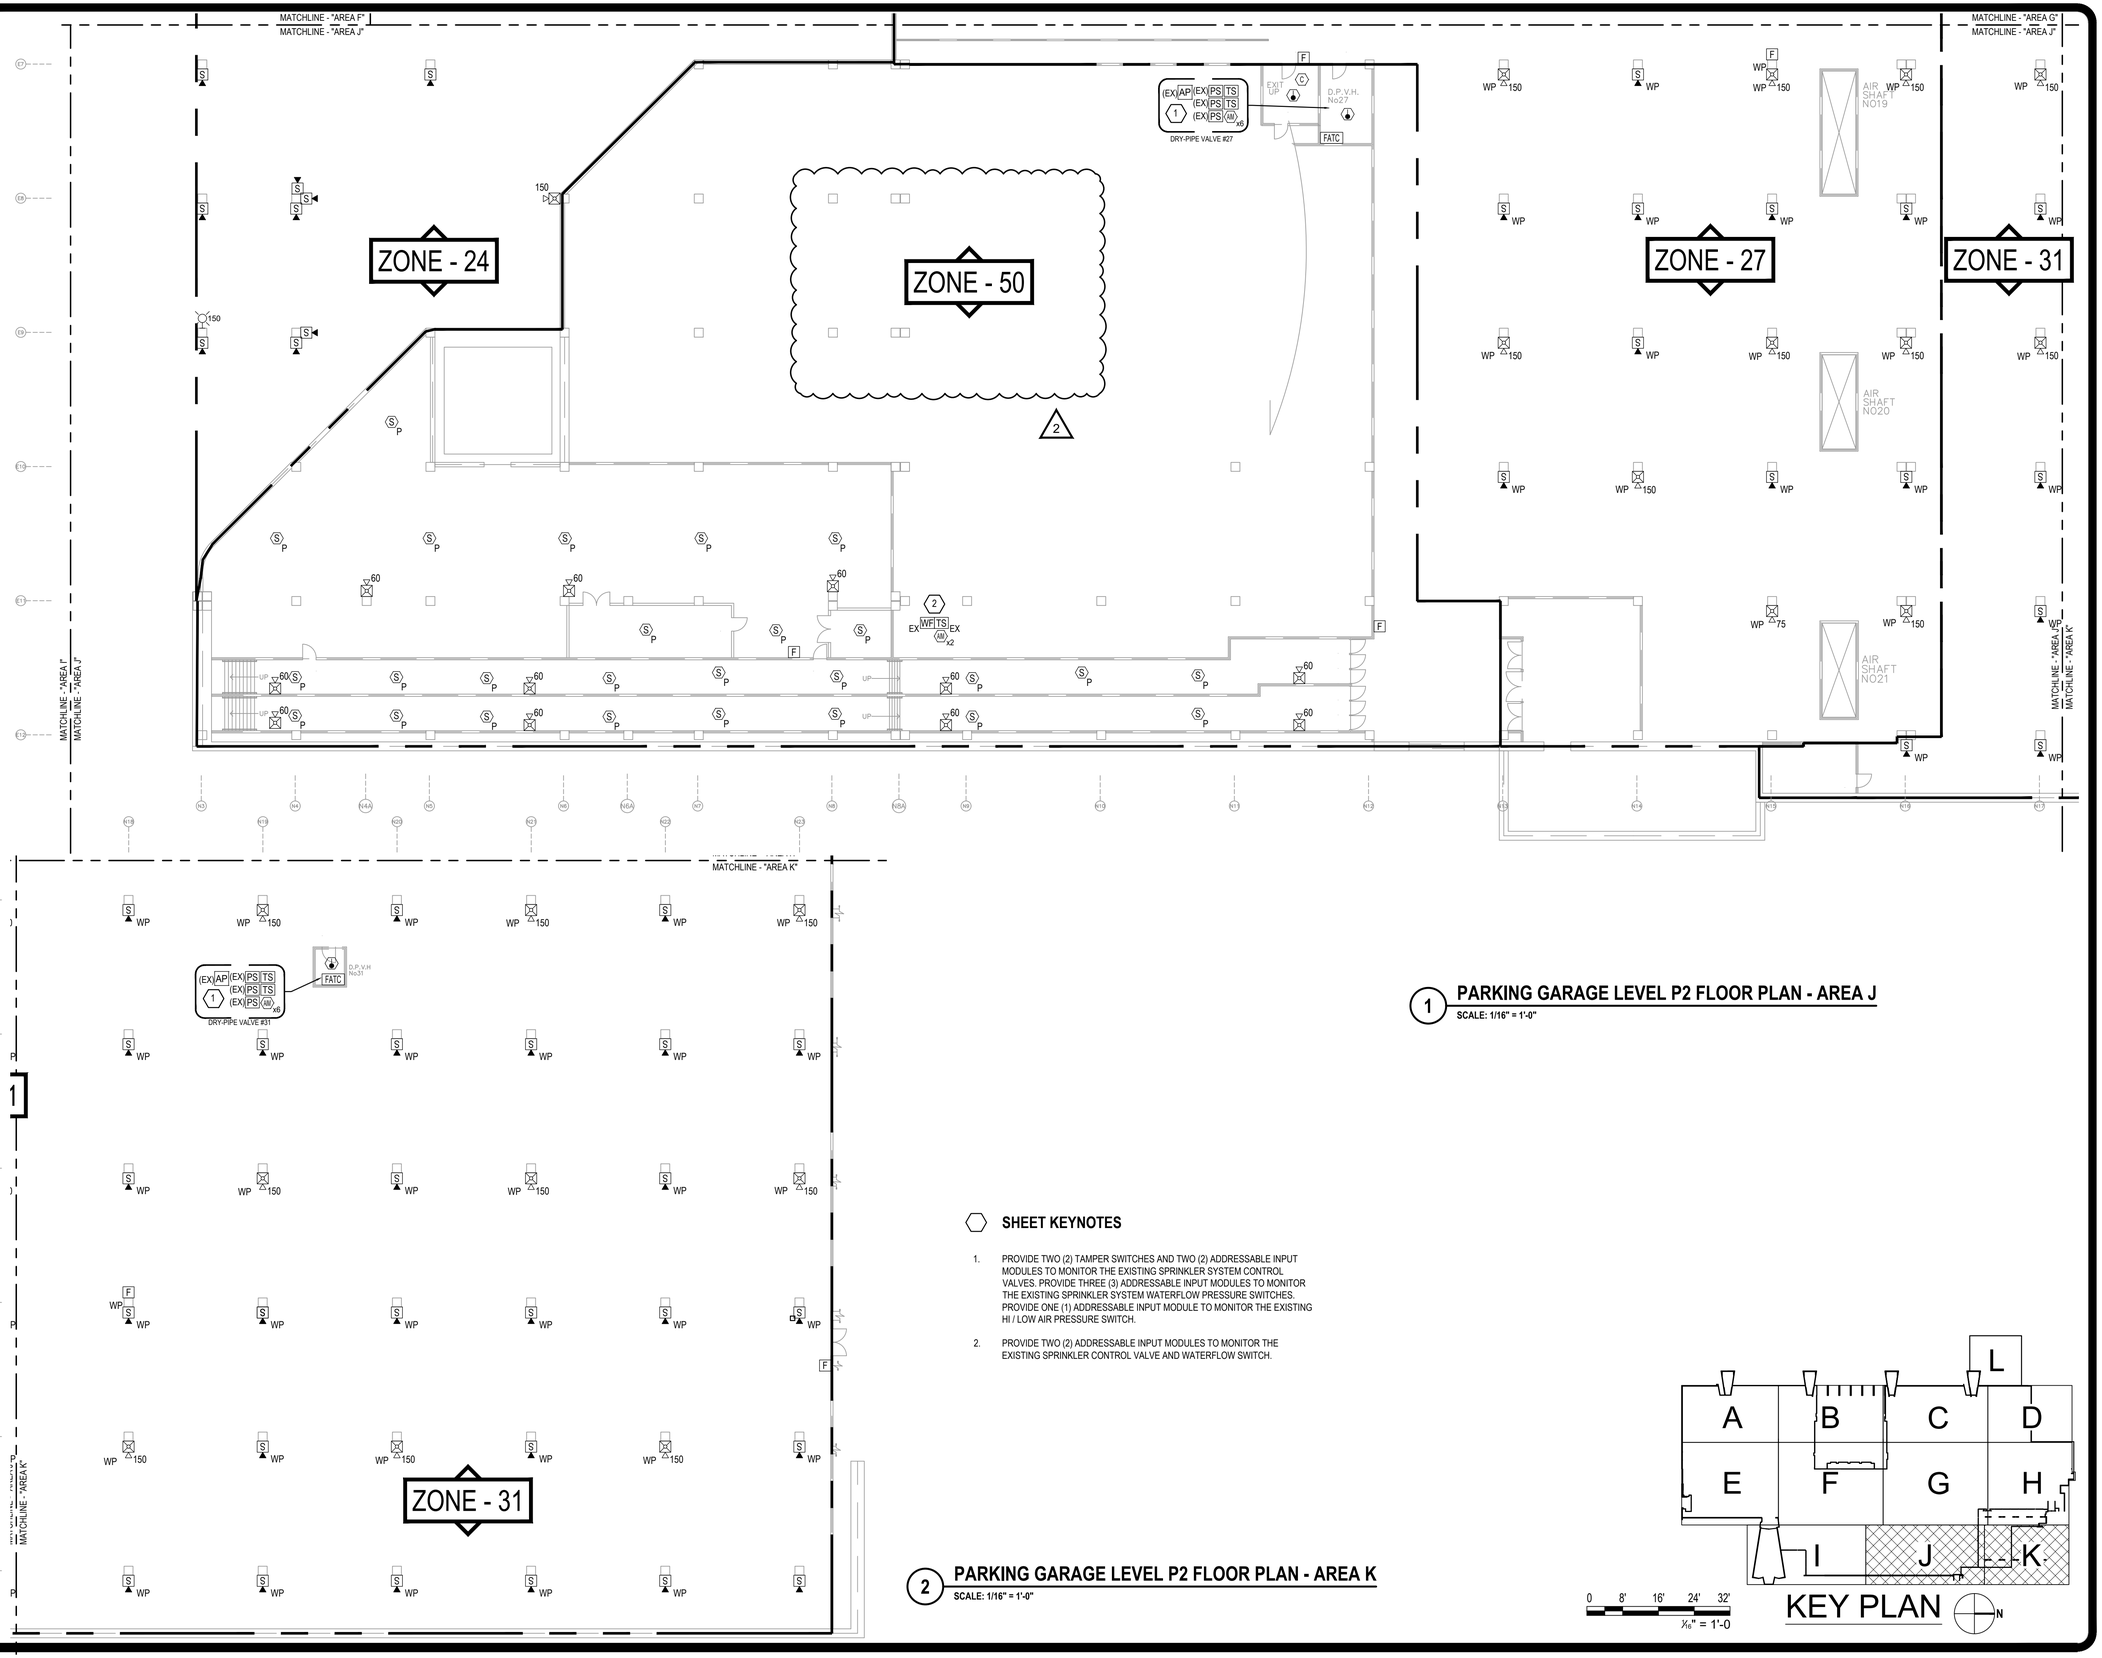

1 PARKING GARAGE LEVEL P2 FLOOR PLAN - AREA J

SCALE: 1/16" = 1'-0"

2 PARKING GARAGE LEVEL P2 FLOOR PLAN - AREA K

SCALE: 1/16" = 1'-0"

SHEET KEYNOTES

1. PROVIDE TWO (2) TAMPER SWITCHES AND TWO (2) ADDRESSABLE INPUT MODULES TO MONITOR THE EXISTING SPRINKLER SYSTEM CONTROL VALVES. PROVIDE THREE (3) ADDRESSABLE INPUT MODULES TO MONITOR THE EXISTING SPRINKLER SYSTEM WATERFLOW PRESSURE SWITCHES. PROVIDE ONE (1) ADDRESSABLE INPUT MODULE TO MONITOR THE EXISTING HI / LOW AIR PRESSURE SWITCH.
2. PROVIDE TWO (2) ADDRESSABLE INPUT MODULES TO MONITOR THE EXISTING SPRINKLER CONTROL VALVE AND WATERFLOW SWITCH.

0 8' 16' 24' 32'
1/16" = 1'-0

NEW YORK STATE OF OPPORTUNITY. Office of General Services
DESIGN & CONSTRUCTION

CONSULTANT

CERTIFICATE OF AUTHORIZATION #: 018416

GHD
GHD Consulting Services Inc.

WARNING:
THE ALTERATION OF THIS MATERIAL IN ANY WAY, UNLESS DONE UNDER THE DIRECTION OF A COMPARABLE PROFESSIONAL, I.E. ARCHITECT FOR AN ARCHITECT, ENGINEER FOR AN ENGINEER OR LANDSCAPE ARCHITECT FOR A LANDSCAPE ARCHITECT, IS A VIOLATION OF THE NEW YORK STATE EDUCATION LAW AND/OR REGULATIONS AND IS A CLASS 'A' MISDEMEANOR.

STATE OF NEW YORK · ROBERT T. KOVACS · LICENSED PROFESSIONAL ENGINEER · 077706

REGISTRATION EXPIRES: 06/30/2026

CONTRACT:
ELECTRICAL

TITLE:
PROVIDE FIRE ALARM AND EMERGENCY VOICE EVACUATION

LOCATION:
MAIN PLATFORM
EMPIRE STATE PLAZA
ALBANY, NY

CLIENT:
OGS REAL PROPERTY MANAGEMENT

MARK	DATE	DESCRIPTION
2	04/24/2025	ADDENDUM 1
1	08/30/2024	BID DOCUMENTS

PROJECT NUMBER:	44782 – E
DESIGNED BY:	RTK
DRAWN BY:	BJW
FIELD CHECK:	RGW
APPROVED:	RTK

SHEET TITLE:
PARKING GARAGE LEVEL P2 AREA J AND K FLOOR PLAN


DRAWING NUMBER:
F-P-131

SHEET 106 OF 137

Apr 23,2025 – 2:22pm
\\ghdnet\ghd\US\Cazenovia\Projects\564\12639054\Digital_Design\ACAD\Sheets\F-P-131 – Addendum 1.dwg
36x24 PLOT SHEET

SHEET GENERAL NOTES

1. FIRE ALARM NOTIFICATION ZONES CORRESPOND TO CURRENT FIRE SUPPRESSION SPRINKLER ZONES.
2. EACH FIRE ALARM NOTIFICATION ZONE IS TO BE PROVIDED NOTIFICATION CIRCUITS AND SPEAKER CIRCUITS INDEPENDENT OF OTHER FIRE ALARM NOTIFICATION ZONES. REFER TO SHEET F-P-607 FOR THE FIRE ALARM RISER WIRING DIAGRAM.

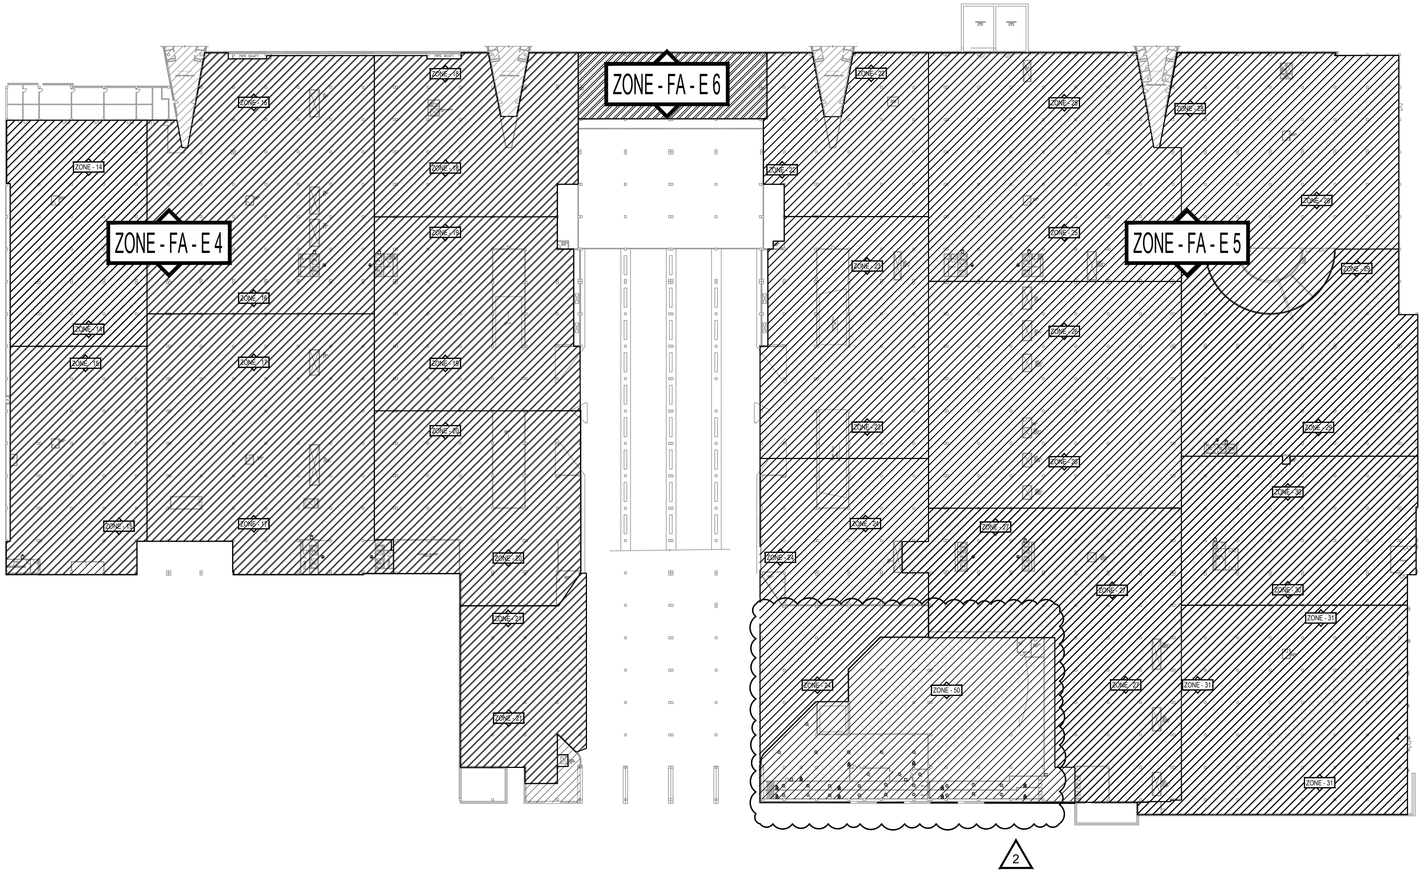

1 **PARKING GARAGE LEVEL P2 NOTIFICATION ZONES**
SCALE: N.T.S

NEW YORK STATE OF OPPORTUNITY. Office of General Services
DESIGN & CONSTRUCTION

CONSULTANT

CERTIFICATE OF AUTHORIZATION #: 018416

GHD Consulting Services Inc.

WARNING:
THE ALTERATION OF THIS MATERIAL IN ANY WAY, UNLESS DONE UNDER THE DIRECTION OF A COMPARABLE PROFESSIONAL, I.E. ARCHITECT FOR AN ARCHITECT, ENGINEER FOR AN ENGINEER OR LANDSCAPE ARCHITECT FOR A LANDSCAPE ARCHITECT, IS A VIOLATION OF THE NEW YORK STATE EDUCATION LAW AND/OR REGULATIONS AND IS A CLASS 'A' MISDEMEANOR.

STATE OF NEW YORK · ROBERT T. KOVACS · LICENSED PROFESSIONAL ENGINEER · 077708

REGISTRATION EXPIRES: 06/30/2026

CONTRACT:
ELECTRICAL

TITLE:
PROVIDE FIRE ALARM AND EMERGENCY VOICE EVACUATION

LOCATION:
MAIN PLATFORM
EMPIRE STATE PLAZA
ALBANY, NY

CLIENT:
OGS REAL PROPERTY MANAGEMENT

MARK	DATE	DESCRIPTION
2	04/24/2025	ADDENDUM 1
1	08/30/2024	BID DOCUMENTS

PROJECT NUMBER:	44782 – E
DESIGNED BY:	RTK
DRAWN BY:	BJW
FIELD CHECK:	RGW
APPROVED:	RTK

SHEET TITLE:
PARKING GARAGE
LEVEL P2
NOTIFICATION ZONES


DRAWING NUMBER:
F-P-602

SHEET 131 OF 137

Apr 23,2025 - 2:23pm
\\ghdnet\ghd\US\Cazenovia\Projects\5641\12639054\Digital_Design\ACAD\Sheets\F-P-602 - Addendum 1.dwg
36x24 PLOT SHEET

SHEET GENERAL NOTES

1. FIRE ALARM EVACUATION ZONES CONTAIN MULTIPLE FIRE ALARM NOTIFICATION ZONES. FIRE ALARM EVACUATION ZONE BOUNDARIES COINCIDE WITH FIRE ALARM NOTIFICATION ZONE BOUNDARIES.

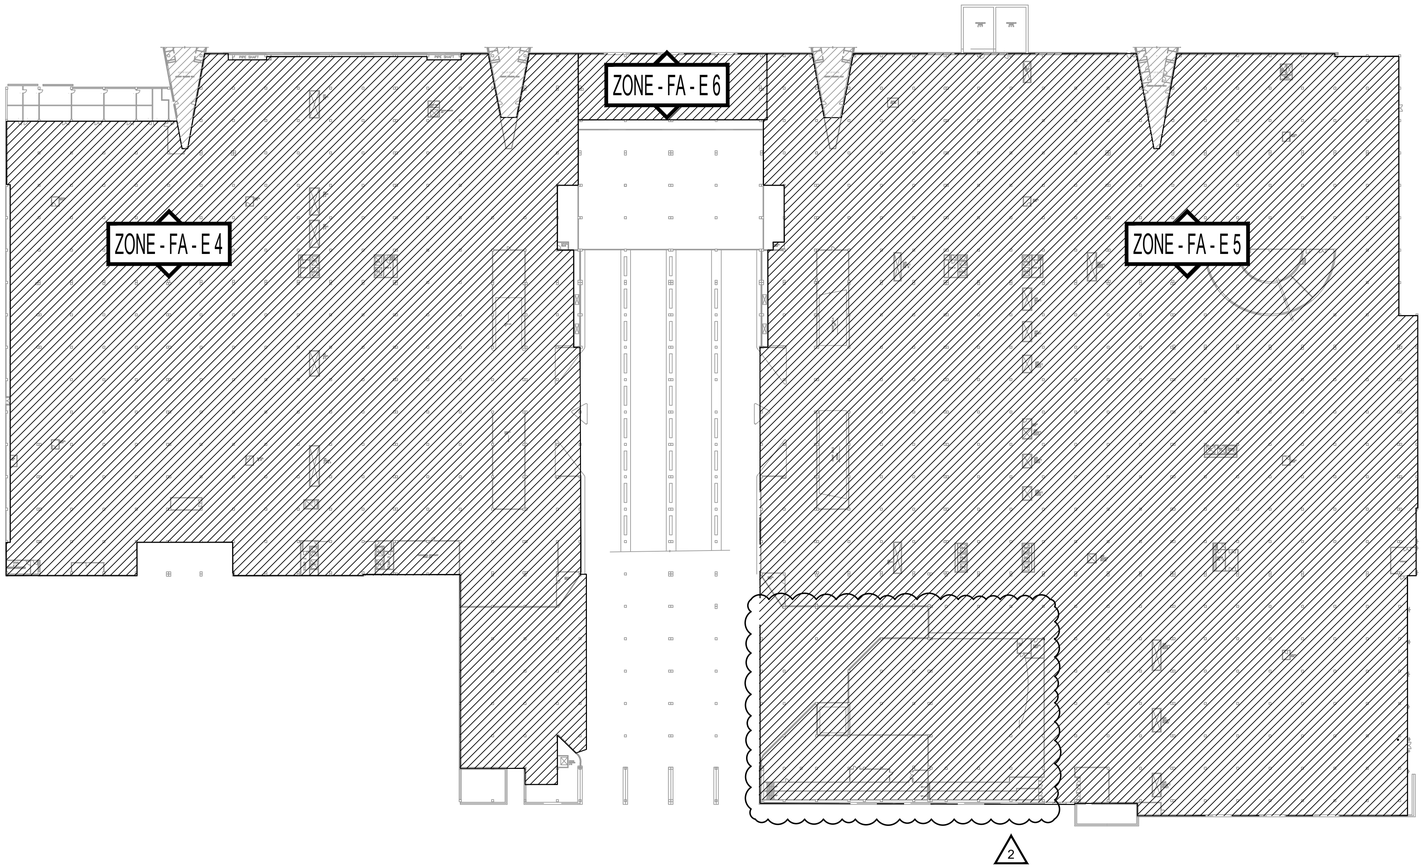

1 **PARKING GARAGE LEVEL P2 EVACUATION ZONES**
SCALE: N.T.S

NEW YORK STATE OF OPPORTUNITY. Office of General Services

DESIGN & CONSTRUCTION

CONSULTANT

CERTIFICATE OF AUTHORIZATION #: 018416

GHD

GHD Consulting Services Inc.

WARNING:
THE ALTERATION OF THIS MATERIAL IN ANY WAY, UNLESS DONE UNDER THE DIRECTION OF A COMPARABLE PROFESSIONAL, I.E. ARCHITECT FOR AN ARCHITECT, ENGINEER FOR AN ENGINEER OR LANDSCAPE ARCHITECT FOR A LANDSCAPE ARCHITECT, IS A VIOLATION OF THE NEW YORK STATE EDUCATION LAW AND/OR REGULATIONS AND IS A CLASS 'A' MISDEMEANOR.

STATE OF NEW YORK · ROBERT T. KOVACS · 077706 · LICENSED PROFESSIONAL ENGINEER

REGISTRATION EXPIRES: 06/30/2026

CONTRACT:
ELECTRICAL

TITLE:
PROVIDE FIRE ALARM AND EMERGENCY VOICE EVACUATION

LOCATION:
MAIN PLATFORM
EMPIRE STATE PLAZA
ALBANY, NY

CLIENT:
OGS REAL PROPERTY MANAGEMENT

MARK	DATE	DESCRIPTION
2	04/24/2025	ADDENDUM 1
1	08/30/2024	BID DOCUMENTS


PROJECT NUMBER:	44782 – E
DESIGNED BY:	RTK
DRAWN BY:	BJW
FIELD CHECK:	RGW
APPROVED:	RTK

SHEET TITLE:
PARKING GARAGE LEVEL P2 EVACUATION ZONES

DRAWING NUMBER:
F-P-605

SHEET 134 OF 137

Apr 23,2025 - 2:23pm
\\ghdnet\ghd\US\Cazenovia\Projects\5641\12639054\Digital_Design\ACAD\Sheets\F-P-605 - Addendum 1.dwg
36x24 PLOT SHEET

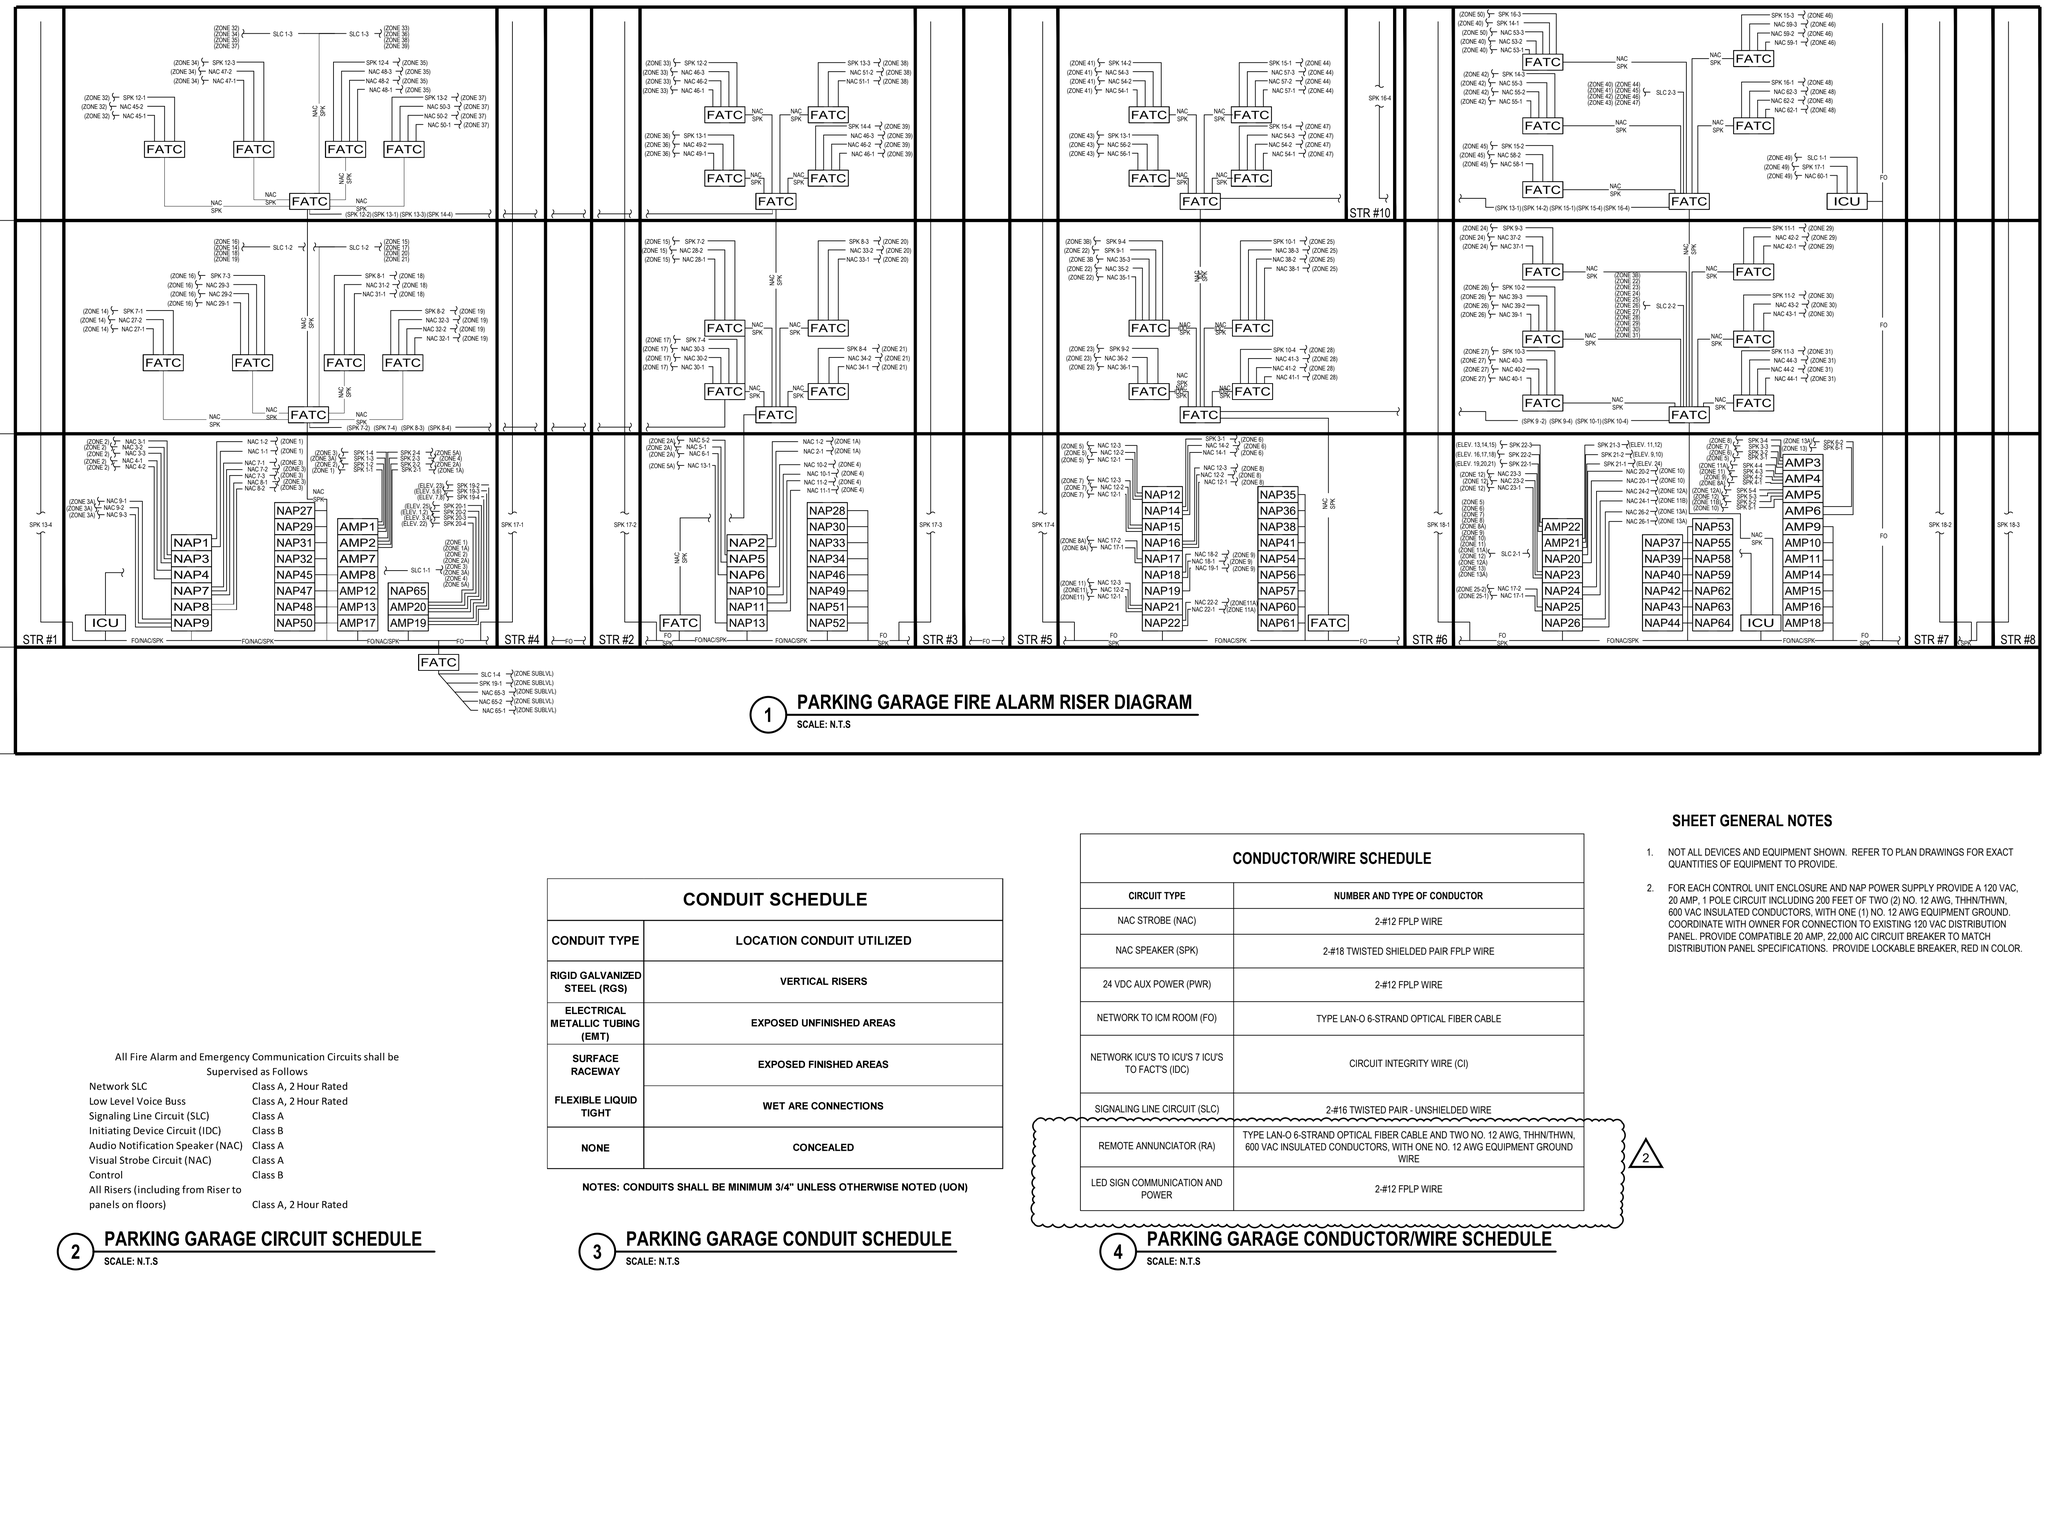

1 PARKING GARAGE FIRE ALARM RISER DIAGRAM

SCALE: N.T.S

All Fire Alarm and Emergency Communication Circuits shall be Supervised as Follows

Network SLC	Class A, 2 Hour Rated
Low Level Voice Buss	Class A, 2 Hour Rated
Signaling Line Circuit (SLC)	Class A
Initiating Device Circuit (IDC)	Class B
Audio Notification Speaker (NAC)	Class A
Visual Strobe Circuit (NAC)	Class A
Control	Class B
All Risers (including from Riser to panels on floors)	Class A, 2 Hour Rated

2 PARKING GARAGE CIRCUIT SCHEDULE

SCALE: N.T.S

CONDUIT SCHEDULE	
CONDUIT TYPE	LOCATION CONDUIT UTILIZED
RIGID GALVANIZED STEEL (RGS)	VERTICAL RISERS
ELECTRICAL METALLIC TUBING (EMT)	EXPOSED UNFINISHED AREAS
SURFACE RACEWAY	EXPOSED FINISHED AREAS
FLEXIBLE LIQUID TIGHT	WET ARE CONNECTIONS
NONE	CONCEALED

NOTES: CONDUITS SHALL BE MINIMUM 3/4" UNLESS OTHERWISE NOTED (UON)

3 PARKING GARAGE CONDUIT SCHEDULE

SCALE: N.T.S

CONDUCTOR/WIRE SCHEDULE	
CIRCUIT TYPE	NUMBER AND TYPE OF CONDUCTOR
NAC STROBE (NAC)	2-#12 FPLP WIRE
NAC SPEAKER (SPK)	2-#18 TWISTED SHIELDED PAIR FPLP WIRE
24 VDC AUX POWER (PWR)	2-#12 FPLP WIRE
NETWORK TO ICM ROOM (FO)	TYPE LAN-O 6-STRAND OPTICAL FIBER CABLE
NETWORK ICU'S TO ICU'S 7 ICU'S TO FACT'S (IDC)	CIRCUIT INTEGRITY WIRE (CI)
SIGNALING LINE CIRCUIT (SLC)	2-#16 TWISTED PAIR - UNSHIELDED WIRE
REMOTE ANNUNCIATOR (RA)	TYPE LAN-O 6-STRAND OPTICAL FIBER CABLE AND TWO NO. 12 AWG, THHN/THWN, 600 VAC INSULATED CONDUCTORS, WITH ONE NO. 12 AWG EQUIPMENT GROUND WIRE
LED SIGN COMMUNICATION AND POWER	2-#12 FPLP WIRE

2

4 PARKING GARAGE CONDUCTOR/WIRE SCHEDULE

SCALE: N.T.S

SHEET GENERAL NOTES

1. NOT ALL DEVICES AND EQUIPMENT SHOWN. REFER TO PLAN DRAWINGS FOR EXACT QUANTITIES OF EQUIPMENT TO PROVIDE.
2. FOR EACH CONTROL UNIT ENCLOSURE AND NAP POWER SUPPLY PROVIDE A 120 VAC, 20 AMP, 1 POLE CIRCUIT INCLUDING 200 FEET OF TWO (2) NO. 12 AWG, THHN/THWN, 600 VAC INSULATED CONDUCTORS, WITH ONE (1) NO. 12 AWG EQUIPMENT GROUND. COORDINATE WITH OWNER FOR CONNECTION TO EXISTING 120 VAC DISTRIBUTION PANEL. PROVIDE COMPATIBLE 20 AMP, 22,000 AIC CIRCUIT BREAKER TO MATCH DISTRIBUTION PANEL SPECIFICATIONS. PROVIDE LOCKABLE BREAKER, RED IN COLOR.

NEW YORK STATE OF OPPORTUNITY. Office of General Services

DESIGN & CONSTRUCTION

CONSULTANT

CERTIFICATE OF AUTHORIZATION #: 018416

GHD Consulting Services Inc.

WARNING:
THE ALTERATION OF THIS MATERIAL IN ANY WAY, UNLESS DONE UNDER THE DIRECTION OF A COMPARABLE PROFESSIONAL, I.E. ARCHITECT FOR AN ARCHITECT, ENGINEER FOR AN ENGINEER OR LANDSCAPE ARCHITECT FOR A LANDSCAPE ARCHITECT, IS A VIOLATION OF THE NEW YORK STATE EDUCATION LAW AND/OR REGULATIONS AND IS A CLASS 'A' MISDEMEANOR.

STATE OF NEW YORK · ROBERT T. KOVACS · 077706 · LICENSED PROFESSIONAL ENGINEER

REGISTRATION EXPIRES: 06/30/2026

CONTRACT: ELECTRICAL

TITLE: PROVIDE FIRE ALARM AND EMERGENCY VOICE EVACUATION

LOCATION: MAIN PLATFORM EMPIRE STATE PLAZA ALBANY, NY

CLIENT: OGS REAL PROPERTY MANAGEMENT

MARK	DATE	DESCRIPTION
2	04/24/2025	ADDENDUM 1
1	08/30/2024	BID DOCUMENTS

PROJECT NUMBER:	44782 – E
DESIGNED BY:	RTK
DRAWN BY:	BJW
FIELD CHECK:	RGW
APPROVED:	RTK

SHEET TITLE: PARKING GARAGE RISER DIAGRAMS

DRAWING NUMBER: F-P-607

SHEET 136 OF 137

Apr 23,2025 – 2:26pm
\\ghdnet\ghd\US\Cazenovia\Projects\564\12639054\Digital_Design\ACAD\Sheets\F-P-607 – Addendum 1.dwg
36x24 PLOT SHEET

GENERAL NOTES

1. PROVIDE LIGHTWEIGHT CONCRETE FIRE STOPPING SAFE THICKNESS AS ADJOINING SLAB TO FILL VOIDS BETWEEN FLOOR OPENING AND METAL DUCTS AND/OR PIPING AT THE TOP AND BOTTOM OF ALL SHAFTS.
2. FURR WITH CHANNELS, WIRE LATH AND PLASTER ALL VERTICAL AND HORIZONTAL PIPING AND DUCTS WHICH ARE EXPOSED IN AREAS THAT ARE PLASTERED UNLESS SHOWN TO BE FURRED WITH MASONRY.
3. ANY DUCT WORK PASSING THROUGH STAIRS SHALL BE WRAPPED WITH CHANNELS, WIRE LATH AND VERMICULITE PLASTER TO PRODUCE A TWO (2) HOUR FIRE PROTECTION PLUS NECESSARY AUTOMATIC FIRE DAMPERS IN THE DUCTS.
4. ALL PARTITIONS ENCLOSING STAIRWAYS, HOISTWAYS, SHAFTS, MECHANICAL ROOMS, ELECTRIC CLOSETS, AND CORRIDORS FORMING MEANS OF EGRESS SHALL HAVE A TWO (2) HOUR FIRE RATING.
5. ENCLOSE IN CONCRETE FIRE PROOFING OF COLUMNS, ALL VERTICAL PIPING IN THE ARTERIAL ROAD COLUMN LINES E-4 TO N-4 AND ALSO IN CONCOURSE V.I.P. PARKING.

44782 ADDENDUM REFERENCE DRAWING SET 1

LEGEND :

- EARTH ETC.
- ROCK
- CONCRETE
- INSULATION FILL
- HEAVYWEIGHT CONCRETE BLOCK
- CONCRETE BLOCK
- PRECAST PLANK
- FLOOR FILL CEMENT
- STEEL
- ALUMINUM
- STAINLESS STEEL
- BRICK
- STRUCT. FACING (HEAVY LINE INDICATES EL. SIDE)
- CUT STONE
- RUBBLE STONE
- CAST STONE
- MARBLE
- GLASS
- GLASS (SMALL SCALE)
- WOOD
- PLASTIC ON PLYWOOD
- PREMOULDED FILLER
- CLOSED CELL NEOPRENE
- INSULATION
- RIGID FIBER BOARD
- VITREOUS TILE
- TERRAZZO
- ACOUSTICAL TILE
- INDUSTRIAL LATEX
- ASBESTOS BOARD
- MET. LATH-FURRING
- PLASTER (LARGE SCALE)
- SOLID PLASTER PARTITION
- BUILT UP ROOFING
- LEAD LINING
- CAULKING
- BRONZE

ABBREVIATIONS

- A.D. — ACCESS DOOR
- C.I. — CAST IRON
- CONC. — CONCRETE
- D.F. — DRINKING FOUNTAIN
- EL. — ELEVATION
- ELEV. — ELEVATOR
- F.D. — FLOOR DRAIN
- F.H.C. — FIRE HOSE CABINET
- F.S.P. — FIRE STAND-PIPE
- F.P.D.C. — FIRE-PROOF SELF CLOSING
- H.M. — HOLLOW METAL
- I.D. — INSIDE DIAMETER
- N.T.S. — NOT TO SCALE
- P.S. — PIER STATION
- V.B. — VAPOR BARRIER
- J.T. FILLER — JOINT FILLER
- E.O.G. — EDGE OF GLASS
- L.P. — LOW PARTITION (MASONRY) STOPPING 4" ABOVE F.H. CEILING
- BZ. — BRONZE
- B.E. — BAKED ENAMEL
- L.T. — LIGHT
- M.E.R. — MECHANICAL EQUIPMENT ROOM
- M.O. — MASONRY OPENING
- N.I.C. — NOT IN CONTRACT
- O.D. — OUTSIDE DIAMETER
- P. — PAINT
- S.C. — SELF CLOSING
- S. ST. — STAINLESS STEEL
- ST. STEEL
- S.D. — SOAP DISPENSER
- ST. FL. — STEEL PLATES
- SUPV. — SUPERVISOR
- U.C. — UNDER CUT
- W.P. — WORKING POINT OR WATERPROOFING
- R.D. — ROAD DRAIN
- M.H. — MANHOLE
- C.B. — CATCH BASIN
- H.W. — HEAVY WEIGHT CONC. BLOCK
- T.W. — TOP OF WALL

INTERIOR FINISH SCHEDULE

SPACE FIN. NO.	FLOOR MATERIAL	BASE MATERIAL	HEIGHT	WAINSCOT MATERIAL	SIM	WALLS MATERIAL	SIM	CEILING MATERIAL	SIM	REMARKS
F-1	CONCRETE WITH COLORED FLOOR HARDNER					CONCRETE & CONC. BLOCK	PAINT	CONCRETE	PAINT	7'-0" HIGH CONC. WALL UNDER ALL MASONRY WALLS AT 2nd & 3rd LEVELS. 3'-3" HIGH CONC. WALL AT 100'-0" LEVEL
F-2	CONCRETE WITH COLORED FLOOR HARDNER	CEMENT BASE PAINTED (WHERE EXPOSED)	6"			CONCRETE & CONC. BLOCK	PAINT	CONCRETE	PAINT	PROVIDE LIQUID [illegible] ON CONCOURSE LEVEL (AS NOTED N.M.A.D.)
F-3	CONCRETE WITH COLORED FLOOR HARDNER					CONCRETE & CONC. BLOCK	PAINT	CONCRETE	PAINT	CEMENT RING AT TREADS & INTERMEDIATE LANDINGS. METAL SUPPORTS, STRINGERS & HANDRAILS TO BE PAINTED
F-4	CONCRETE & 1" CEM. W.P.	CEMENT-WP. PAINTED	6"	KEENE CEMENT PLASTER-7"-15"	PAINT	SUSPENDED CEMENT PLASTER - 5'-0" HIGH	PAINT	INSULATED FLOODLIGHTS & CEILINGS		
F-5	CEMENT FIN. WITH COLORED FLOOR HARDNER					CONCRETE & CONC. BLOCK	PAINT	SUSPENDED ACOUSTIC TILE, EXPOSED T SYSTEM		8" CONC. BASE UNDER LOCKERS
F-6	CONCRETE & 1" CEM. W.P.	CEMENT-WP. PAINTED	6"	KEENE CEMENT PLASTER-7"-15"	PAINT	CONCRETE & CONC. BLOCK	PAINT	CONCRETE	PAINT	
F-7	CEMENT FIN.					CONCRETE & CONC. BLOCK		CONCRETE		UNFINISHED - SEE NOTE No. 5 AND NT 10
F-8	CONCRETE WITH COLORED FLOOR HARDNER	CEMENT PAINTED	4"			CEMENT PLASTER	PAINT	SUSPENDED CEMENT PLAS.	PAINT	ARCHITECTURAL FIN. CONCRETE ON FACES OF RAMP, FOR TERMINATION SEE DWG. G4/4-57
F-9	CONCRETE WITH COLORED FLOOR HARDNER					STRUC. GLAZED TILE & POL. PL. GL.	PAINT	CONC. & SUSP. CEMENT PLAS.	PAINT	
F-10	LATEX	LATEX	4"			CONCRETE & CONC. BLOCK	PAINT	SUSPENDED ACOUSTIC TILE, EXPOSED T SYSTEM	PAINT	4'-0" HIGH SOAPSTONE WAINSCOT AT ROT EXCEPTOR, WHERE SHOWN ON PLANS. METAL PANEL, ACOUSTIC FOAM, WHERE SHOWN ON PLANS. SEE SECTIONS
F-11	LATEX	LATEX	6"			CONCRETE & CONC. BLOCK	PAINT	CONCRETE OR CONCRETE SLAB	PAINT	4'-0" HIGH SOAPSTONE WAINSCOT AT MOD RECEPTOR - GOLD LEVEL ONLY
F-12	LATEX	LATEX	8"			CONCRETE & CONC. BLOCK	PAINT	SUSPENDED CEMENT PLASTER - 8'-0" H.	PAINT	4'-0" HIGH SOAPSTONE WAINSCOT AT MOD RECEPTOR - GOLD LEVEL ONLY
F-13	LATEX	LATEX	4"			STRUC. GLAZED TILE		SUSPENDED PLASTER	PAINT	SEE NOTE No. 7.
F-14	VINYL ASBESTOS	VINYL	4"			CONCRETE & CONC. BLOCK	PAINT	SUSPENDED ACOUSTIC TILE, EXPOSED T SYSTEM		
F-15	VINYL ASBESTOS	RUBBER	4"			PLASTER	PAINT	SUSPENDED ACOUSTIC TILE, EXPOSED T SYSTEM		
F-16	VITREOUS TILE	VITREOUS TILE	2"			PLASTER	PAINT	SUSPENDED PLASTER	PAINT	
F-17	VITREOUS TILE	VITREOUS TILE				VITREOUS TILE		SUSPENDED PLASTER	PAINT	SEE NOTE No. 7
F-18	TERRAZZO	TERRAZZO	4"			PLASTER & POL. PLATE GLASS	PAINT PLAS.	SUSPENDED PLASTER	PAINT	SEE ALSO PLANS FOR LOCATION OF MARBLE ON SOME WALLS.
F-19	TERRAZZO	TERRAZZO	4"			MARBLE		SUSPENDED PLASTER	PAINT	
F-20	TERRAZZO	TERRAZZO	4"			CEMENT PLASTER	PAINT	SUSPENDED CEMENT PLASTER	PAINT	
F-21	LATEX	LATEX COVED	4"			STRUC. GLAZED TILE		SUSP. METAL PAN ELG. (ACOUSTIC PAD)		PERFORATED PANELS EXCEPT AT OVEN AREA.
F-22	TERRAZZO		4"			STRUC. GLAZED TILE		SUSPENDED PLASTER	PAINT	
F-23	CONCRETE WITH COLORED FLOOR HARDNER	CEMENT PAINTED	4"			PLASTER	PAINT	SUSPENDED PLASTER	PAINT	
F-24	CEMENT FIN. CARPET (N.I.C.) WITH COLORED HARDNER	WHITE VINYL	2 3/8"			PLASTER	PAINT	SUSPENDED PLASTER	PAINT	
F-25	TERRAZZO	TERRAZZO	4"			PLASTER	PAINT	SUSPENDED ACOUSTIC TILE CONCEALED T SPLINE SYSTEM		SUSPENDED CEMENT PLASTER CEILING IN LIBU OR AC. TILE @ EXECUTIVE PARKING PLATFORM ONLY
F-26	VINYL ASBESTOS	VINYL	4"			PLASTER	PAINT	SUSPEND ACOUSTIC TILE CONCEALED T SPLINE SYSTEM		
F-27	CEMENT FINISH CARPET (N.I.C.)	WHITE VINYL	2 3/8"			PLASTER	PAINT	SUSPENDED ACOUSTIC TILE ON PLASTER		
F-28	VINYL ASBESTOS	WHITE VINYL	2 3/8"			PLASTER	PAINT	SUSPENDED PLASTER	PAINT	
F-29	LATEX	LATEX	5 1/4"			STRUC. GLAZED TILE & PLASTER		SUSPENDED PLASTER	PAINT	
F-30	CEMENT FIN. W. COLORED HARDNER					STRUC. GLAZED TILE		EXPOSED CONC.	PAINT	
F-31	POLYESTER TERRAZZO	POLYESTER TERRAZZO	5"			PLASTER, AND POL. & GLASS	PAINT PAN	SUSPENDED ACOUSTIC TILE ON GYPSUM BOARD, SEALED (T)& SUSPENDED MOUSTIC		
F-32	POLYESTER TERRAZZO	POLYESTER TERRAZZO	4"	KEENE CEMENT PLASTER 7'-0" HIGH.	PAINT	PLASTER	PAINT	TILE ON PLASTER		
F-33	POLYESTER TERRAZZO	POLYESTER TERRAZZO	5"			STRUCT. GLAZED TILE		SUSP. PLANE-FORMED CLG - SEE REMARKS	PAINT	EXPOSED CLG IN JANITOR CLOS, SEE PLAN. PLASTERED WALLS, SEE PLAN.
F-34	VINYL ASBESTOS	VINYL	2 3/8"			PLASTER	PAINT	SUSP. ACOUSTIC TILE - CONCEALED SYST.		COMPLETE ACCESSIBILITY CEILING - ARMSTRONG TILE SYSTEM.
F-35	POLYESTER TERRAZZO	POLYESTER TERRAZZO	3"			VITREOUS TILE THIN SET		SUSP. PLASTER	PAINT	
F-36	VINYL ASBESTOS	RUBBER	4"			STRUCT. GLAZED TILE.		SUSP. ACOUSTIC TILE EXPOSED SYSTEM		SEE PLAN FOR CONC. BLOCK
F-37	LATEX	LATEX	4"			PLASTER	PAINT	PLASTER	PAINT	PROVIDE "KIPS" ON CONCRETE SURFACES
F-38	LATEX	LATEX				CONC. BLOCK	PAINT	SUSPENDED MET. PAN (ACOUSTIC PADS)		
F-39	CEMENT FINISH CARPET N.I.C.	STRUCT. CLG. VINYL CARPET	SEE DET.			PLASTER	PAINT	SUSP. ACOUSTIC TILE CONCEALED SYSTEM		COMPLETE ACCESSIBILITY CEILING - ARMSTRONG TILE SYSTEM.
F-40	TERRAZZO					CERAMIC TILE		SUSP. ACOUSTIC TILE CONCEALED SYSTEM		COMPLETE ACCESSIBILITY CEILING - ARMSTRONG TILE SYSTEM.
F-41	LATEX	LATEX	4"			PLASTER		SUSPENDED MET. PAN. (ACOUSTIC PADS)		
F-42	CEMENT FINISH CARPET N.I.C.	CARPET ON VINYL CLG.	2 3/8"			PLASTER	PAINT	SUSPENDED PLASTER	PAINT	
F-43	TERRAZZO	LATEX	2 3/8"			2" PLASTER WALLS	PAINT	SUSPENDED PLASTER	PAINT	
F-44	LATEX	LATEX				CERAMIC TILE	—	SUSPENDED MET. PAN. (ACOUSTIC PADS)		
F-45	TERRAZZO					STRUC. GLAZ. TILE		SUSPENDED ACOUSTIC TILE & SPLINE		
F-46	TERRAZZO		—			RUBBLE STONE	—	SUSP. PLASTER	PAINT	COMPLETE ACCESSIBILITY CEILING - ARMSTRONG TILE SYSTEM. PANELS ON WALL & PLASTER CLG.
F-47	CARPET FIN. CEMENT FILL	WHITE VINYL & WOOD	4"			PLASTIC & WOOD SEE REMARKS	PAINT PLAS.	SUSP. ACOUSTIC TILE & PLASTER	PAINT PLAS.	COMPLETE ACCESSIBILITY CEILING - ARMSTRONG TILE SYSTEM. (CARPET ON WALL MISC. RM. G)
F-48	CARPET FIN. W/ WOOD & CEM. FILL	CARPET FIN. W/ VINYL & WOOD	4"			PLASTER & WOOD	PAINT PLAS.	SUSP. ACOUSTIC TILE	PAINT	COMPLETE ACCESSIBILITY CEILING - ARMSTRONG TILE SYSTEM.
F-49	TERRAZZO	TERRAZZO	6"			PLASTER	PAINT	SUSP. ACOUSTIC TILE	PAINT	COMPLETE ACCESSIBILITY CEILING - ARMSTRONG TILE SYSTEM.
F-50	CEM. FIN. WITH COLORED FLOOR HARDNER	WHITE VINYL	4"			PLASTER	PAINT	SUSP. ACOUSTIC TILE	PAINT	COMPLETE ACCESSIBILITY CEILING - ARMSTRONG TILE SYSTEM
F-51	CARPET FIN. W/ CEMENT FILL	WHITE VINYL	4"			PLASTER	PAINT	SUSP. ACOUSTIC TILE	PAINT	COMPLETE ACCESSIBILITY CEILING - ARMSTRONG TILE SYSTEM
F-52	WOOD - SEE DET. SHEET SERIES	WHITE VINYL	4"			CARPET ON PLASTER - SEE DETAILS	PAINT	INSULATION - TRANSITE - SEE DET.	PAINT	CARPET ON WALL IN CONTRACT FOR MISC. RM. G
F-53	CARPET FIN. CEMENT FILL	WHITE VINYL	4"			PLASTER	PAINT	SUSP. ACOUSTIC CLG.	PAINT	COMPLETE ACCESSIBILITY CEILING - ARMSTRONG TILE SYSTEM.
F-54	CEMENT FIN. CARPET N.I.C.	VINYL	4"			PLASTER & POL. PLATE GLASS	PAINT PLAS.	SUSP. PLASTER	PAINT	
F-55	VINYL	VINYL	4"			PLASTER	PAINT	SUSP. ACOUSTIC TILE		COMPLETE ACCESSIBILITY CLG. - ARMSTRONG TILE SYSTEM.
F-56	LATEX	LATEX	4"			STRUCT GLAZ TILES	—	SUSP. ACOUSTIC TILE		
F-57	WOOD	VINYL	3 1/2"			SLIDER WITH ACOUSTIC PANELS	PAINT	SUSP. ACOUSTIC TILE EXP. T SYSTEM		
F-58	LINOLEUM	VINYL	4"			BLOCK	PAINT	CONCRETE	PAINT	
F-59	LINOLEUM	VINYL	4"			SLIDER WITH ACOUSTIC PANELS		SUSP. ACOUSTIC TILE EXP. T SYSTEM		
F-60	VINYL ASBESTOS	VINYL	4"			BLOCK	PAINT	SUSP. ACOUSTIC TILE, PLASTIC FIN.		

NOTES

1. ALL VINYL ASBESTOS FLOOR TILE & RUBBER BASE & CARPET N.I.C. EXCEPT AS NOTED.
2. ALL FINISH PAINTING SHALL BE DONE BY OWNER EXCEPT ITEMS REQUIRING PAINTING THAT ARE BUILT INTO THE STRUCTURE, EXCEPT AS NOTED.
3. MEMBRANE WATER-PROOFING ON SLOPES TO BE TURNED UP AT WALLS & CURB BEHIND CEMENT BASES.
4. ALL FREE-STANDING COLUMNS TO BE PLASTERED IN PLASTERED AREAS EXCEPT WHEN FINISHED IN ARCHITECTURAL CONCRETE AS LISTED ON DWG. G4/4-101.
5. FINISH WALLS & SUSPENDED CEILINGS NOT IN CONTRACT: CONC. INSERTS FOR SUSPENDED CEILINGS, MECH. & ELECTRIC WORK TO BE INSTALLED IN THIS CONTRACT.
6. PROVIDE 3 HOUR EXTRA VERMICULITE PLASTER ON CONC. CUT-OF WALL OR JAMB ABOVE CEILING OVER ALL ROAD WALLS AND GLASS DOORS IN CONCOURSE CORRIDORS INCLUDING GLASS DOORS SUBDIVIDING ONE CORRIDOR FROM ANOTHER. THIS WALL SHALL EXTEND FROM THE SUSP. CEILING TO THE UNDERSIDE OF THE SLAB ABOVE FOLLOWING THE PROFILE OF THE CONC. COFFERS.
7. ALL TOILET STALL PARTITIONS SHALL BE METAL CEILING HUNG TYPE.
8. CONC. INSERTS IN SLAB FOR MECHANICAL & ELECTRIC WORKS FOR SUSPENDED CEILINGS TO BE INSTALLED IN THIS CONTRACT.
9. PROVIDE 1" THICK UNDERSLAB INSULATION ON CONC. SLAB ON GRADE IN THE ENTIRE CONCOURSE LEVEL FLOOR SLAB BETWEEN WALLS ENCLOSING ALL THE VARIOUS AREAS EXCEPT IN THE EXECUTIVE PARKING & BUS TERMINAL AREAS.
10. THE INSULATION, FILL & CEMENT SLOPE FINISH SHALL NOT BE INSTALLED IN THE UNFINISHED AREAS NOTED AS ** IN THE CONCOURSE LEVEL ONLY, UNTIL THE FINAL FINISHES HAVE BEEN ESTABLISHED IN SUCH AREAS.
11. PROVIDE SCRATCH SMOOTH DOWN PLAS. ON EXPOSED FACES OF DOUBLE WALLS IN MECH. ROOMS - SEE 1/8" SCALE PLANS FOR LOCATION.
12. ALL EXTERIOR WALLS ON CONCOURSE LEVEL SHALL BE FURRED & PLASTERED. FURRING SHALL BE DONE BY MASONRY OR BY CHANNELS & LATH AS NOTED ON DWGS. NO FURRING ON EXTERIOR WALLS IN MECHANICAL ROOM. SEE DWG. G4/4-124 FOR FURRING WITH CHANNELS & LATH.
13. PROVIDE 1" FIBERGLASS INSULATION ON EXTERIOR WALLS OF CONCOURSE LEVEL, WHERE NOTED ON THE DRAWINGS.
14. PROVIDE INSULATION ON FLOORS & CLGS. IN CERTAIN AREAS IN 100'-0" LEVEL - SEE DWG. NOS G4/4-124 & G4/4-89.


* NOT NO. 5 APPLIES ONLY TO FINISH P.O. ALL OTHER NOTES APPLY TO ALL FINISHES.


ARCHITECTURAL DRAWING NUMBERS

- G4/4-1 PLOT PLAN
- G4/4-2 LOCATION GRADING & DRAINAGE PLAN
- G4/4-3 FINISH SCHEDULE, LEGEND, GENERAL NOTES, DRAWING NUMBERS
- G4/4-4 AREAS BELOW 100'-0" LEVEL
- G4/4-5 GARAGE - FIRST LEVEL - ELEVATION 100'-0" - ELEVATION 93'-0"
- G4/4-6 GARAGE - SECOND LEVEL - ELEVATION 117'-0" - ELEVATION 115'-0"
- G4/4-7 GARAGE - THIRD LEVEL - ELEVATION 127'-0" - ELEVATION 125'-0"
- G4/4-8 CONCOURSE PLAN - 137'-0" LEVEL
- G4/4-9 PLAZA PLAN
- G4/4-10 MECHANICAL EQUIPMENT ROOMS NO. 1, 13, 16, 17 & 18
- G4/4-11 MECHANICAL EQUIPMENT ROOMS NO. 2, 5, & 4
- G4/4-12 MECHANICAL EQUIPMENT ROOMS NO. 8, 9, 6, 7, 8, 9, 10, 11, 12, 15 & 14
- G4/4-13 HIGHWAY & GROUNDS, SATELLITE POOL, SERVICE AREA & ROLLING STEEL DOORS
- G4/4-14 PART PLAN - LOADING DOCK, WAREHOUSES AND TOILET DETAILS
- G4/4-15 PART PLAN - LOADING DOCKS, WAREHOUSES AND TOILET DETAILS
- G4/4-16 PART PLAN - MEETING HALL, DRESSING ROOMS, TOILET DETAILS & STORAGE AREA
- G4/4-17 CONCOURSE TOILETS NO. 1, 2, 3, 4 & 13 (3&4 IS SIMILAR TO 3 & 4)
- G4/4-18 CONCOURSE TOILETS NO. 5, 6, 7, 11, 12, 14 TO 16 INCL. & DETAILS
- G4/4-19 CONCOURSE TOILETS NO. 10, 17, 18, 19, (NO. 8, 9, & 20 THROUGH 27 N.I.C.) 33 & 49
- G4/4-20 LONGITUDINAL SECTION, TRANSVERSE SECTION; REFLECTED CEILING PLANS & COLUMN DETAILS.
- G4/4-21 EAST HALF OF ARTERIAL
- G4/4-22 WEST HALF OF ARTERIAL
- G4/4-23 CROSS SECTIONS AT ARTERIAL
- G4/4-24 CONCOURSE - PART FLOOR PLAN - TYPICAL WALL DETAILS
- G4/4-25 CONCOURSE - PART FLOOR PLAN
- G4/4-26 CONCOURSE - PART FLOOR PLAN
- G4/4-27 CONCOURSE - PART FLOOR PLAN
- G4/4-28 CONCOURSE - PART FLOOR PLAN
- G4/4-29 CONCOURSE - PART FLOOR PLAN
- G4/4-30 CONCOURSE - PART FLOOR PLAN - SEE (A) SCALE PLANS FOR LOCATION OF MARBLE ON SOME WALLS.
- G4/4-31 CONCOURSE - PART FLOOR PLAN
- G4/4-32 CONCOURSE - PART FLOOR PLAN
- G4/4-33 CONCOURSE - PART FLOOR PLAN
- G4/4-34 CONCOURSE - PART FLOOR PLAN
- G4/4-35 CONCOURSE - PART FLOOR PLAN
- G4/4-36 CONCOURSE - PART FLOOR PLAN
- G4/4-37 CONCOURSE - PART FLOOR PLAN
- G4/4-38 CONCOURSE - PART FLOOR PLAN
- G4/4-39 CONCOURSE - PART REFLECTED CEILING PLAN & DETAILS
- G4/4-40 CONCOURSE - PART REFLECTED CEILING PLAN
- G4/4-41 CONCOURSE - PART REFLECTED CEILING PLAN.
- G4/4-42 CONCOURSE - PART REFLECTED CEILING PLAN
- G4/4-43 CONCOURSE CORRIDORS ELEVATIONS
- G4/4-44 CONCOURSE CORRIDORS ELEVATIONS
- G4/4-45 CONCOURSE CORRIDORS ELEVATIONS
- G4/4-46 CONCOURSE CORRIDORS ELEVATIONS
- G4/4-47 PEDESTRIAN TUNNELS TO SWAN STREET BUILDING
- G4/4-48 NORTH AND EAST EXTERIOR ELEVATIONS
- G4/4-49 SOUTH AND WEST EXTERIOR ELEVATIONS
- G4/4-50 CIRCULAR STAIR FROM EAST PARK
- G4/4-51 CIRCULAR STAIR DETAILS
- G4/4-52 STAIRWAY TO PLAZA FROM CONCOURSE - LANCASTER STREET ENTRANCE TO GARAGE
- G4/4-53 RAMPS TO PLAZA & ARTERIAL HIGHWAY THROUGH WEST PARK
- G4/4-54 STAIRS ON WEST FACE OF PLATFORM
- G4/4-55 WEST PARK ARCHWAY DETAILS
- G4/4-56 MADISON AVENUE RAMP PLANS & SECTIONS
- G4/4-57 MADISON AVENUE RAMP, SECTIONS & DETAILS
- G4/4-58 PLAZA RAMPS TO CONCOURSE, EXECUTIVE PARKING
- G4/4-59 ENTRANCE TO CONCOURSE FROM JUSTICES BLDG. COURT - 137'-0" LEVEL
- G4/4-60 MADISON AVENUE ENTRANCE DOORS TO CONCOURSES
- G4/4-61 MADISON AVENUE STAIRS TO CONCOURSE AND TO PLAZA LEVEL
- G4/4-62 DETAILS OF EXTERIOR DOOR NO. 192 OFF MAD. AVE. & MAD. AVE. BRIDGE DETAILS
- G4/4-63 EXTERIOR WALL DETAILS & PLAZA PAVEMENTS
- G4/4-64 MISCELLANEOUS EXTERIOR WALL DETAILS
- G4/4-65 EXTERIOR WALL - PLAN & ELEVATIONS - HEALTH DEPT. LABORATORIES
- G4/4-66 EXTERIOR WALL - SECTIONS & WINDOW DETAILS - HEALTH DEPT. LABORATORIES
- G4/4-67 EXTERIOR WALL - SECTIONS & WINDOW DETAILS - HEALTH DEPT. LABORATORIES
- G4/4-68 DOOR SCHEDULE
- G4/4-69 DOOR DETAILS
- G4/4-70 MISCELLANEOUS IRON
- G4/4-71 MISCELLANEOUS IRON
- G4/4-72 MISCELLANEOUS IRON
- G4/4-73 MISCELLANEOUS IRON
- G4/4-74 MISCELLANEOUS IRON
- G4/4-75 STAIR NOS. 1 & 2
- G4/4-76 STAIR NOS. 2 & 3 - ELEVATORS NO. 1, 2, 3, & 4
- G4/4-77 STAIR NOS. 4 & 5 - ELEVATORS NO. 5, 6, 7, & 8
- G4/4-78 STAIR NOS. 6, 7, 11 & 12 - ELEVATORS NO. 9, 10, 11, & 12
- G4/4-79 STAIR NOS. 9 & 10 AT PLAZA & TYP. DETAILS OF PLAZA EXIT STAIRS & PYLONS
- G4/4-80 STAIRS NOS. 13, 18 & 19
- G4/4-81 STAIR DETAILS
- G4/4-82 ELEVATORS 13 TO 18 INCLUSIVE 25 TO 28
- G4/4-83 ELEVATORS 19 TO 24 INCLUSIVE
- G4/4-84 PASSENGER & KITCHEN ELEVATOR CAB & DOOR DETAILS
- G4/4-85 INSULATED AREAS IN 100'-0" LEVEL & AIR REGISTER DETAILS IN GARAGES
- G4/4-86 INTERIOR RAMPS & DETAILS
- G4/4-87 CONCOURSE CORRIDOR GLASS & DOOR DET - DOOR NO. [illegible] 22 TO 32, 38 & 41, 42, 45, 46, 63, 64, 74, 77 TO 103, 111, 115, 117 TO 122
- G4/4-88 CONCOURSE CORRIDOR GLASS & DOOR DET - PLANS, ELEV & DET - DOORS NO. 1, 2, 3, 4, 5, 6, 7, 8, 9, 10, 11, 12, 13, 14, 15, 16, 17, 18, 19, 20, 21, 23, 24, 25, 26, 27, 28, 29, 30, 31, 33, 34, 35, 36, 37, 39, 40, 43, 44, 47, 48, 49, 50, 51, 52, 53, 54, 55, 56, 57, 58, 59, 60, 61, 62, 65, 66, 67, 68, 69, 70, 71, 72, 73, 74, 75, 76, 104, 105, 106, 107, 108, 109, 110, 112, 113, 114, 116, 123, 124, 125,1

44782 ADDENDUM
—REFERENCE
DRAWING SET 1

FOR REFERENCE ONLY.
REFERENCE DRAWINGS
MAY NOT REFLECT
ACTUAL CONDITIONS.

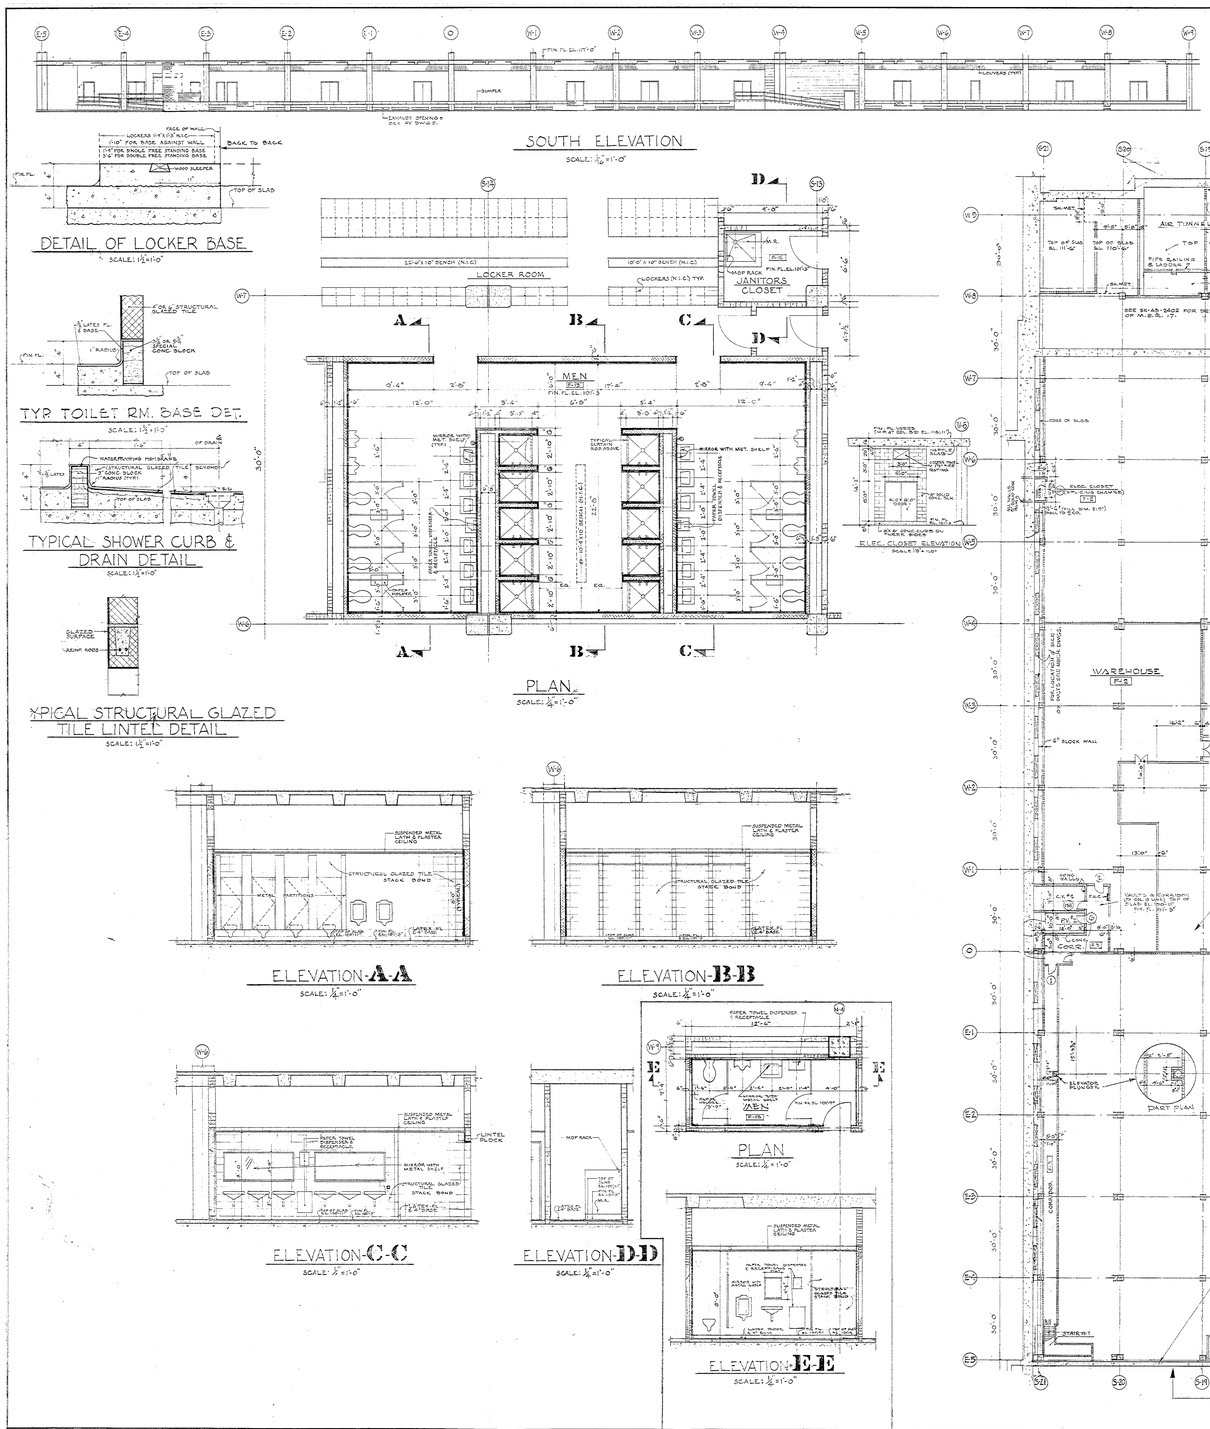

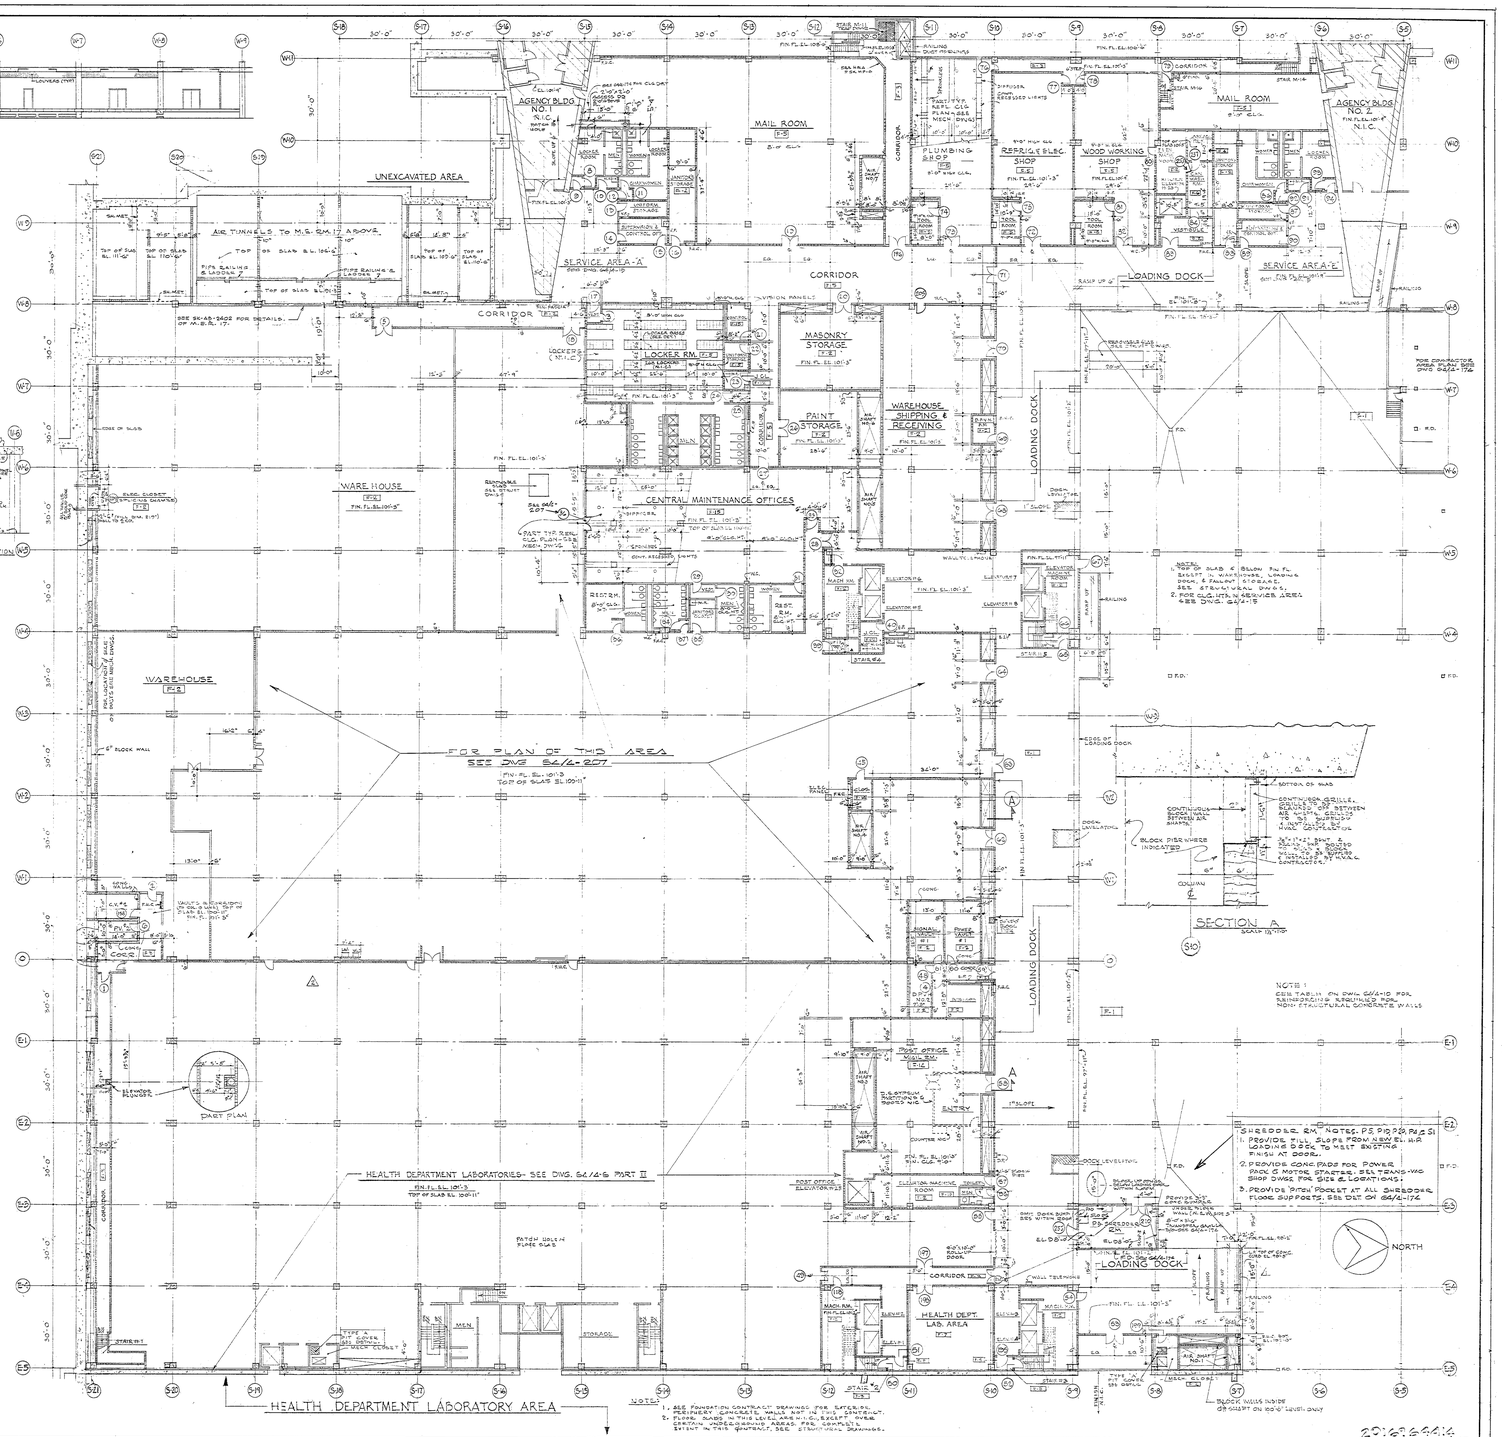

HARRISON & ABRAMOVITZ
ARCHITECTS
630 FIFTH AVENUE NEW YORK 20, N. Y.

REV.	DATE	ISSUED TO
A	11/8/74	AGENCY AT 1ST PATCH OPEN IN WALL - ADDITION WITH LOADING DOCK AT 1ST FLOOR ON SW SIDE OF BLDG.
B	4/11/75	83-64/S3-251 PATCH HOLES IN SLAB. ADDED SHREDDER ROOM P.S.F. 400, COL. B/350, NOTES 19, 21 & 26 SOUTH ELEVATION - ADDED DOOR, DOCK OFFICE, CHANGE INDICATED FUTURE PARTITIONS TO N.I.C.
C	7/21/75	ADDED SHREDDER ROOM P.S.F. 400, COL. B/350, NOTES 19, 21 & 26 SOUTH ELEVATION - ADDED DOOR, DOCK OFFICE, CHANGE INDICATED FUTURE PARTITIONS TO N.I.C.
D	8/7/75	SECURITY DRAWING

REV.	DATE	ISSUED TO
A	3/4/40	RELOCATED DOCK LEVELATOR AND COL. B/P4 & ADDED DOCK LEVELATOR, 4 SEL. COL. B/P3 & P4.
A	3/4/40	ADD AIR TUNNELS TO MECH. ROOM BEL. 17'- ADDED AND CHANGED SOME WALLS
A	4/5/40	ADD 4 SEWING MACHINE RECESSES, ADD 2 DOORS & CHANGE WALLS
A	5/6/40	ADD WALL & SEWING MACHINE RECESS, ADD DOOR, CHANGE WALL & DOOR
A	6/4/40	CHANGE LOCKER ROOM FOR 60 MEN & 60 WOMEN, ADD SHOWERS & TOILETS, CHANGE WALLS & DOORS
A	6/4/40	ADD 2 DOORS & CHANGE WALL

44782 ADDENDUM
REFERENCE
DRAWING SET 1

FOR REFERENCE ONLY.
REFERENCE DRAWINGS
MAY NOT REFLECT
ACTUAL CONDITIONS.

WEST ELEVATION
SCALE: 1/8"=1'-0"

PLAN - APPLIES TO SERVICE AREAS A & C
(SERVICE AREAS B & D ARE SIMILAR BUT REVERSED)
(FOR SERVICE AREA D SEE TOWER BLDG)
SCALE: 1/4"=1'-0"

PLAN - ADJACENT TO POST OFFICE STAIR ROOM
SCALE: 1/4"=1'-0"

ELEVATION C-C
SCALE: 1/4"=1'-0"

PLAN - IN SATELLITE POOL SERVICE AREA
SCALE: 1/4"=1'-0"

ELEVATION D-D
SCALE: 1/4"=1'-0"

PLAN - AT CENTRAL MAINTENANCE OFFICES & INTER-AGENCY MAIL MESSENGER
SCALE: 1/8"=1'-0"

ELEVATION E-E
SCALE: 1/4"=1'-0"

ELEVATION F-F
SCALE: 1/4"=1'-0"

ELEVATION G-G
SCALE: 1/4"=1'-0"

ELEVATION H-H
SCALE: 1/4"=1'-0"

ELEVATION J-J
SCALE: 1/4"=1'-0"

ELEVATION L-L
SCALE: 1/4"=1'-0"

ELEVATION K-K
SCALE: 1/4"=1'-0"

PLAN - IN SATELLITE POOL SERVICE AREA
SCALE: 1/4"=1'-0"

ELEVATION M-M
SCALE: 1/4"=1'-0"

ELEVATION N-N
SCALE: 1/4"=1'-0"

ELEVATION A
(LOADING BERTH AT JUSTICE BUILDING)
SCALE: 1/4"=1'-0"

PLAN
SCALE: 1/4"=1'-0"

ELEVATION B
SCALE: 1/4"=1'-0"

ELEVATION A-A
SCALE: 1/4"=1'-0"

ELEVATION B-B
SCALE: 1/4"=1'-0"

HARRISON & ABRAMOVITZ
ARCHITECTS
630 FIFTH AVENUE NEW YORK 20, N.Y.

ALBANY, NEW YORK
ALBANY SOUTH MALL PROJECT
MAIN PLATFORM, HEALTH POWER LABORATORIES, E & G BUILDING, CENTER SUPERSTRUCTURES
MAIN PLATFORM PART E

ARCHITECTURAL
FIRST PLATFORM PLAN
WAREHOUSES & TOILETS

STATE OF NEW YORK
OFFICE OF GENERAL SERVICES
ALBANY, NEW YORK

44782 ADDENDUM REFERENCE DRAWING SET 1

FOR REFERENCE ONLY. REFERENCE DRAWINGS MAY NOT REFLECT ACTUAL CONDITIONS.

"ELEVATION "A"
Scale ½ F.S.

NOTES:
1. This Detail to be used where a Minimum of 2'-8" Width of Concrete Blocks Wall 6'-0" to 8'-0" o.c. cannot be Continued to Slab Above, Between the Duct Lines - (See H.V.A.C. Dwgs.) See also Elevation "A" & Wall Sections - this Dwg. WHERE WALLS OCCUR BETWEEN RIBS OF THE STRUCTURAL SLAB, THE PANS SHALL BE FILLED TO FORM A FLAT SLAB.
2. SEE DWG. G4/4-24 FOR ADDITIONAL BRACING DETAILS OF PARTITIONS.

"PART ELEVATION"
· SHOWING TYPICAL WALL BRACING AT AREAS OF WIDE DUCT PENETRATION (See H.V.A.C. Dwgs. for Locations)
· Scale ½" = 1'-0"

"PLAN AT 127'-0" & 131'-6" LEVEL" Scale ⅛" = 1'-0"

"SECTION THRU 6" C.B. WALL"
Scale ½ F.S.

"SECT. THRU 12" C.B. WALL"
(See H.V.A.C. Dwgs. For Wide Duct Work)

"DETAILS OF WALL BRACING AT AREAS OF WIDE DUCT PENETRATION CONCOURSE LEVEL"

SEE DWG. NO G4/4-24 FOR CONTINUATION OF THIS SECTION

SEE DWG. NO G4/4-27 FOR CONTINUATION OF THIS SECTION

SEE DWG. NO G4/4-28 FOR CONTINUATION OF THIS SECTION

PART PLANS OF SUPPORTING STEEL FOR SUSPENDED C.L.G.
SCALE: ⅛" = 1'-0"

NOTE:
1. EL. 150'-5½" TOP OF 14W BEAMS. EL. 149'-5½" TOP OF 4" CHANNELS
2. STEEL FRAMING BY MISC. STEEL CONTRACTOR.

KEY PLAN

NORTH

REV	DATE	ISSUED TO
1	10/6/61	REV. DUCT LOADING STATION P.9.
2	7/7/61	PNEUMATIC DOOR 7 - EXTENDED CONCRETE
3	11/9/61	REV. DUCT WORK FOR FLOOR AT 127'-0" & 131'-6" LEVELS - ADDED SHAFT ADD. UNIT NO. 481 & STAIR NO. 18 - OMITTED
		SLIDING DOOR 1 - TELEPHONE BOOTH 1 - OMITTED ADD. DOOR 10 - SOUTH LOBBY - ADDED DUCTWORK
		REV. DUCT WORK AT JAN. CLOSET 1 - REVISION FOR EXH. & AT STAIR NO. 11
4	4/19/62	REV. FIRST PLANS OF SUPPORTING STEEL TO AGREE WITH CONCOURSE SHAFT - BALANCED TELEPHONE BOOTHS & HANDICAP TELEPHONE AREAS AND REDUCED CEILING HEIGHT
5	7/16/62	PLAN AT 127'-0" & 131'-6" LEVEL - ADDED ELEV. OPN. AND TRAN. AT. ADDED ELEV. OPN. & DUCTS 16 & 17 - PLAN AT 151'-6" LEVEL - REDUCED JAN. CLOSET 1 - ADDED CLG. & DUCTS 18 & 19 - ADDED DUCT 20
6	8/19/62	REVISED PLANS OF SUPPORTING STEEL FOR ROOF CLG. ADDED ONLY, SEE SUPPLEMENTARY DWG. 7/9/62
7	8/19/62	ADDED PNEUMATIC OPERATORS TO DOORS 7 TO 9, 203 AND TO CULTURAL CENTER. DWGS. AT ELEVATION 151'-6"
		REV. DWG. #1 JAN. CLOSET AND ELEV. & TELEPHONE BOOTH
8	4/16/63	ADDED SPRINKLERS IN MECH. AREA 4-1
9	6/5/63	ALLOWANCE (1 STAIR) NO. 23 & 24 REVISED. ADD. BANDSTAND, ORCH. PIT & ELEV. SHAFT
10	7/8/63	REVISED DRAWING

⚠ FOR REV. 12 SEE REV. BOX @ LEFT

HARRISON & ABRAMOVITZ
ARCHITECTS
630 FIFTH AVENUE NEW YORK 20, N. Y.

ALBANY, NEW YORK

ALBANY SOUTH MALL PROJECT

MAIN PLATFORM, HEALTH DEPT. LABORATORIES & MEETING CENTER SUPERSTRUCTURES

MAIN PLATFORM PART 1

DRAWN BY	Z.H
CHECKED BY	A.S.H.
SCALE	⅛" = 1'-0"
APPROVED BY	O.G.S.
D.P.W.	

ARCHITECTURAL
CONCOURSE
PART FLOOR PLAN

PROJECT NO. 2019
SPECIFICATION NO. 2019-C
DATE July 10, 1967
DRAWING NO. G4/4-25

STATE OF NEW YORK
OFFICE OF GENERAL SERVICES
C.V.R. SCHUYLER - COMMISSIONER
DEPARTMENT OF PUBLIC WORKS — J. A. McMORRAN, SUPERINTENDENT
DIVISION OF ARCHITECTURE — C. S. KAMKOSKI, STATE ARCHITECT

44782 ADDENDUM REFERENCE DRAWING SET 1

FOR REFERENCE ONLY. REFERENCE DRAWINGS MAY NOT REFLECT ACTUAL CONDITIONS.

KITCHEN EQUIPMENT LIST (NOT IN CONTRACT)
SEE SPECIFICATION NO. 24737

NO.	ITEM
1	Serving Counter
2	Dessert Cold Section with Display Case
3	Salad Cold Pan with Display Case
4	Hot Food with Protector Case
5	Cup & Saucer Dispenser
6	Coffee Urn
7	Creamers
8	Tray Slide
9	Cash Register
10	Back Counter
11	Pass Thru Hot
12	Pass Thru Refrigerator
13	Back Counter
14	Ice Cream Cabinet
15	Ice Maker
16	Condiment Stand (2 ea.)
17	Trays
18	Trays
19	Serving Counter
20	Coffee Urn
21	Creamers
22	Tray Slide
23	Cash Register
24	Refrigerator
25	Back Counter
26	Grill Stand
27	Griddle
28	Fryer
29	Sandwich Unit
30	Toaster
31	Soiled Dish Table
32	Dishwasher
33	Clean Dish Tablo
34	Scullery Sink
35	Cooks Table and Sink
36	Preparation Table
37	Vegetable Sink
38	Vertical Cutter Mixer
39	Vegetable Table
40	Fryer
41	Spreader
42	Fryer
43	Range
44	Convection Oven
45	Oven
46	Ventilating Unit
47	Ventilating Unit
48	Ventilating Unit
49	Kettle & Steamer
50	Kettle & Steamer
51	Ventilating Unit
52	Ventilating Unit
53	Butcher's Table
54	Butcher's Sink
55	Work Table
56	Grinder
57	Slicer
58	Cook's Table
59	Cook's Table
60	Mixer
61	Ice Cube Maker
62	Refuse Compactor

NOTE: DIMENSIONS SIMILAR AT VISION PANELS ON 2ND FLOOR ON WALL @ COL. N3 IN THE SOUTH WALL OF THE NW CORRIDOR.

NOTES - CAFETERIA NO. 1:
1 - PAV. SYSTEM ACOUSTEX 2100 GSD - SEE DWG. G4/4-107
2 - PAV. VISCAL TILE GSC - SEE DWG. G4/4-176
3 - PAV. RUBBER BASE - SEE DWG. G4/4-31
4 - PAV. QUARRY TILE - SEE DWG. G4/4-107 FLOOR PLAN & ELEVATION GLOSS BLACK #20
5 - PAV. RUBBER TILE - SEE DWG. G4/4-107 FLOOR PLAN & ELEVATION GLOSS BLACK #20
6 - SEE DWG. G4/4-107 FLOOR PLAN & ELEVATION FOR FURNISHING PLAN IN CAFE. NO 3
7 - PAV. CERAMIC TILE - SEE DWG. G4/4-107 FLOOR PLAN & ELEVATION - SEE DWG. G4/4-107
SEE DWG. NO 64/4/124 FOR CONTINUATION OF THIS SECTION

SEE DWG. NO 64/4/89 FOR CONTINUATION OF THIS SECTION

SEE DWG. NO 64/4/27 FOR CONTINUATION OF THIS SECTION

KEY PLAN


NORTH

REV	DATE	ISSUED TO
A	7/7/64	REV. 1 DOOR LEAF-DOOR 20, EXTENDED CANOPY.
A	10/6/64	REV. REMOVE ALL ASBESTOS BOARD WALL AND TILE FROM AREA A.B.D. ADDED DOOR 106 TO NEW STORAGE RM. SOUTH OF MECH. RM. #4-5
A	3/26/65	ADDED PNEUMATIC OPERATOR, DOOR 20. REV. DIM. AT EAST WALL OF SOUTH WEST, CORR. 8 COL. W5.
A	5/3/65	ADDED SEATING IN MECH. RM. #4-8
A	2-19-71	ADDED VISION PANEL SET, COLS. W6 & W7 ON SOC. B-3
A	10/7/71	ADDED WASTE HANDLING STATION - SEE 4140-19
A	1/7/72	ADDED DOORS, NE 518 - SEE 5-BUILT DRAWING

REV	DATE	
A	7/7/72	WALL DWG. TO ORIGINATIVE - SOURCE - 7/12 - 105
A		ADDED MEDIA CENTER - PARAGRAPH 02276 - 10/6 - 82
A		CHANGED SERVING AREAS - SEE SERVING ISSUE AM DRAWINGS
A	11/74	ADD PIPE SLEEVE - SEE DWG. G4/4-107
A	12/74	ADD LEAD LINING TO X-RAY ROOM #2 - SEE ADDENDUM

44782 ADDENDUM REFERENCE DRAWING SET 1

FOR REFERENCE ONLY. REFERENCE DRAWINGS MAY NOT REFLECT ACTUAL CONDITIONS.

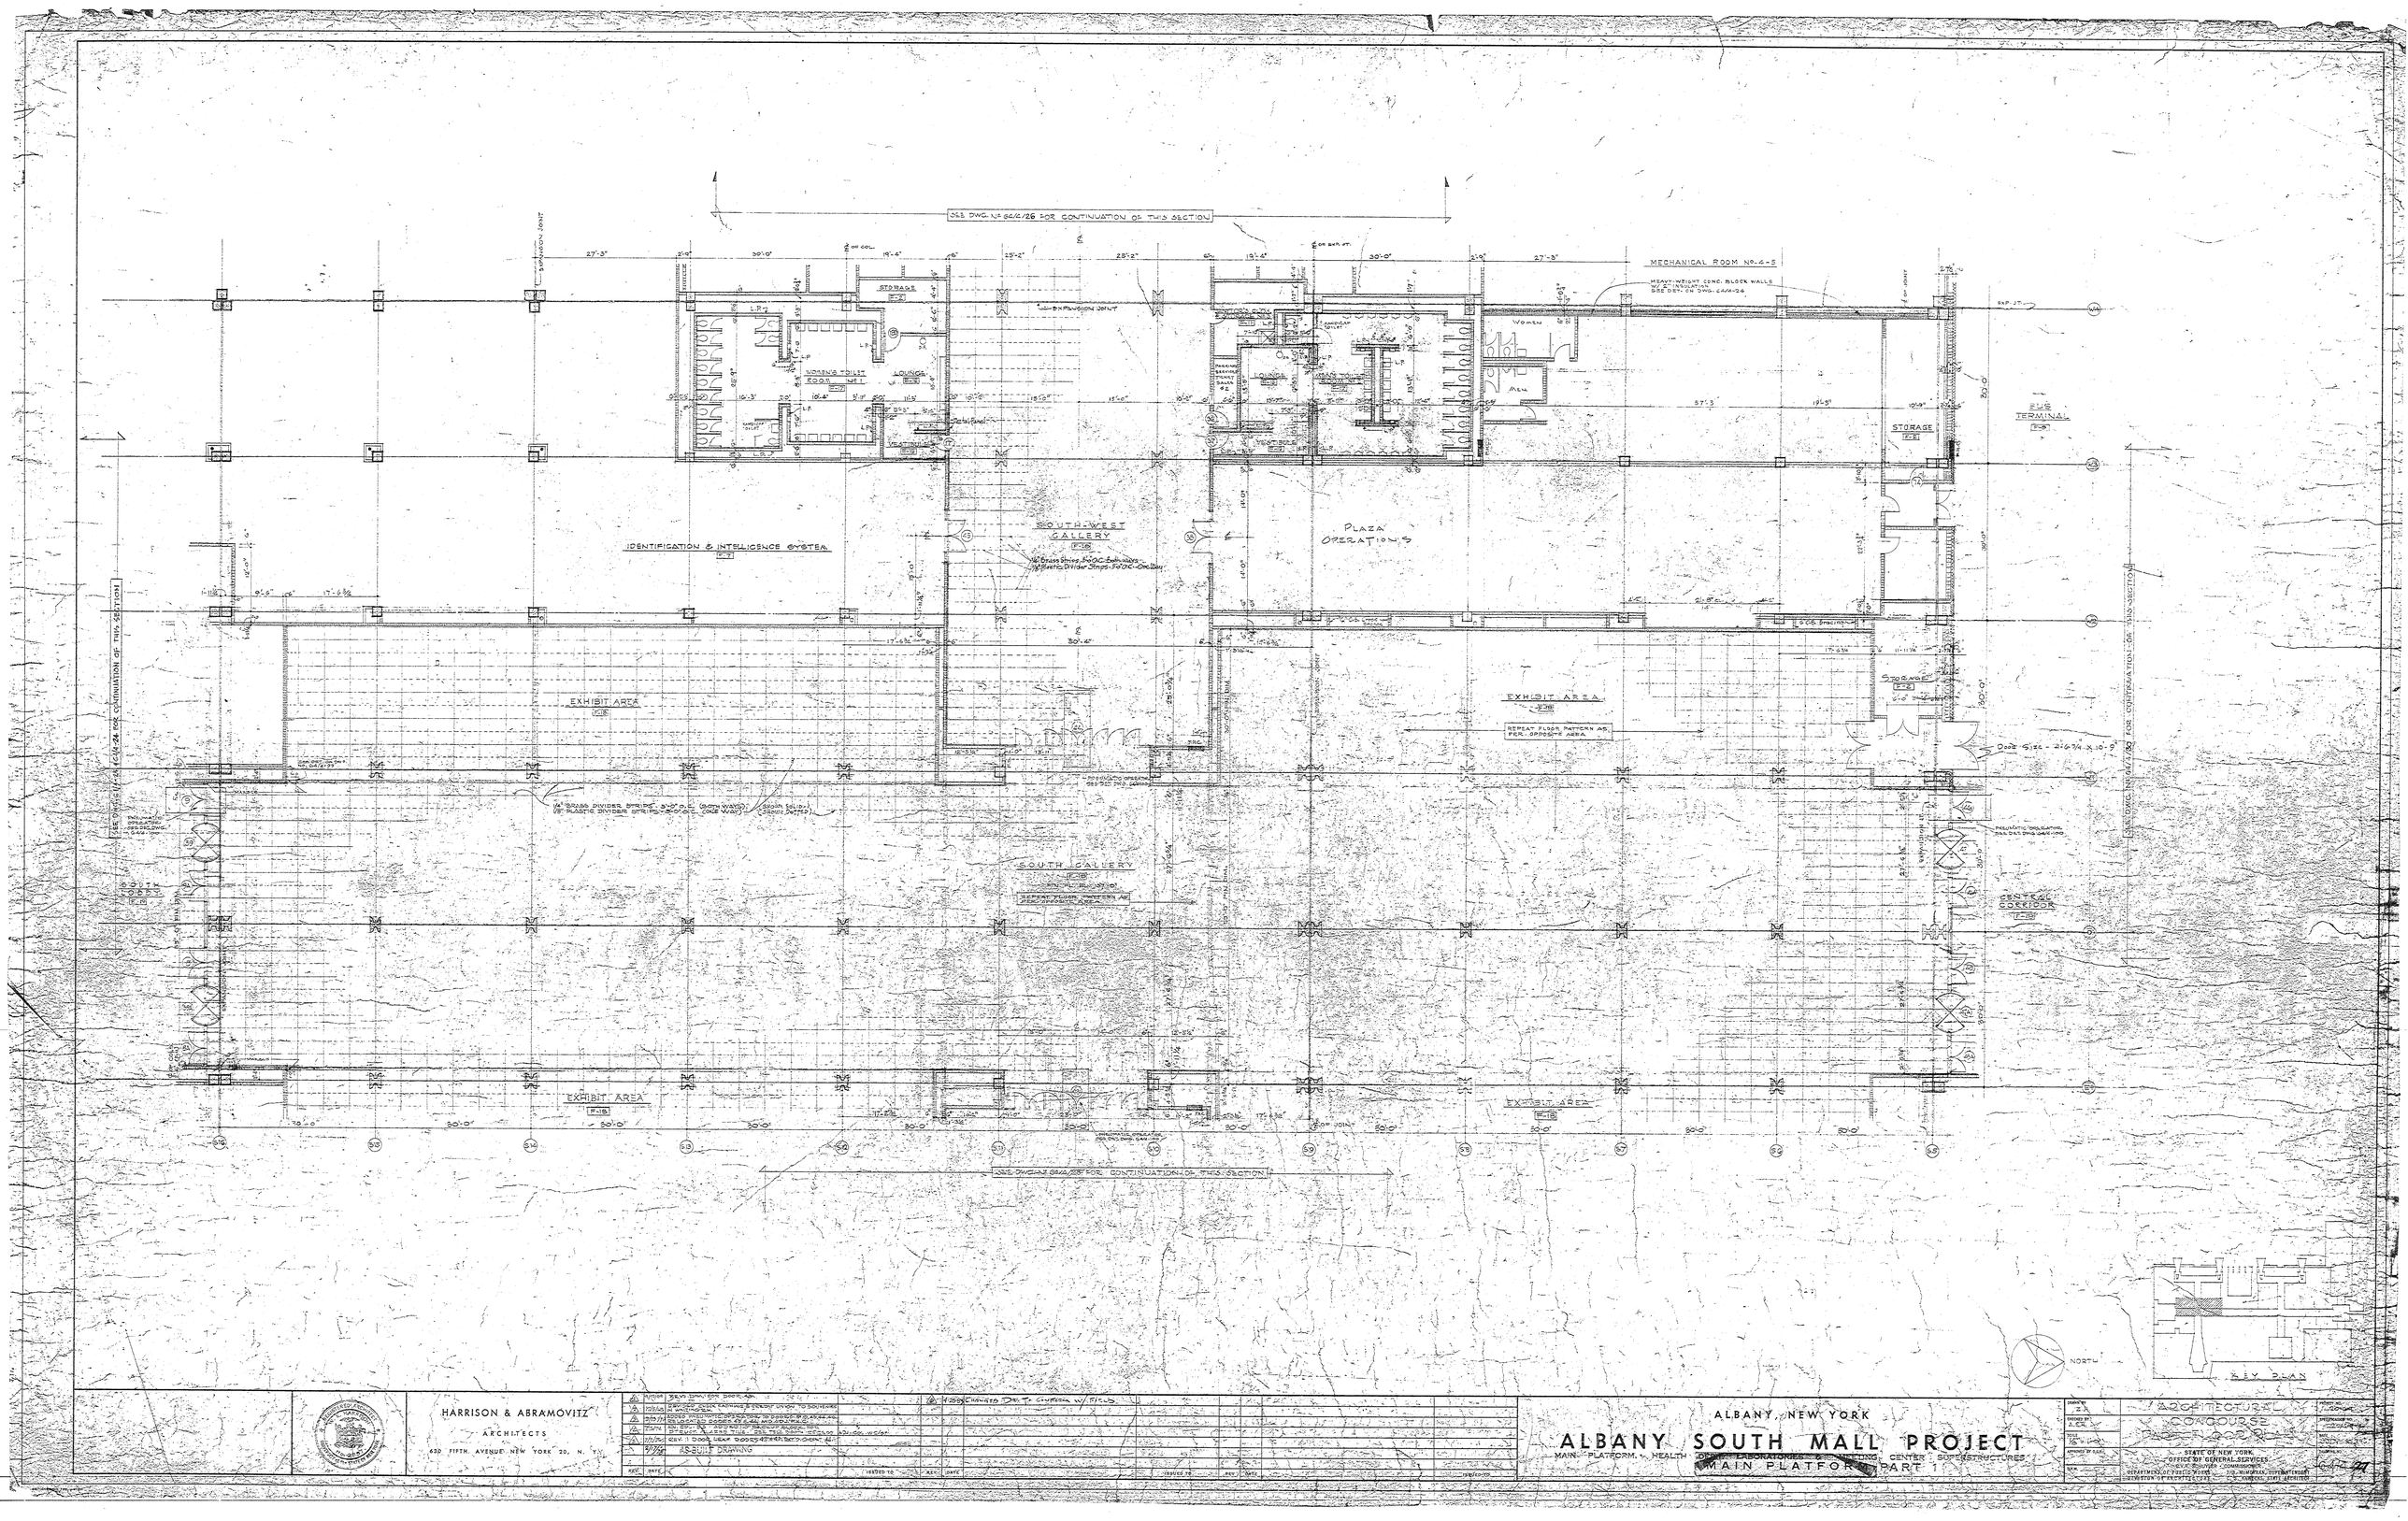

HARRISON & ABRAMOVITZ
ARCHITECTS
630 FIFTH AVENUE NEW YORK 20, N. Y.

REV.	DATE	ISSUED TO	REV.	DATE	ISSUED TO

ALBANY, NEW YORK

ALBANY SOUTH MALL PROJECT

MAIN PLATFORM, HEALTH LABORATORIES & MEETING CENTER SUPERSTRUCTURES

MAIN PLATFORM - PART 1

ARCHITECTURAL CONCOURSE PLAN - QUADRANT

STATE OF NEW YORK
OFFICE OF GENERAL SERVICES
EDWARD LITTLE, COMMISSIONER
DEPARTMENT OF PUBLIC WORKS — U.S. MUNICIPAL DEVELOPMENT
DIVISION OF FACILITIES DEVELOPMENT — HARRISON, STATE ARCHITECT

44782 ADDENDUM REFERENCE DRAWING SET 1

FOR REFERENCE ONLY. REFERENCE DRAWINGS MAY NOT REFLECT ACTUAL CONDITIONS.

SEE DWG. NO 64/4/27 FOR CONTINUATION OF THIS SECTION

SOUTH GALLERY

EXHIBIT AREA

Carpet Floor Patterns as on Opposite Side.

Carpet Pattern for Divider Strips as shown Opposite Sta.

14" BRASS DIVIDER STRIPS 5'-0" OC. BOTH WAYS (SHOWN SOLID)
10" PLASTIC DIVIDER STRIPS 5'-0" OC. ONE WAY (SHOWN DOTTED)

• AREA FOR TESTING LABS. SEE DWG. 64/4-156

POLICE SECURITY DEPT. SEE DWG. 64/4-155

POST OFFICE

STORAGE

POST SERVICE WORK AREA

SELF SERVICE POST UNIT N.I.C.

LOCK BOXES N.I.C.

CLG. LINE PARTITION FOR CLG. DOOR SHOWN DOTTED IS NOT IN CONTRACT

SERVICE COUNTER

WALL DOOR N.I.C.

FOR CLG. PLAN, SEE OPP

DELIVERY WINDOW N.I.C.

POOL EQUIP. RM. NO. 1

MECHANICAL AREA NO. 1

EMPLOYEES HEALTH UNITS

WARD

NURSE

TREAT.

WAITING RM.

SEE DETAIL

SEE DWG. 64/4/25 FOR CONTINUATION OF THIS SECTION

SECT-A

SECT-B

T.O.S. EL. 140'-0"

EL. 146'-10"

EL. 146'-10"

SPRAYED ON F.P.

REFLECTED CEILING PLAN
EMPLOYEES HEALTH UNITS
9'-0" CLG. EXCEPT WHERE SHOWN

DET-1

DET-2

DET. OF CURTAIN TRACK SUPPORT

Provide 1 1/2 x 1 1/2 Angle or 9" Channel Supported on Clg. Grid

Fin. Clg.

Curtain Track N.I.C.

SEE DWG. NO 64/4/32 FOR CONTINUATION OF THIS SECTION

LEGEND

DOOR: PARTITION N.I.C.

PL — PLASTER-SEE PLAN; STRUCTURAL GLAZED TILES, HEAVY LINE INDICATES GLAZED SIDE

CB — CONCRETE BLOCK; PLASTER-SEE PLAN

CB — CONCRETE BLOCK (IN CONTRACT); PLASTER-SEE PLAN

POOL EQUIPMENT ROOM NO. 2

INTERCOM N.I.C.

TELEPHONE N.I.C.

ELEV. NO. 3

STAIR

STAIR CORRIDOR

POLICE SECURITY STORAGE SEE 64/4-156

CLG. ANALYZER

SOUND CONTROL 24

ELECTRICAL ROOM NO. 2

CORRIDOR

JANITOR'S CLOSET NO. 19

STORAGE

TELEPHONE N.I.C.

TERRAZZO FLOOR

OFFICE TOWER BUILDING (N.I.C.)

CL OF TOWER BLDG.

AIR SHAFT NO. 17

MECHANICAL ROOM NO. 18

CORRIDOR

DINING ROOM

KITCHEN

STORAGE

CAFETERIA NO. 8

EXPANSION JOINT

SEE DWG. NO 64/4/32 FOR CONTINUATION OF THIS SECTION

PLAN AT CONC. COL.
SCALE: 1"=1'-0"

DETAIL A
SCALE: 3"=1'-0"

ELEVATION OF STEEL PLATE AND ROLLING DOOR RECESS
SCALE: 3/8"=1'-0"

NOTE: FOR ELEVATIONS SEE ELEV. 2/12 & 11/14 ON DWG. 64/4-42

PAINTING:
■ WALL TO BE PAINTED BLUE PANTONE 298.
□ ALL OTHER WALLS, FASCIA, ELEC. PANELS, DUCT, BLOCK WALL TO BE PAINTED WHITE, MOORE-O-MATIC 16-118.
FIRE HOSE CABINET EXTERIOR & INTERIOR TO BE PAINTED RED.

3 FIXTURES ARE SURFACE MTD.

ACOUSTICAL INSULATION BLANKET

CLG. DIFFUSER

LINE OF FUTURE PARTITION

MAIN RUNNER

BOT. OF CONC. SLAB EL. 151'-6"

BYPASS TILE SYSTEM

PAINT CONC. WHITE

ELEV. 144'-0"

BOT. OF ROOF SLAB EL. 155'-6"

FOR ELEC. WORK SEE ELEC. DWGS
FOR SPRINKLER, DUCT, ETC. SEE MECH. DWGS.

REFLECTED CEILING PLAN
FEDERAL POST OFFICE
10'-0" CEILING HEIGHT. 1/8"=1'-0"

DIFFUSER, SEE DWG

ANGLE TRIM

MAIN RUNNER OR CROSS TEE SEE NOTE 3

CLIP

FUTURE N.I.C.

SECT X

TYP. PLAN

INTERIOR CORNER

USG METAL FURRING CHL. 1 1/2" O.C. SEE HEIGHT

IMPERIAL TAPE ELIM.

BASE CLG. SEE PLAN

IMPERIAL GYP BASE (REGULAR)

DOOR CASING

EXTERIOR CORNER

VINYL BASE-COLOR AS SEL. BY ARCH.

FIN. TILE FL.

TYP. SECTION

NOTE:
1. PROVIDE WALL FURRING AS INDICATED. FURRING SHALL BE 1 1/2" METAL CHANNELS INSTALLED AS REQUIRED. PROVIDE FURRING CHANNELS AT POINTS WHERE FUTURE PARTITIONS WILL ABUT IMPERIAL GYPSUM BASE SHALL BE 48" WIDE & MOUNTED AS REQUIRED. SECURE EDGES. PROVIDE ADHESIVE TYPE ACOUSTICAL SEALANT BEHIND STUDS ETC. FOR A COMPLETE INSTALLATION. ALL JOINTS SHALL BE CAULKED, TAPED, SANDBLASTED, FOR A SMOOTH FINISH. ALL MATERIALS, DETAILS SHALL BE U.S. GYPSUM, OR APPROVED EQUAL.
2. REMOVE, REPLACE ALL DAMAGED FLOOR TILE.
3. PUBLIC AREA - CEILING TILE SHALL BE ARMSTRONG OR ACCESSIBLE SYSTEM, 1'-0" x 1'-0" x 5/8" BEVELED EDGE, MOUNTING 24" BELOW STRUCTURE. FOR THE SYSTEM LAY-OUT, SEE REFLECTED CEILING PLAN. MFR. BY CONWED OR U.S.G.
4. ANGLE TRIM SHALL BE 20GA. ABOVE AND BE CLIPPED TO MAIN RUNNERS AND BE CROSS TEES FOR PERIMETER OF N.I.C. PARTITION. N.I.C. PARTITION WILL SECURELY FASTEN HEAD MEMBER TO MAIN RUNNER OR CROSS TEE.
5. GYP. CORNERS TO BE PROTECTED WITH 26GA. CORNER BEAD TACKED AND CEMENTED TO GYP. SUPPORTING METAL STUD.

SECT. DET. AT FASCIA

SCALE 3"=1'-0"

DET. AT DOOR 12
(2-10-15)

GASKET

CLOSER X RT. SIDE HUNG

BASE CLG. EL. 140'-10"

IMPERIAL GYP BASE

PARTITION BEYOND

FACE OF DOOR TRACK

18 MEGA. PACK PT.-D DRYWALL ACOUSTI-SEALANT

FRAME CLIP @ 16" MAX.

KEY PLAN

NORTH

SEE DWG. NO 64/4/27 FOR CONTINUATION OF THIS SECTION

SEE DWG. NO 64/4/28 FOR CONTINUATION OF THIS SECTION

REV.	DATE	ISSUED TO
4	11/17/66	DELETED MASONRY PLANTER AND SHORT 10" WIDE CURB. REVISED DOOR & FRAME OPPOSITE STAIRWAY 2 CHANGE WORK OFFICE OWNER'S CONTRACT
3	4/26/66	REVISED THICKNESS OF WALLS IN WOMEN'S TOILET, BATT, REST, SUP. ON STAFF'S IN MEN'S, NURSE'S
2	8/16/65	ADDED SIDELIGHTS OPERATORS FOR DOORS NO 4,5 AND REVISED FRAME, REVISED FOR 10 OFFICE BLDG
1	6/21/65	ADDED 3 NO. CON. DUCTS, RELOCATED DOOR 45, 2ND FLOOR
A	4/27/65	MOVED SHEATHING IN MEN'S GEN. AREA RELOCATED P.B.X. DOOR AND WIDED DUCT SHAFT IN NURSES CLOS.

REV.	DATE	ISSUED TO
A	3/22/67	WALL BEHIND POL. EQUIPMENT REVISED TO 8" CONC. BLOCK, REVISED DOOR & FRAME OPPOSITE STAIRWAY 2 REVISED FOR 8" CONC. BLOCK
9	2/21/67	REVISED FOR 8" CONC. BLOCK AT POOL EQUIPMENT ROOM NO. 2
8	2/7/67	REVISED ENTRANCE DOOR NO. 1 AND ADDED DOOR NO. 6 AT POST OFFICE

REV.	DATE	ISSUED TO
		ISSUED FOR BIDDING

HARRISON & ABRAMOVITZ
ARCHITECTS
630 FIFTH AVENUE NEW YORK 20, N. Y.

ALBANY, NEW YORK

ALBANY SOUTH MALL PROJECT

MAIN PLATFORM, HEALTH DEPT. LABORATORIES & MEETING CENTER SUPERSTRUCTURES

MAIN PLATFORM, PART 1

DRAWN BY	C. H.
CHECKED BY	A. C. H.
SCALE	3/8"=1'-0"
APPROVED BY	S.S.S.
D.P.W.	


ARCHITECTURAL CONCOURSE
PART FLOOR PLAN


PROJECT NO. 7011.69
SPECIFICATION NO. 20684-C
DATE JULY 10 1967
DRAWING NO. 64/4-28

STATE OF NEW YORK
OFFICE OF GENERAL SERVICES
EVA. SHUTLER - COMMISSIONER
DEPARTMENT OF PUBLIC WORKS — J. B. McMORRAN, SUPERINTENDENT
DIVISION OF ARCHITECTURE — C. E. RAMSDELL, STATE ARCHITECT


44782 ADDENDUM
REFERENCE
DRAWING SET 1

FOR REFERENCE ONLY.
REFERENCE DRAWINGS
MAY NOT REFLECT
ACTUAL CONDITIONS.

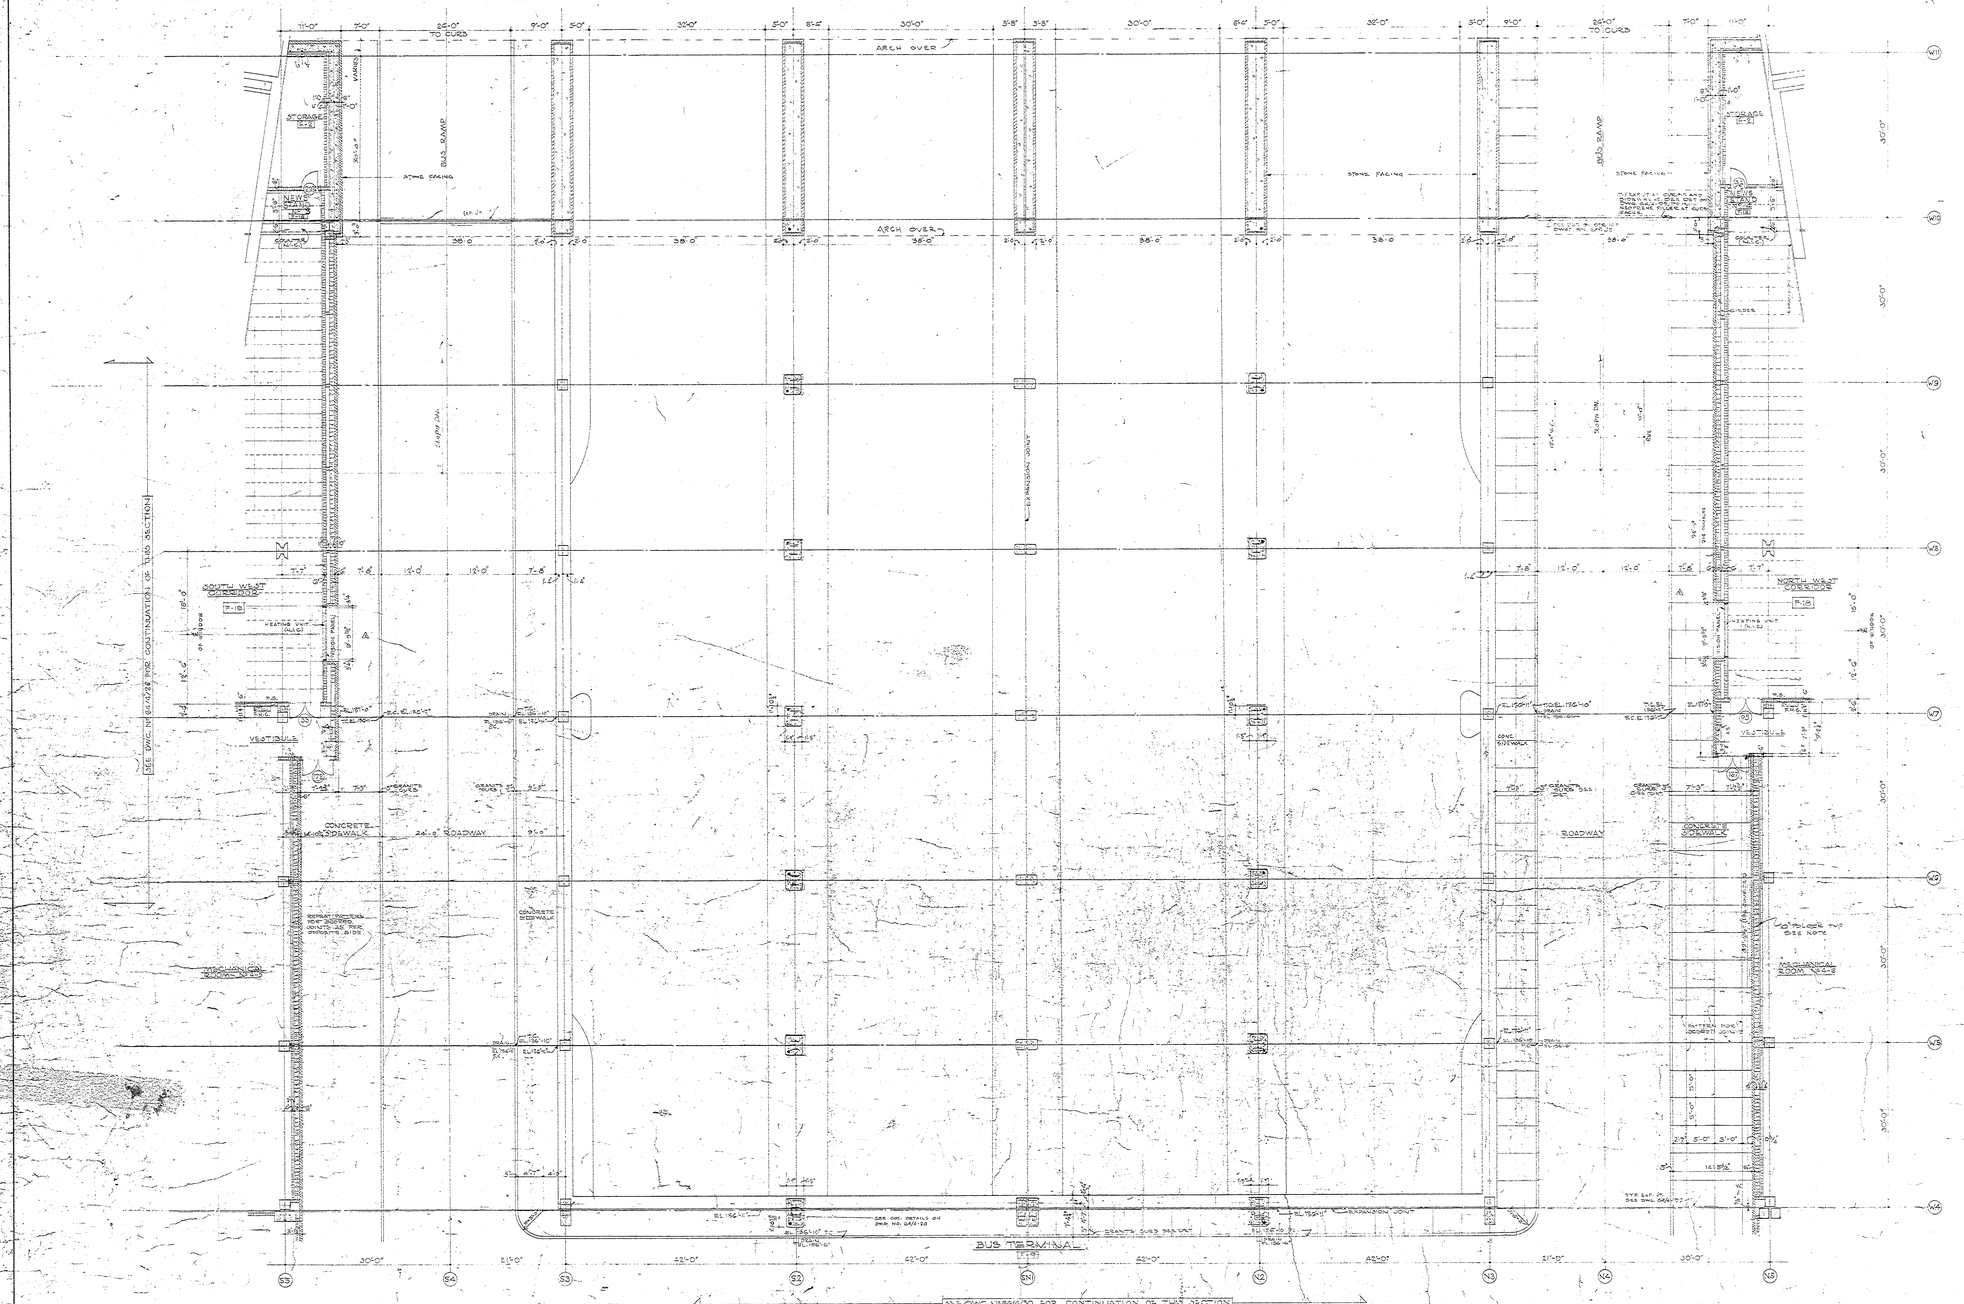

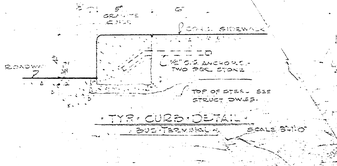

NOTE: USE TYPE M MORTAR FOR 10" BLOCK BACKUP OF STRUCT CLASSIFICATION

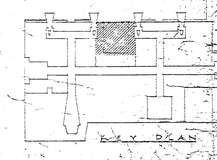

NORTH

HARRISON & ABRAMOVITZ
ARCHITECTS
220 FIFTH AVENUE NEW YORK 20, N.Y.

REV	DATE	ISSUED TO
6	11/6/68	REV. WET COLS. TO AGREE WITH PUB. DWGS.
5	9/18/68	ADDED VISION PANELS, SET COLS W.S.&T. ON 1
4	7/16/68	ADDED BY SUBDIVISION AS STATED UNDER TITLE
3		ADDED BLOCK WALL AT NW CONCOURSE
2	6/5/68	ADDENDUM DRAWING
1		

ALBANY, NEW YORK

ALBANY SOUTH MALL PROJECT

MAIN PLATFORM, HEALTH DEPT. LABORATORIES & MEETING CENTER SUPERSTRUCTURES


PART 1

DRAWN BY: C.H.
TRACED BY: C.H.
CHECKED BY: E.S.S.
APPROVED BY: E.S.S.
DATE: 10-11-67

ARCHITECTURAL CONCOURSE PARK FLOOR PLAN

STATE OF NEW YORK
OFFICE OF GENERAL SERVICES
CARL SCHLEICHER - COMMISSIONER
DEPARTMENT OF PUBLIC WORKS - J.R. MUMFORD, DEPUTY COMMISSIONER
DIVISION OF ARCHITECTURE - EDWARD L. BARNES - STATE ARCHITECT

DRAWING NO. 44748
SHEET NO. 29

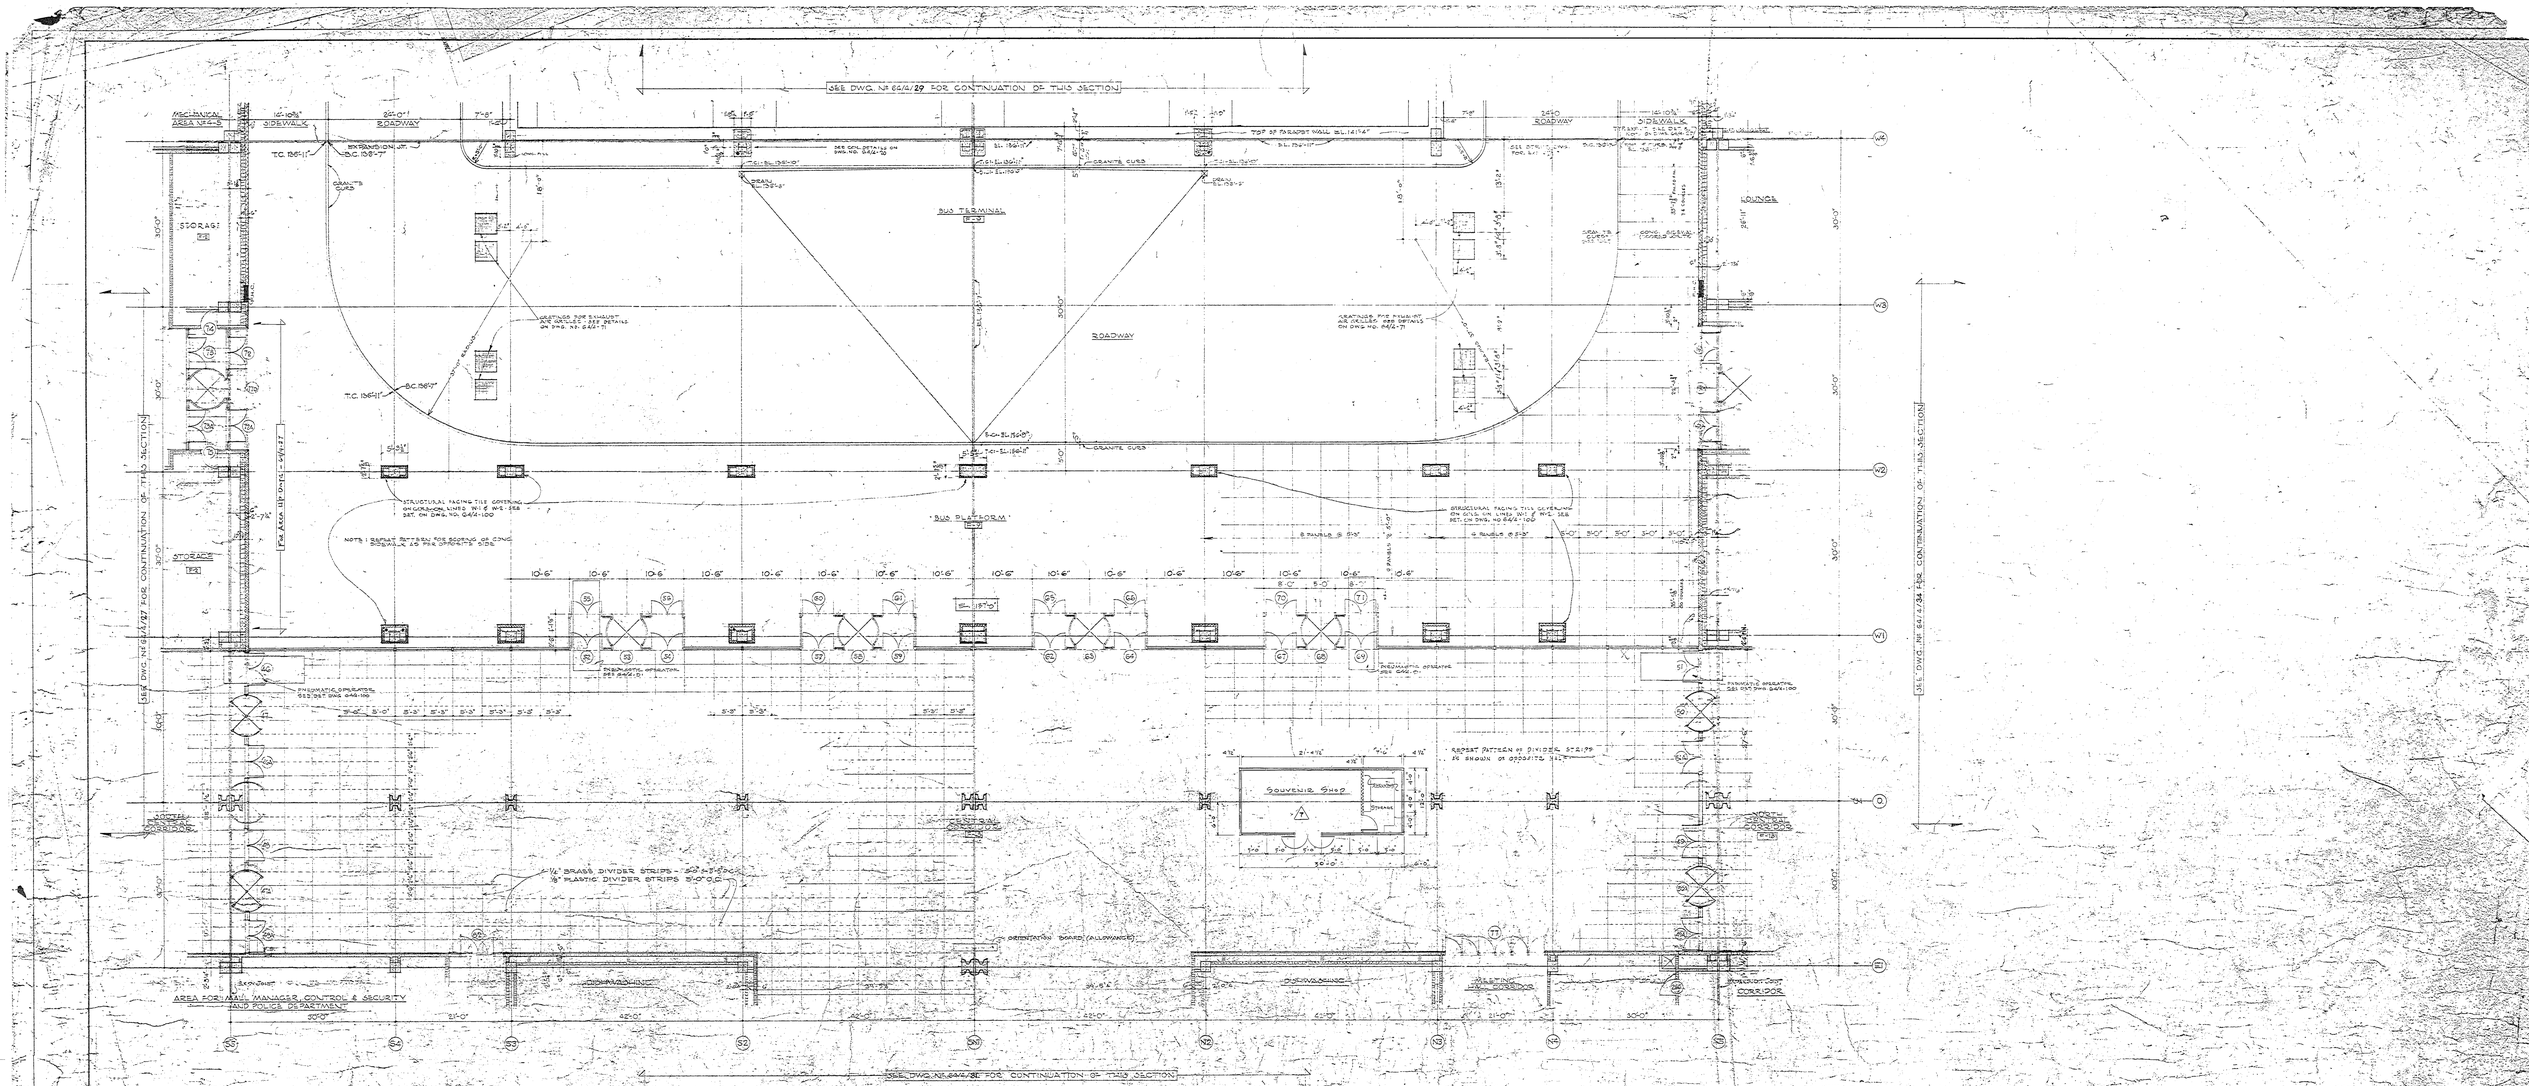
SEE DWG. NO 64/4/29 FOR CONTINUATION OF THIS SECTION
MECHANICAL AREA NO 4-S
16'-10⅝"
SIDEWALK
25'-0"
ROADWAY
EXPANSION JOINT
T.C. 136'-11"
B.C. 135'-7"
GRANITE CURB
STORAGE
BUS TERMINAL
ROADWAY
T.C. 136'-11"
B.C. 136'-7"
B.O.-EL. 136'-0"
T.C.-EL. 136'-6"
GRANITE CURB
STRUCTURAL FACING TILE GOVERNING ON CURBING LINES W-1 & W-2 SEE DET. ON DWG. NO. 64/4-100
NOTE: REPEAT PATTERN FOR ACCESS OR CONG. SIDEWALK AS PER OPPOSITE SIDE
STORAGE
PNEUMATIC OPERATORS SEE DET. DWG. 64/4-100
PNEUMATIC OPERATOR PER DWG. 01
10'-6"
8'-0"
5'-0"
8'-0"
10'-6"
PNEUMATIC OPERATOR
PNEUMATIC OPERATOR SEE DWG. 01
SEE DWG. NO 64/4/27 FOR CONTINUATION OF THIS SECTION
SEE DWG. NO 64/4/31 FOR CONTINUATION OF THIS SECTION
75'0" SF PARAPET WALL EL. 141'-1"
EL. 139'-10"
SEE SOIL DETAILS ON DWG NO. 64/4-10
DRAIN EL. 135'-0"
DRAIN EL. 135'-2"
SEE SOIL DETAILS ON DWG. NO. 64/4-10
GRANITE CURB
SEE SOIL DETAILS ON DWG. NO. 64/4-10
SOIL DETAILS ON DWG. NO. 64/4-10
2440 ROADWAY
SIDEWALK
LOUNGE
GRATINGS FOR EXHAUST AIR INTAKES - SEE DETAILS ON DWG. NO. 64/4-71
GRATINGS FOR EXHAUST AIR DISCHARGE - SEE DETAILS ON DWG. NO. 64/4-71
STRUCTURAL FACING TILE GOVERNING ON GRID ON LINES W-1 & W-2 SEE DET. ON DWG. NO 64/4-100
8 PANELS @ 5'-0"
8 PANELS @ 5'-0"
5'-0"
5'-0"

44782 ADDENDUM REFERENCE DRAWING SET 1

FOR REFERENCE ONLY. REFERENCE DRAWINGS MAY NOT REFLECT ACTUAL CONDITIONS.


KITCHEN EQUIPMENT LIST — (NOT IN CONTRACT)

SEE SPECIFICATION H24736

NO.	ITEM
1	Baker's Table (C)
2	Butcher's Table
3	Meat Slicer
4	Butcher's Table
5	Meat Grinder
6	Refrigerator
7	Vertical Cutter Mixer
8	Work Table
9	Cook's Table, Pot Rack & Sink
10	Mixer
11	Cook's Table w/Sink
12	Convection Oven
13	Convection Oven
14	Deck Oven
15	Deck Oven
16	Kettle & Steamer
17	Kettle & Steamer
18	Broiler
19	Broiler
20	Broiler
21	Range
22	Range
23	Range
24	Range
25	Fryer
26	Spreader
27	Fryer
28	Spreader
29	Fryer
30	Spreader
31	Scullery Sink
32	Pot Storage Rack
33	Vegetable Sink
34	Disposer
35	Vegetable Prep. Sink
36	Peeler
37	Vegetable Prep.Table
38	Refrigerator
39	Vegetable Cutter & Slicer
40	Cook's Table
41	Cook's Table Pot Rack, Sink
42	Work Table
43	Cook's Table
44	Back Counter
45	Heated Dish Caddy
46	Pass-Thru Hot Cabinet
47	Heated Dish Caddy
48	Heated Dish Caddy
49	Back Counter
50	Back Counter w/sink
51	Heated Dish Caddy
52	Pass-Thru Hot Cabinet
53	Back Counter
54	Heated Dish Caddy
55	Roll & Bun Warmer
56	Hot Food Unit Protector Case
57	Roll & Bun Warmer
58	Serving Counter
59	Roll & Bun Warmer
60	Hot Food Unit Protector Case
61	Roll & Bun Warmer
62	Ice Maker
63	Roll-in Refrigerator
64	Back Counter w/Sink
65	Roll-in Refrigerator
66	Refrigerator
67	Back Counter
68	Fryer
69	Griddle
70	Grill Stand
71	Ventilator Unit
72	Back Counter w/Sink
73	Port. Heated Bowl Lowerator
74	Port. Tray Unit
75	Tray Slide
76	Counter w/Salad Section
77	Protector Case
78	Dessert Section
79	Display Shelves
80	Serving Counter
81	Heated Bowl Lowerator
82	Counter
83	Soup Well
84	Sandwich Unit
85	Cashier Stand
86	Cash Register (N.I.C.)
87	Tray Slide
88	Tray Slide
89	Ice Cream Cab.
90	Port. Glass Lowerator
91	Serving Counter
92	Ice Maker & Dispenser
93	Dole Soda Dispenser
94	Milk Lowerator
95	Ice Tea Dispenser
96	Port. Cup & Saucer Dispenser
97	Cream Dispenser
98	Coffee Urn
99	Urn Stand
100	Port. Glass Lowerator
101	Cup & Sauce Lowerator
102	Back Bar w/Refrig. Base
103	Tray Slide
104	Ice Cream Cabinet
105	Portable Glass Lowerator
106	Serving Counter
107	Ice Maker & Dispenser
108	Dole Soda Dispenser
109	Milk Lowerator
110	Ice Tea Dispenser
111	Port. Cup & Saucer Dispenser
112	Cream Dispenser
113	Coffee Urn
114	Urn Stand
115	Cashier Stand
116	Cash Register (N.I.C.)
117	Cashier Stand
118	Cash Register (N.I.C.)
119	Cashier Stand
120	Cash Register (N.I.C.)
121	Serving Counter
122	Tray Slide
123	Dessert Section
124	Protector Case
125	Salad Pan
126	Compressor Housing
127	Omitted
128	Ice Cube Maker
129	Back Counter
130	Roll-in Refrigerator
131	Back Counter w/Sink
132	Roll-in Refrigerator
133	Back Counter w/Sink
134	Portable Tray Units
~~135~~	~~Rolled Dish Table~~
136	Disposer
~~137~~	~~Dishwasher~~
138	Soiled Dish Table
139	Disposer
140	Dishwasher
141	Portable Table
142	Ventilation Unit
143	Ventilation Unit
144	Ventilation Unit
145	Ventilation Unit
146	Ventilation Unit

NO.	ITEM
1-R	Work Table w/sink
2-R	Hot Plate
3-R	Fryer (Counter Type)
4-R	Fryer (Counter Type)
5-R	Grill Stand
6-R	Grill Stand
7-R	Griddle
8-R	Griddle
9-R	Refrigerator
10-R	Sandwich Unit
11-R	Food Heater
12-R	Hot Food Unit
13-R	Serving Counter
14-R	Roll Warmer
15-R	Dish Trucks
16-R	Roll-in Refrigerator
17-R	Back Counter, Sink & Overshelf
18-R	Ice Tea Dispenser
19-R	Urn Stand
20-R	Coffee Urn
21-R	Hood
22-R	Ice Cream Cabinet
23-R	Ice Cube Maker
24-R	Waitress Station SEE NOTE
25-R	Cashier Stand
26-R	Cash Register (N.I.C.)

NOTE: TWO CONDIMENT TABLES 22R & 23R IN FURNITURE CONTRACT

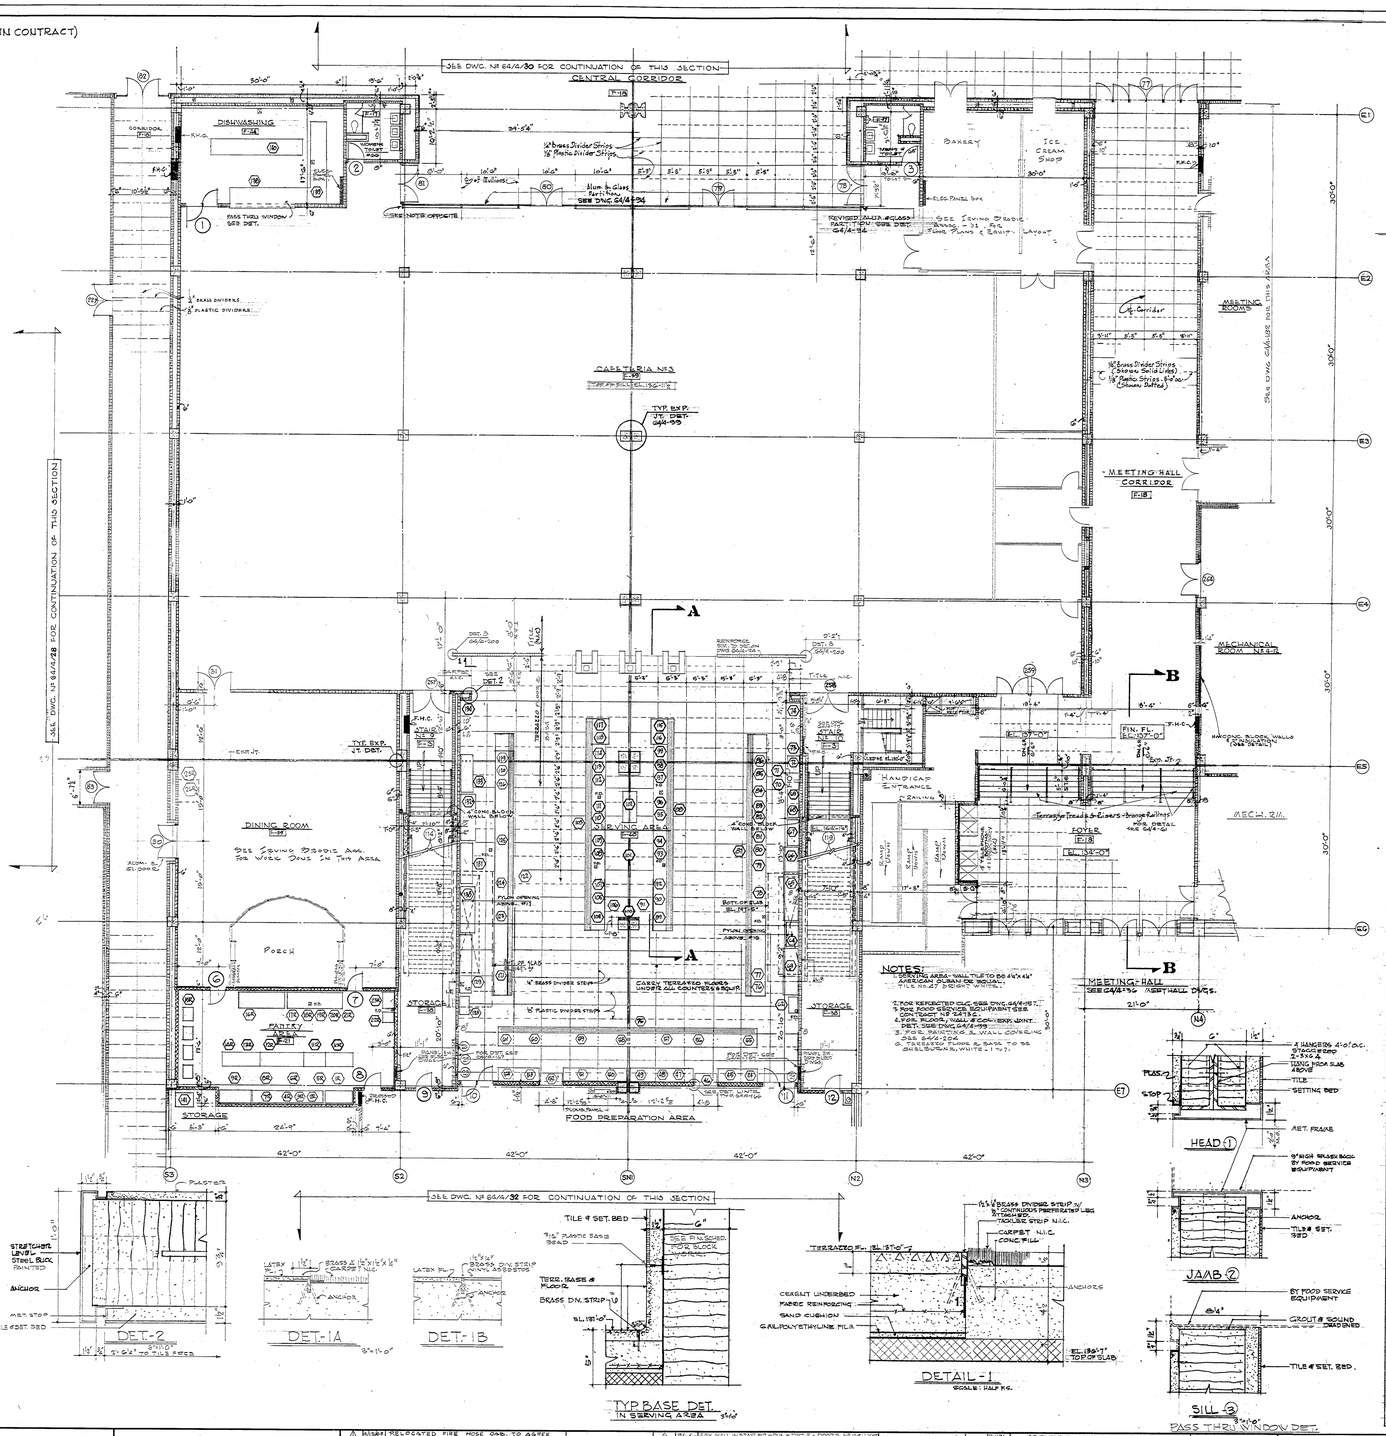

44782 ADDENDUM REFERENCE DRAWING SET 1

FOR REFERENCE ONLY. REFERENCE DRAWINGS MAY NOT REFLECT ACTUAL CONDITIONS.

SEE DWG. № 64/4/28 FOR CONTINUATION OF THIS SECTION

SEE DWG. № 64/4/31 FOR CONTINUATION OF THIS SECTION

SEE DWG. № 64/4/38 FOR CONTINUATION OF THIS SECTION

KITCHEN

SERVING AREA

CAFETERIA № 3 KITCHEN

STORAGE

CORRIDOR

VEGETABLE PREPARATION

MECHANICAL AREA № 4-4-19

FIN. FL. EL. 137.0

AIR PLENUM SEE SHEET SET ON DWG. 64/4/35

20'-0" x 20'-0" ACCESS DOOR

HEAVY WEIGHT CONCRETE BLOCK WALLS WITH 2" INSULATION

BOTTOM OF SUMP EL. 130'-6"

CONCRETE SLAB ABOVE EL. 6

LABORATORY BLDG. SPACE

OFFICE

SEE PART PLAN BELOW PASSAGE

PLAZA KITCHEN

CLG. FINISH LINE

FREEZER

REFRIG. 1

REFRIG. 2

DRY STORES

CAN WASH ROOM

EMPLOYEES DINING ROOM

LOCKER RM.

FOLDING DOOR

PREFAB UNITS

DISHWASHING AREA

FREEZER #1

FREEZER #2

LOUNGES

LOCKER RM.

LAUNDRY

JANITOR'S CLOS.

RESTAURANT ALLOWANCE

TOP OF SLAB

TOP OF SLAB EL. 156'-0"
TOP OF STEEL EL. 150'-9"

GRATE VENT

TOP OF SLAB EL. 137'-6"

CORRIDOR

FIN. FL. EL. 137'-0"

SECTION A-A
BETWEEN COL. 62-63

CAN WASH ROOM

CAULK

3 PLY NEOPRENE WATERPROOFING

SLOPE TO DRAIN

GREEN WORK OR ST. ALL WALLS IN SPACE

TYP. DETAIL 1
1/2" = 1'-0"

PLASTER @ DOORS 106

SETTING BED AS REQ'D TILE

ANCHOR GLAZED BLOCK

1½" @ DRS. 106

1½" SETTING BED TILE DOORS 106 & 107

MET. FRAME

JAMB

PANEL PLASTER OVER PLYWD. ON STUD WALLS

GLAZED BLOCK 2-8"x8"x4" LINTEL

HEAD

DRS. FRAMES FOR PAINTED SAME COLOR AS TILE

MET. POST

POST

SERVING

KITCHEN

8" BLOCK 2-8"x8"x4" LINTEL GLAZED BLOCK

HEAD

SETTING BED

RASTER DRS. 106 (EQUAL FLUSH W/ VALETTE)

ANCHOR GLAZED BLOCK

JAMB

DOORS - 10 & 11
CAFETERIA № 3

NOTE: — DOORS 106, 107, 108 —
1) SIMILAR DOORS CAFETERIA DR. 11 (NO PANEL)
2) " " " " DRS. 9 (NO PANEL)

ELEV. SIDE

JAMB DET.
ELEVATOR № 22

CORRIDOR

ADJUD DOOR

ELEV. #27

SERVICE TRAP IN FLOOR 3" BELOW FINISH FLOOR WITH 4" WATER SEAL

PASSAGE

PART PLAN OF TEMP. ACCESS TO ELEVATOR № 27

DET. 4
(1½" = 1'-0")
NOTE: ALL EXTERNAL CORNERS SHALL BE BULLNOSED.

14 GA. S.S. TRIM

CERAMIC

SETTING BED

DETAIL AT REFRIGERATOR END DOOR. SIMILAR CONDITION IN CERAMIC CONTRACT.
1½" = 1'-0"

STAIN. STEEL CORNER GUARD W/ ANGLE CLIP ON 4" CENTERS AT TOP & BOTTOM & AT MIDDLE OF DOOR HEIGHT
1½" = 1'-0"

STAINLESS STEEL CORNER GUARD W/ ANGLE CLIP ON 4" CENTERS AT TOP & BOTTOM & AT MIDDLE OF DOOR HEIGHT
1½" = 1'-0"

GLAZED BLK.

WELD STRAP ANCHOR TO C

BULL NOSE

MET. BUCK. FRAME

JAMB

GLAZED BLK. 4"x4"x¼" & 4"x8"x¼" L LINTEL

HEAD

DETAIL-2
ELEVATOR DET. 1½" = 1'-0"

8'-0½" STEEL POST

MET. BUCK. FRAME

BULL NOSE

WELD STRAP ANCHOR TO C

4" GLAZED BLK.

8" BLK.

STEEL POST CONC.

SILL

11'-4" TO TOP OF POSTS

NOTE: SEE PLAN DWG. 64/4-160 ELEVATOR № 27

JAMB (ELEVATOR)

DETAIL-3 ELEVATOR
1½" = 1'-0"

NORTH

REG. 64/4-28 FOR ADDITIONAL NOTES.

4" STRUCTURAL GLAZED TILE (TISE PLANS)

NOTE: KITCHEN 4-0" TO HAVE 6" FAT SEAT. SOAP BLOCK

VAPOR BARRIER

CONC. WALL SEE STR. DWGS.

2 COURSES ABOVE F.F.

12 GA. 6" GALV. CAP ANCHORED TO CONC. GROUT

LATEX

WATERPROOFING MEMBRANE

2" INSUL.

6" INSUL.

2" SAND FINISH

2" TOPPING

6" CONC. SLAB

2" X 6" CONC. CURB

E OF DRAIN-SEE MECH. DWGS

DETAIL OF MOP RECEPTOR
AS SET SHOWN FOR 13'-11" LINE 15'-11" O
(PLAZA RESTAURANT)

NOTES:
1. PARTITION STOPS 4" ABOVE CEILING.
2. FOR DOORS FOR PLAZA KITCHEN AREA SEE SHT. 64/4-38.
3. FOR TOILETS SEE DWG. 64/4-18.
4. FOR REFLECTED CEILING SEE DWG. 64/4-157.
5. FOR CAFETERIA № 3 DOORS SEE DWG. 64/4-31
6. FOR BRACING OF WALLS & CEILING SEE DWG. 64/1-21

KEY PLAN

REV	DATE	ISSUED TO
1	10/16/64	ADD. GRID L-EE-ES AROUND ADDN. FOR KIT. PLAN; ADDED REF. PLAN TO TRAY ACCESS TO ELEV. FOR ST. ADDED DOOR 7K EXTERIOR KITCHEN
2	04/17/64	ADDED GRATING IN MECH. EQ. ATT. WALL DOOR, 3/2 ALUMINUM AREA SANITARY FOR PLAZA RESTAURANT. NOTES 1 & 2 ADDED TO 2
3	07/17/64	ADDED GRATING IN MECH. EQ. ATT. WALL DOOR, 3/2 ALUMINUM AREA SANITARY FOR PLAZA RESTAURANT. NOTES 1 & 2 ADDED TO 2
		DR. 9 ADD. DOOR, DOOR AND FRAME TO BE 3-0" x 6'-8" x 1¾" SOLID ALUM. DOOR & FRAME SEE SHT. 3 FOR DOOR SCH.
		DR. 106, 107, 108 ADD. DOORS TO BE 3-0" x 6'-8" x 1¾" SOLID ALUM. DOOR & FRAME SEE SHT. 3 FOR DOOR SCH.

REV	DATE	ISSUED TO
1	8/31/64	CAFETERIA KITCHEN "A" ROOM CHANGE IN MORTAR CURB, ADDED DRAIN & DRAIN TO SANITARY SEWER, ADDED DOOR 106
		DR. 106 - MAKE VERTICAL 4" PIPE RAIL ON THIS DOOR
		SEE WALL DIMENSIONS
2	9/17/64	ADDED DRAIN & DRAIN TO SANITARY SEWER, ADDED DOOR 108 & DRAIN TO SANITARY SEWER, ADDED DRAIN & DRAIN TO SANITARY SEWER
		WALL TH. INCREASED 8", SEE SHT. 64/4-38 FOR REVISED LIMITS
3	10/7/64	REV. WALL SEE - DRAIN - FIN. FLR. EL.
4	10/9/64	ADD DOOR 106 - DETAIL - FLOOR EL. REV.
5	10/14/64	REV. DOOR 9, LOUNGES AND LAUNDRY, ADDED DOOR 107
		ADD DRAINS & DRAIN TO SANITARY SEWER

REV	DATE	ISSUED TO
1	7/9/65	REVISED DRAWING TO SHOW CHANGE IN DOOR SIZES & ADDED DOOR 109
		ADDED WINDOWS AT PLAZA KITCHEN AREA
		ADD - DRAIN IN AREA OF STEEL POST AT SOUTH END OF BUILDING
2	8/27/65	CHANGE 8" BLOCK WALL TO 12" BLOCK WALL
		NOTES TO BE ADDED TO DRAWING
		DELETE DOOR 106
3	9/27/65	DELETE TO FIRST 10 FEET IN KITCHEN OFFICE & VALET, 21 NEW DR. FOR VISION PANEL TO ADJOIN WITH SHOP DWG. SEE WALL AS SHOWN ON DWG. 64/4-38
		ADD WHITE WIRE TILE IN LAV. CLOSET AT 22'
4	10/6/65	CAFETERIA № 3 - OMITTED STEERING WELL - OMITTED LED. SEC. DOT. DRAINS ROOMS & STORAGE FLOOR, SHEETS UNDER WALL - ADD SHEET 3

RE-BID DRAWING

HARRISON & ABRAMOVITZ
ARCHITECTS
630 FIFTH AVENUE NEW YORK 20, N. Y.

ALBANY, NEW YORK

ALBANY SOUTH MALL PROJECT

MAIN PLATFORM, HEALTH DEPT. LABORATORIES & MEETING CENTER SUPERSTRUCTURES

MAIN PLATFORM PART 1

DRAWN BY	Z.H. A.S
CHECKED BY	A.E.H.
SCALE	1/8"-1'-0
APPROVED BY	O.G.S.
O.P.W.	

ARCHITECTURAL
CONCOURSE
PART FLOOR PLAN

PROJECT NO. 2017-01

SPECIFICATION № 2017-01-2

DATE JULY 10, 1967


DRAWING NO. 64/4-32

STATE OF NEW YORK
OFFICE OF GENERAL SERVICES
DIA. BOMPLIER - COMMISSIONER
DEPARTMENT OF PUBLIC WORKS — J. D. MURPHAN, SUPERINTENDENT
DIVISION OF ARCHITECTURE — C. D. KANEKOS, STATE ARCHITECT

OFFICE COPY

44782 ADDENDUM REFERENCE DRAWING SET 1

FOR REFERENCE ONLY. REFERENCE DRAWINGS MAY NOT REFLECT ACTUAL CONDITIONS.

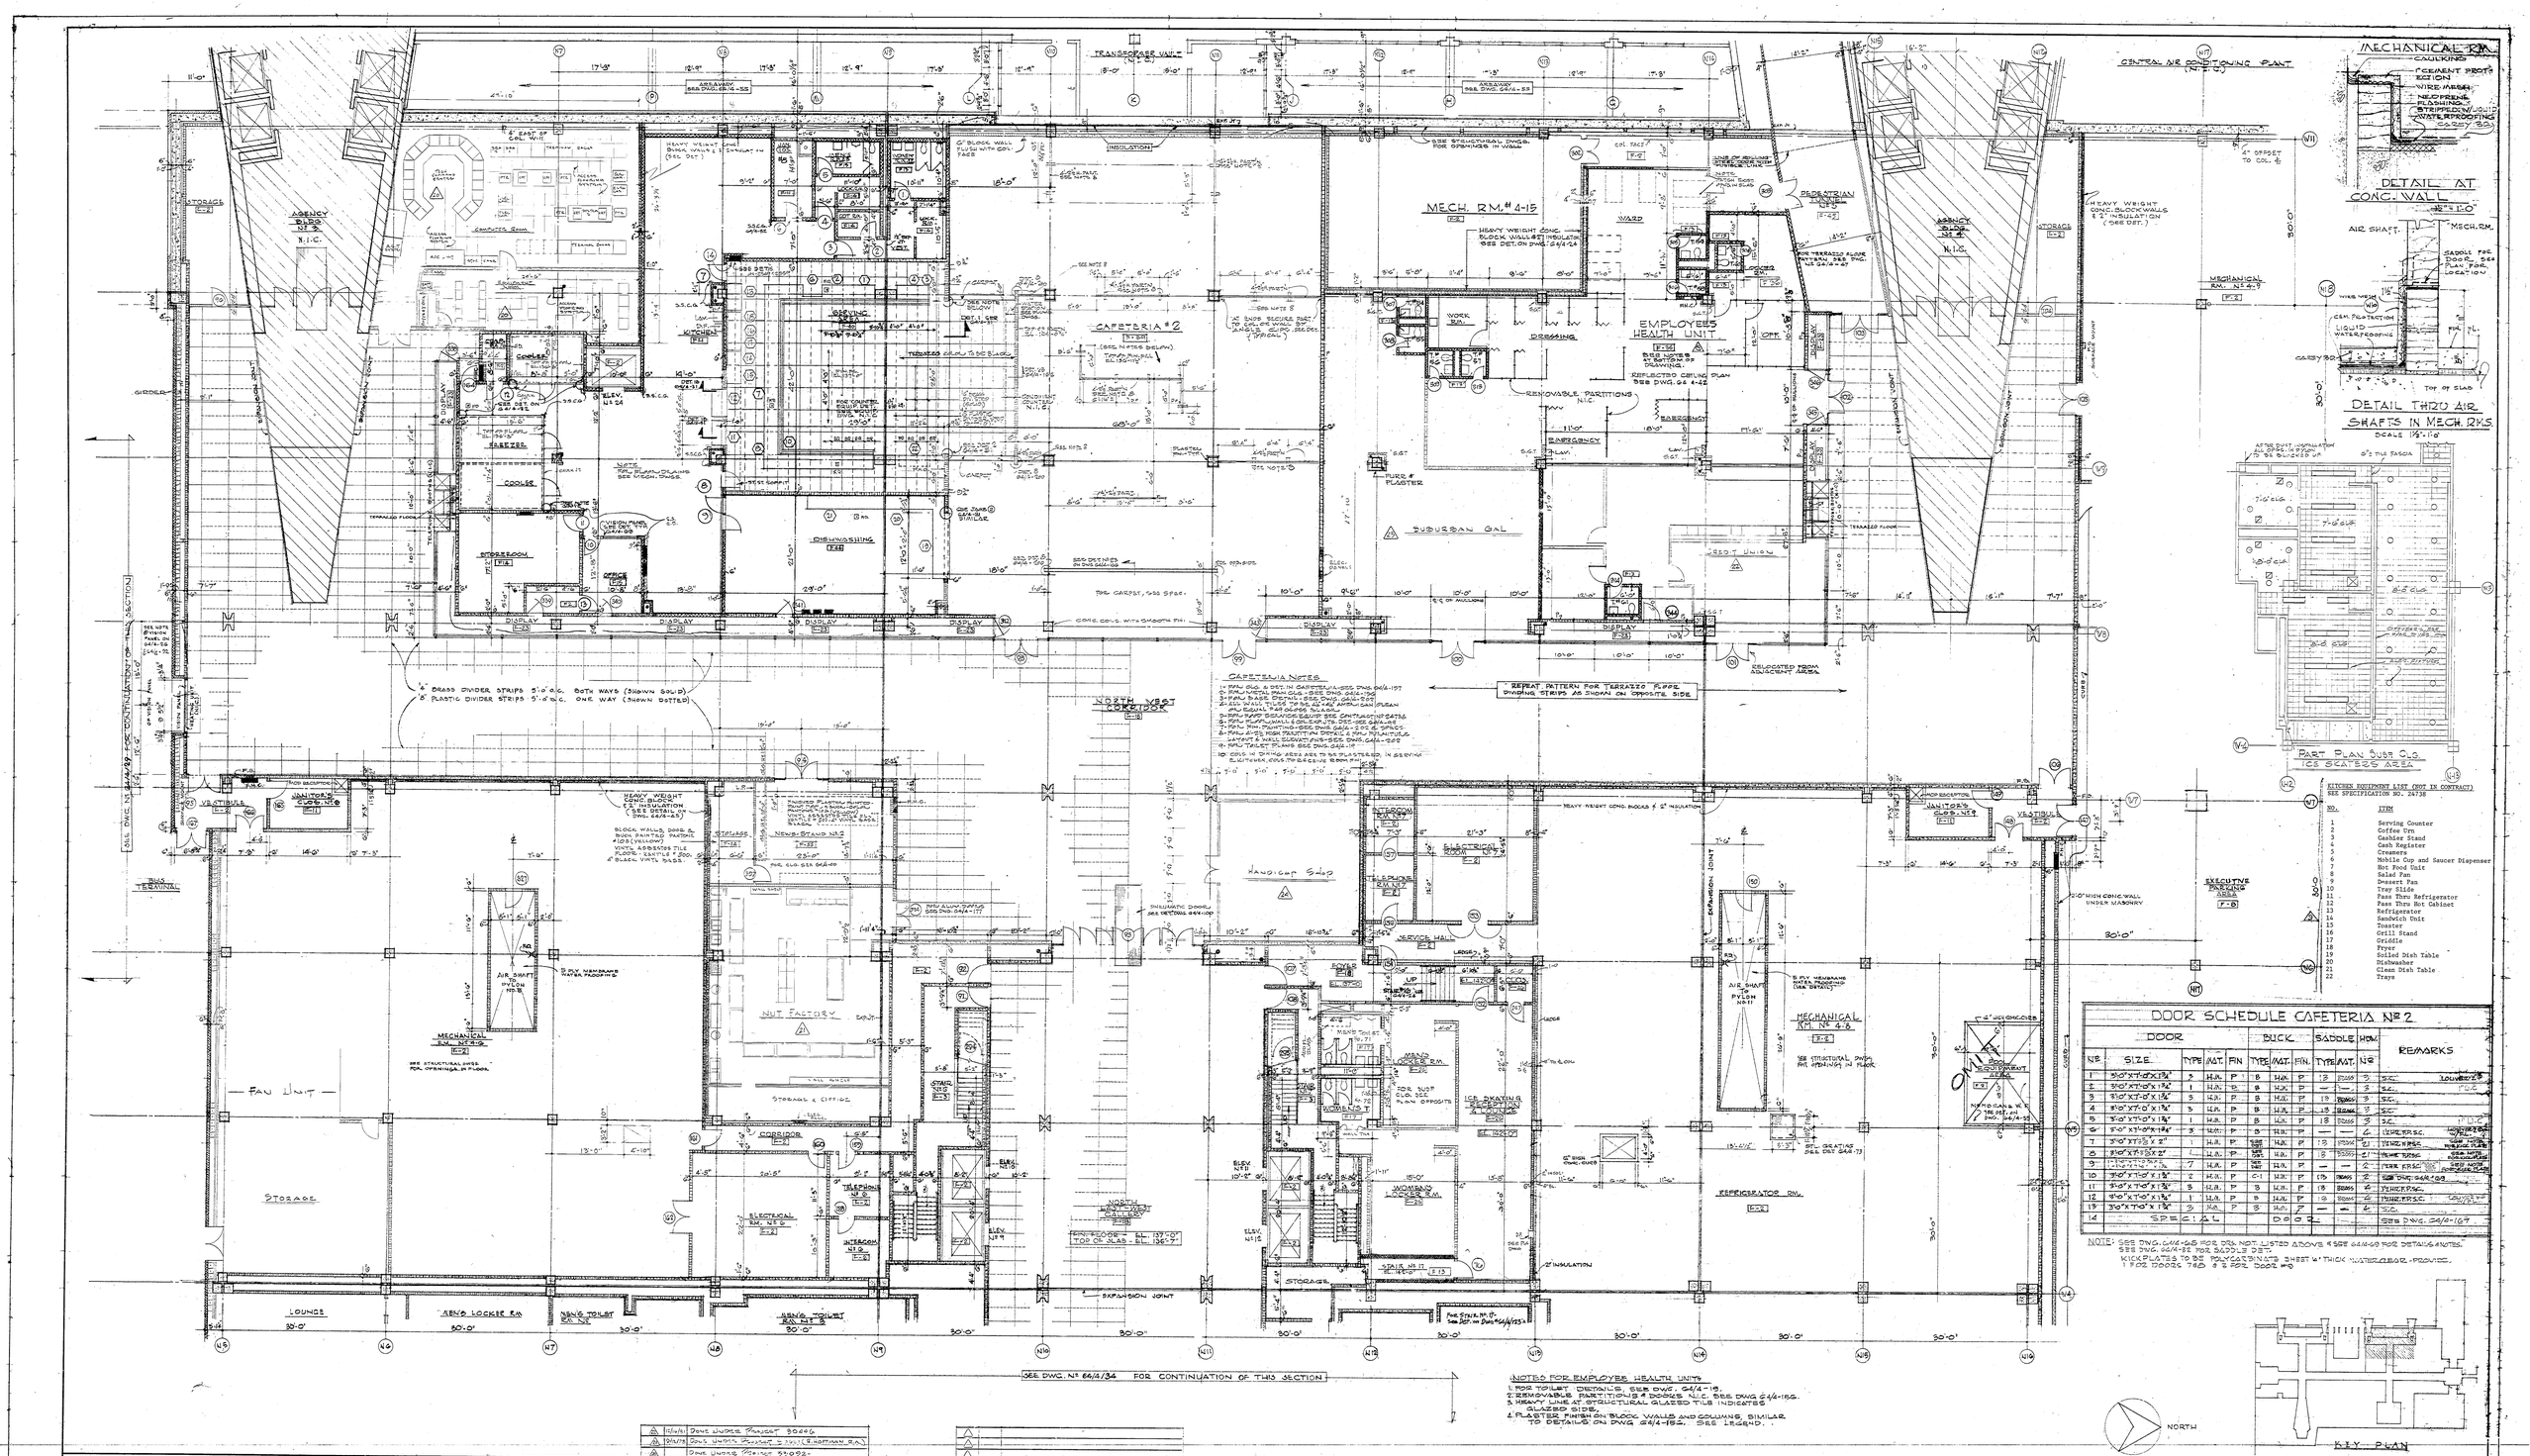

CAFETERIA NOTES

11. TOILET PLANS SEE DWG. G4/4-19
12. COLOR SCHEDULE AS PER ARCHITECT'S DIRECTIONS

NOTED FOR EMPLOYEE HEALTH UNITS

1. FOR TOILET DETAILS, SEE DWG. G4/4-19.
2. REMOVABLE PARTITIONS & DOORS N.I.C. SEE DWG G4/4-156.
3. HEAVY LINE AT STRUCTURAL GLASS TILE INDICATES GLAZED SIDES.
4. PLASTER FINISH ON BLOCK WALLS AND COLUMNS SIMILAR TO DETAILS ON DWG G4/4-152. SEE LEGEND.

DOOR SCHEDULE CAFETERIA Nº 2

NO	DOOR SIZE	DOOR TYPE	DOOR MAT.	DOOR FIN	BUCK TYPE	BUCK MAT.	BUCK FIN.	SADDLE TYPE	SADDLE MAT.	HDW NO	REMARKS
1	3'0"X7'-0"X1¾"	3	H.M.	P	1	H.M.	P	13	STAINLESS STEEL	3	S.C. LOUVERED
2	3'0"X7'-0"X1¾"	1	H.M.	P	1	H.M.	P	—	—	3	S.C. FLAT
3	3'0"X7'-0"X1¾"	3	H.M.	P	1	H.M.	P	13	STAINLESS STEEL	3	S.C.
4	3'0"X7'-0"X1¾"	3	H.M.	P	1	H.M.	P	13	STAINLESS STEEL	3	S.C.
5	3'-0" X7'-0" X 1¾"	1	H.M.	P	1	H.M.	P	13	STAINLESS STEEL	3	S.C. FLAT
6	3'-0" X7'-0"X1¾"	3	H.M.	P	1	H.M.	P	—	—	6	LOUVERED S.C.
7	3'-0" X7'-0" X 2"	1	H.M.	P	SEE DET.	H.M.	P	13	STAINLESS STEEL	21	LOUVERED S.C.
8	3'0"X7'-0"X2"	1	H.M.	P	1	H.M.	P	13	STAINLESS STEEL	21	LOUVERED S.C.
9	1'-10"X7'-0"X1¾"	7	H.M.	P	SEE DET.	H.M.	P	—	—	2	TERR. F.R.S.C.
10	3'0" X7'-0" X 1¾"	2	H.M.	P	C-1	H.M.	P	13	STAINLESS STEEL	2	TERR. F.R.S.C.
11	3'-0"X 7'-0" X 1¾"	3	H.M.	P	3	H.M.	P	13	STAINLESS STEEL	2	LOUVERED F.R.S.C.
12	3'0" X 7'-0" X 1¾"	1	H.M.	P	3	H.M.	P	13	STAINLESS STEEL	2	LOUVERED F.R.S.C.
13	3'0"X 7'0" X 1¾"	3	H.M.	P	3	H.M.	P	—	—	6	S.C.
14	SPECIAL									D.O.D.	SEE DWG. G4/4-167

NOTE: SEE DWG. G4/4-165 FOR DR. NOT LISTED ABOVE & SEE G4/4-169 FOR DETAILS & NOTES. SEE DWG. G4/4-32 FOR SADDLE DET.
KICKPLATES TO BE POLYCARBONATE SHEET 16" THICK WATERGLASS - PROVIDE 1 PAIR DOORS THIS # IS FOR DOOR #12

KITCHEN EQUIPMENT LIST (NOT IN CONTRACT) SEE SPECIFICATION NO. 24738

NO.	ITEM
1	Serving Counter
2	Coffee Urn
3	Cashier Stand
4	Cash Register
5	Creamers
6	Mobile Cup and Saucer Dispenser
7	Hot Food Unit
8	Salad Pan
9	Dessert Pan
10	Tray Slide
11	Pass Thru Refrigerator
12	Pass Thru Hot Cabinet
13	Refrigerator
14	Sandwich Unit
15	Toaster
16	Grill Stand
17	Griddle
18	Fryer
19	Soiled Dish Table
20	Dishwasher
21	Clean Dish Table
22	Trays

REV	DATE	ISSUED TO
4	11/6/61	Done Under Project 30260
3	10/1/58	Done Under Project 3-3001 (Coffman Rd.)
2		Done Under Project 57-002
1	4/5/52	Issued for Limited Bids. Red Book 3221. Substitutes, Heavy Unit Welded Coils
0	7/5/51	Issued as per C.A. 1/6, 2/7/51 Dimensions, Details and Notes as Shown on Blue Prints

REV	DATE	ISSUED TO
2	2-28-51	ADDED 2 DIVISION PANEL SETS, G2&3 & 4-7
1	9/21/51	ADDED 2 DIVISION PANEL SETS, G2&3 & 4-7 REVISED PANEL SETS G4/4-197 & 198 ADDED UNIT AREAS & M.E.C. 4-15.
0	9/5/51	ADDED WASTE HANDLING STATIONS W15, W16, W17, W1 ADDED DOORS 26, 28 & 216.



REVISED ARCHITECT'S SEAL

HARRISON & ABRAMOVITZ
ARCHITECTS
630 FIFTH AVENUE NEW YORK 20, N. Y.

ALBANY NEW YORK

ALBANY SOUTH MALL PROJECT

MAIN PLATFORM, HEALTH DEPT. LABORATORIES & MEETING CENTER SUPERSTRUCTURES
MAIN PLATFORM PART 1

DRAWN BY	Z.H., A.S.
TRACED BY	A.S.H.
SCALE	1/8"=1'-0"
APPROVED BY	G.S.A.
DATE	


ARCHITECTURAL
CONCOURSE
PART FLOOR PLAN

PROJECT NO. 72163
DESCRIPTION NO. -20154-C
DATE JULY 30, 1962
DRAWING NO. G4/4-33

STATE OF NEW YORK
OFFICE OF GENERAL SERVICES
CARL SCHUYLER - COMMISSIONER
DEPARTMENT OF PUBLIC WORKS — J. B. MARKHAM, ASSOC. MEMBER
DIVISION OF ARCHITECTURE — C. L. RAYMOND, STATE ARCHITECT

44782 ADDENDUM REFERENCE DRAWING SET 1

FOR REFERENCE ONLY. REFERENCE DRAWINGS MAY NOT REFLECT ACTUAL CONDITIONS.

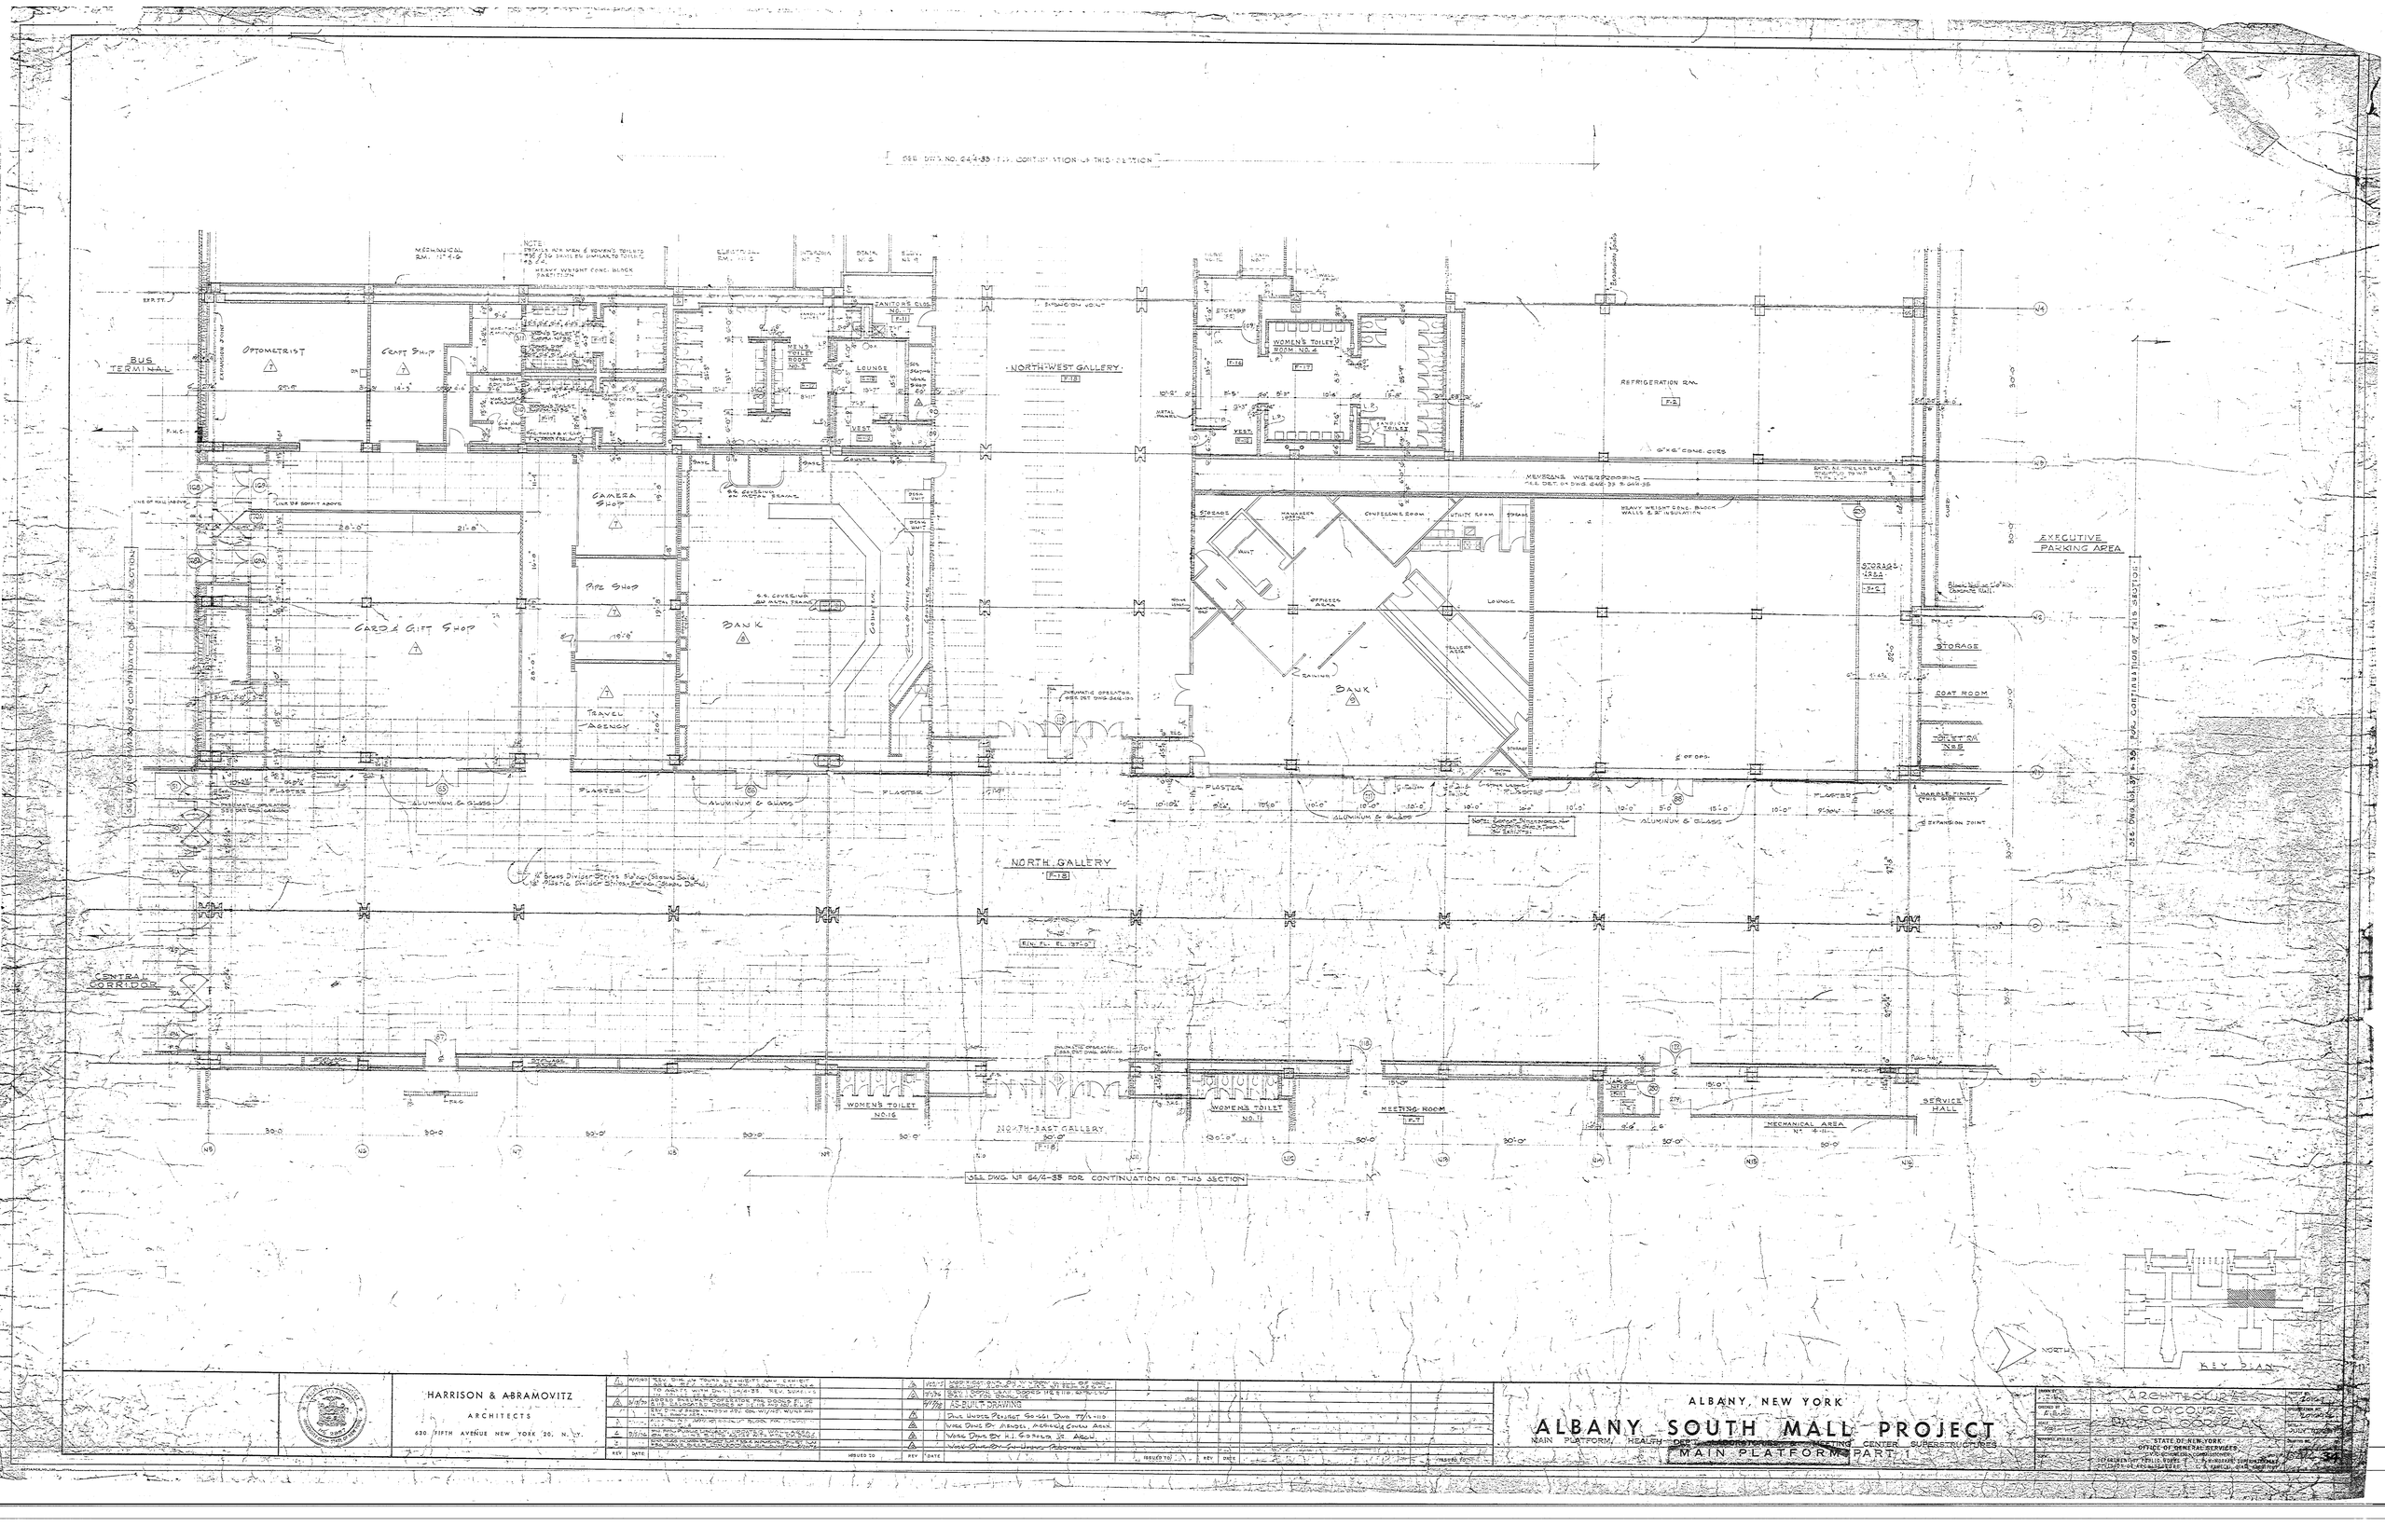

HARRISON & ABRAMOVITZ
ARCHITECTS
630 FIFTH AVENUE NEW YORK 20, N.Y.

REV	DATE	ISSUED TO
1	11/5/63	REV. DIM. AS TOLD BY EXHIBITS AND CHANGE AREA REF. TO AGREE W/ AS BUILT SEC. TO AGREE WITH DWG. 64/4-35 REV. SLOPES
2	5/4/64	REVISED AS NOTED TO CONFORM TO AS BUILT CONDITIONS
3		REV. DIM. AS TOLD BY OWNER
4		REV. DIM. AS TOLD BY OWNER
5	7/27/64	REVISED AS NOTED TO CONFORM TO AS BUILT CONDITIONS
6	7/27/64	REVISED AS NOTED TO CONFORM TO AS BUILT CONDITIONS
7		REVISED AS NOTED TO CONFORM TO AS BUILT CONDITIONS

REV	DATE	ISSUED TO
1	10/5/67	MODIFICATIONS AS SHOWN TO REFLECT AS BUILT CONDITIONS
2	7/1/74	REVISED TO SHOW LEAD LINED TILE WITH APPLIED PAINT FOR SHIELDING
3	7/1/74	AS-BUILT DRAWING
4		SEE UNDER PROJECT 66-161 DWG 77/1-110
5		WORK DONE BY MENDEL MORRIS CONN. ASSN.
6		WORK DONE BY H.J. GOSLIN JR. ASSN.
7		WORK DONE BY SU-JOHN ASSOCIATES

REV	DATE	ISSUED FOR

ALBANY, NEW YORK

ALBANY SOUTH MALL PROJECT

MAIN PLATFORM, HEALTH DEPT. LABORATORIES & MEETING CENTER SUPERSTRUCTURES

MAIN PLATFORM PART 1

DRAWN BY	J.C.S.
CHECKED BY	E.J.L.
SCALE	1/8" = 1'-0"
NUMBER AS BUILT	64/4-34
DATE	JULY 1963

ARCHITECTURE
CONCOURSE
1963

"STATE OF NEW YORK"
OFFICE OF GENERAL SERVICES
EDWARD K. CHESEBRO, COMMISSIONER
DEPARTMENT OF PUBLIC WORKS
CONSTRUCTION SECTION

SHEET NO. 34
SUPERSEDES SHEET NO.
SUPERSEDED BY SHEET NO.
DATE JULY 1963

44782 ADDENDUM REFERENCE DRAWING SET 1

FOR REFERENCE ONLY. REFERENCE DRAWINGS MAY NOT REFLECT ACTUAL CONDITIONS.

SEE DWG. NO 64/4/34 FOR CONTINUATION OF THIS SECTION

NORTH GALLERY
EL. 137'-0"

SEE DWG. NO 64/4/31 FOR CONTINUATION OF THIS SECTION

SEE DWG. NO 64/4/35 FOR CONTINUATION OF THIS SECTION

SEE DWG. NO 64/4/38 FOR CONTINUATION OF THIS SECTION

NOTE
MAIN PLATFORM CONTRACT - DELETED AREAS
1. OMITTED DOORS 331, 17 FABRICATED CULVER TO OWNER. OMITTED DOORS 250, 269, 283.
2. DOOR 320 & 352 TO BE DELIVERED TO MTG. RM. CONTRACTOR, BY OWNER.
3. M.P. DOOR 267 TO HAVE TRANSOM. SEE 64/4/38 DET. 22
4. OMITTED SOUNDING FLOOR, INSULATION & FIN. FILL.

DELETED FROM CONTRACT
SEE MEETING RM. DRAWINGS

MEETING ROOMS 1 TO 3 INCL.
FOR PLAN OF MEETING RMS. AND CORRIDOR, SEE DWG. 64/4-182

CORRIDOR

MEETING HALL CORRIDOR
FIN. FL. EL. 137'-0"

ENTRANCE LOBBY
T-1B

WOMEN'S TOILET RM. NO. 16
T-1T

POWDER RM.
T-1G

PNEUMATIC AIR TUBE STA. SEE DET. DWG. 64/4/-185

WOMEN'S TOILET RM. No. 11

POWDER RM.

NOTE
MAIN PLATFORM CONTRACT - DELETED AREAS
1. OMITTED DOORS 333, 334, 390, 337. IF FABRICATED DELIVER TO OWNER.
2. DOOR 5, BUCK FOR DOOR 332 TO BE DELIVERED TO MTG. RM. CONTRACTOR, BY OWNER.
3. OMITTED SPECIFIED FLOOR INSULATION & FIN. FILL.

DELETED FROM CONTRACT
SEE MEETING RM. DRAWINGS

MEETING ROOM 11 G
FOR PLAN OF MEETING ROOM, TOILETS, LOBBY, COAT ROOM, JAN. CLOS. N° 13 SEE DWG. 64/4-186

ENTRANCE LOBBY

COAT RM.

JAN. CLOS. N° 12

PUBLIC CORR.

NORTH EAST CORRIDOR

MECHANICAL RM. NO. 4-12 F-2

MECHANICAL RM. NO. 4-11 F-2

SERVICE HALL F-2

POOL EQUIPMENT F-1

SERVICE HALL

UNIFORM STORAGE

ELECTRICAL RM. NO.

INTERCOM. RM. NO.

STORAGE

PART OF JUSTICE BLDG.

MEN'S TOILET RM. NO. 15 F-1T

VEST. F-2

STEEL GRATINGS SEE DET. 64/4-73

ELECTRICAL RM. NO. 5 F-2

TEL. RM. NO. 5 F-2

INTERCOM RM. NO. 5 F-2

MEN'S TOILET RM. NO. 14 F-1T

JAN. CLOS. NO. 14

SERVICE HALL F-2

STORAGE EL. 134'-0"

FOYER (FIN. FL. EL. 134'-0")

PROJECTION ROOM EL. 158'-0"

MTG. RM. EXIT PASSAGE EL. 134'-0"

MEETING HALL (FIN. FL. 134'-0")

MEETING CENTER LOBBY

PLENUM RELATIONS OFF.

OFFICE

STORAGE

BUDGET DIV. OFFICE

BUSINESS MANAGER OFFICE

GENERAL OFFICE

OPERATION'S DIV. OFFICE

TICKET OFFICE SEE DWG. 64/4/31 FOR DET.

OFFICE & MAIL ROOM

STOR.

TICKET RAILING N.I.C.

PLATFORM EL. 158'-0"

GREEN ROOM EL. 158'-0"

DRESSING ROOM

STORAGE

GREEN ROOM TOILET

M. TOILET RM. NO. 13

M. TOILET RM. NO. 18

ELEV. N° 15

ELEV. N° 16

ELEV. N°

44782 ADDENDUM REFERENCE DRAWING SET 1

FOR REFERENCE ONLY. REFERENCE DRAWINGS MAY NOT REFLECT ACTUAL CONDITIONS.

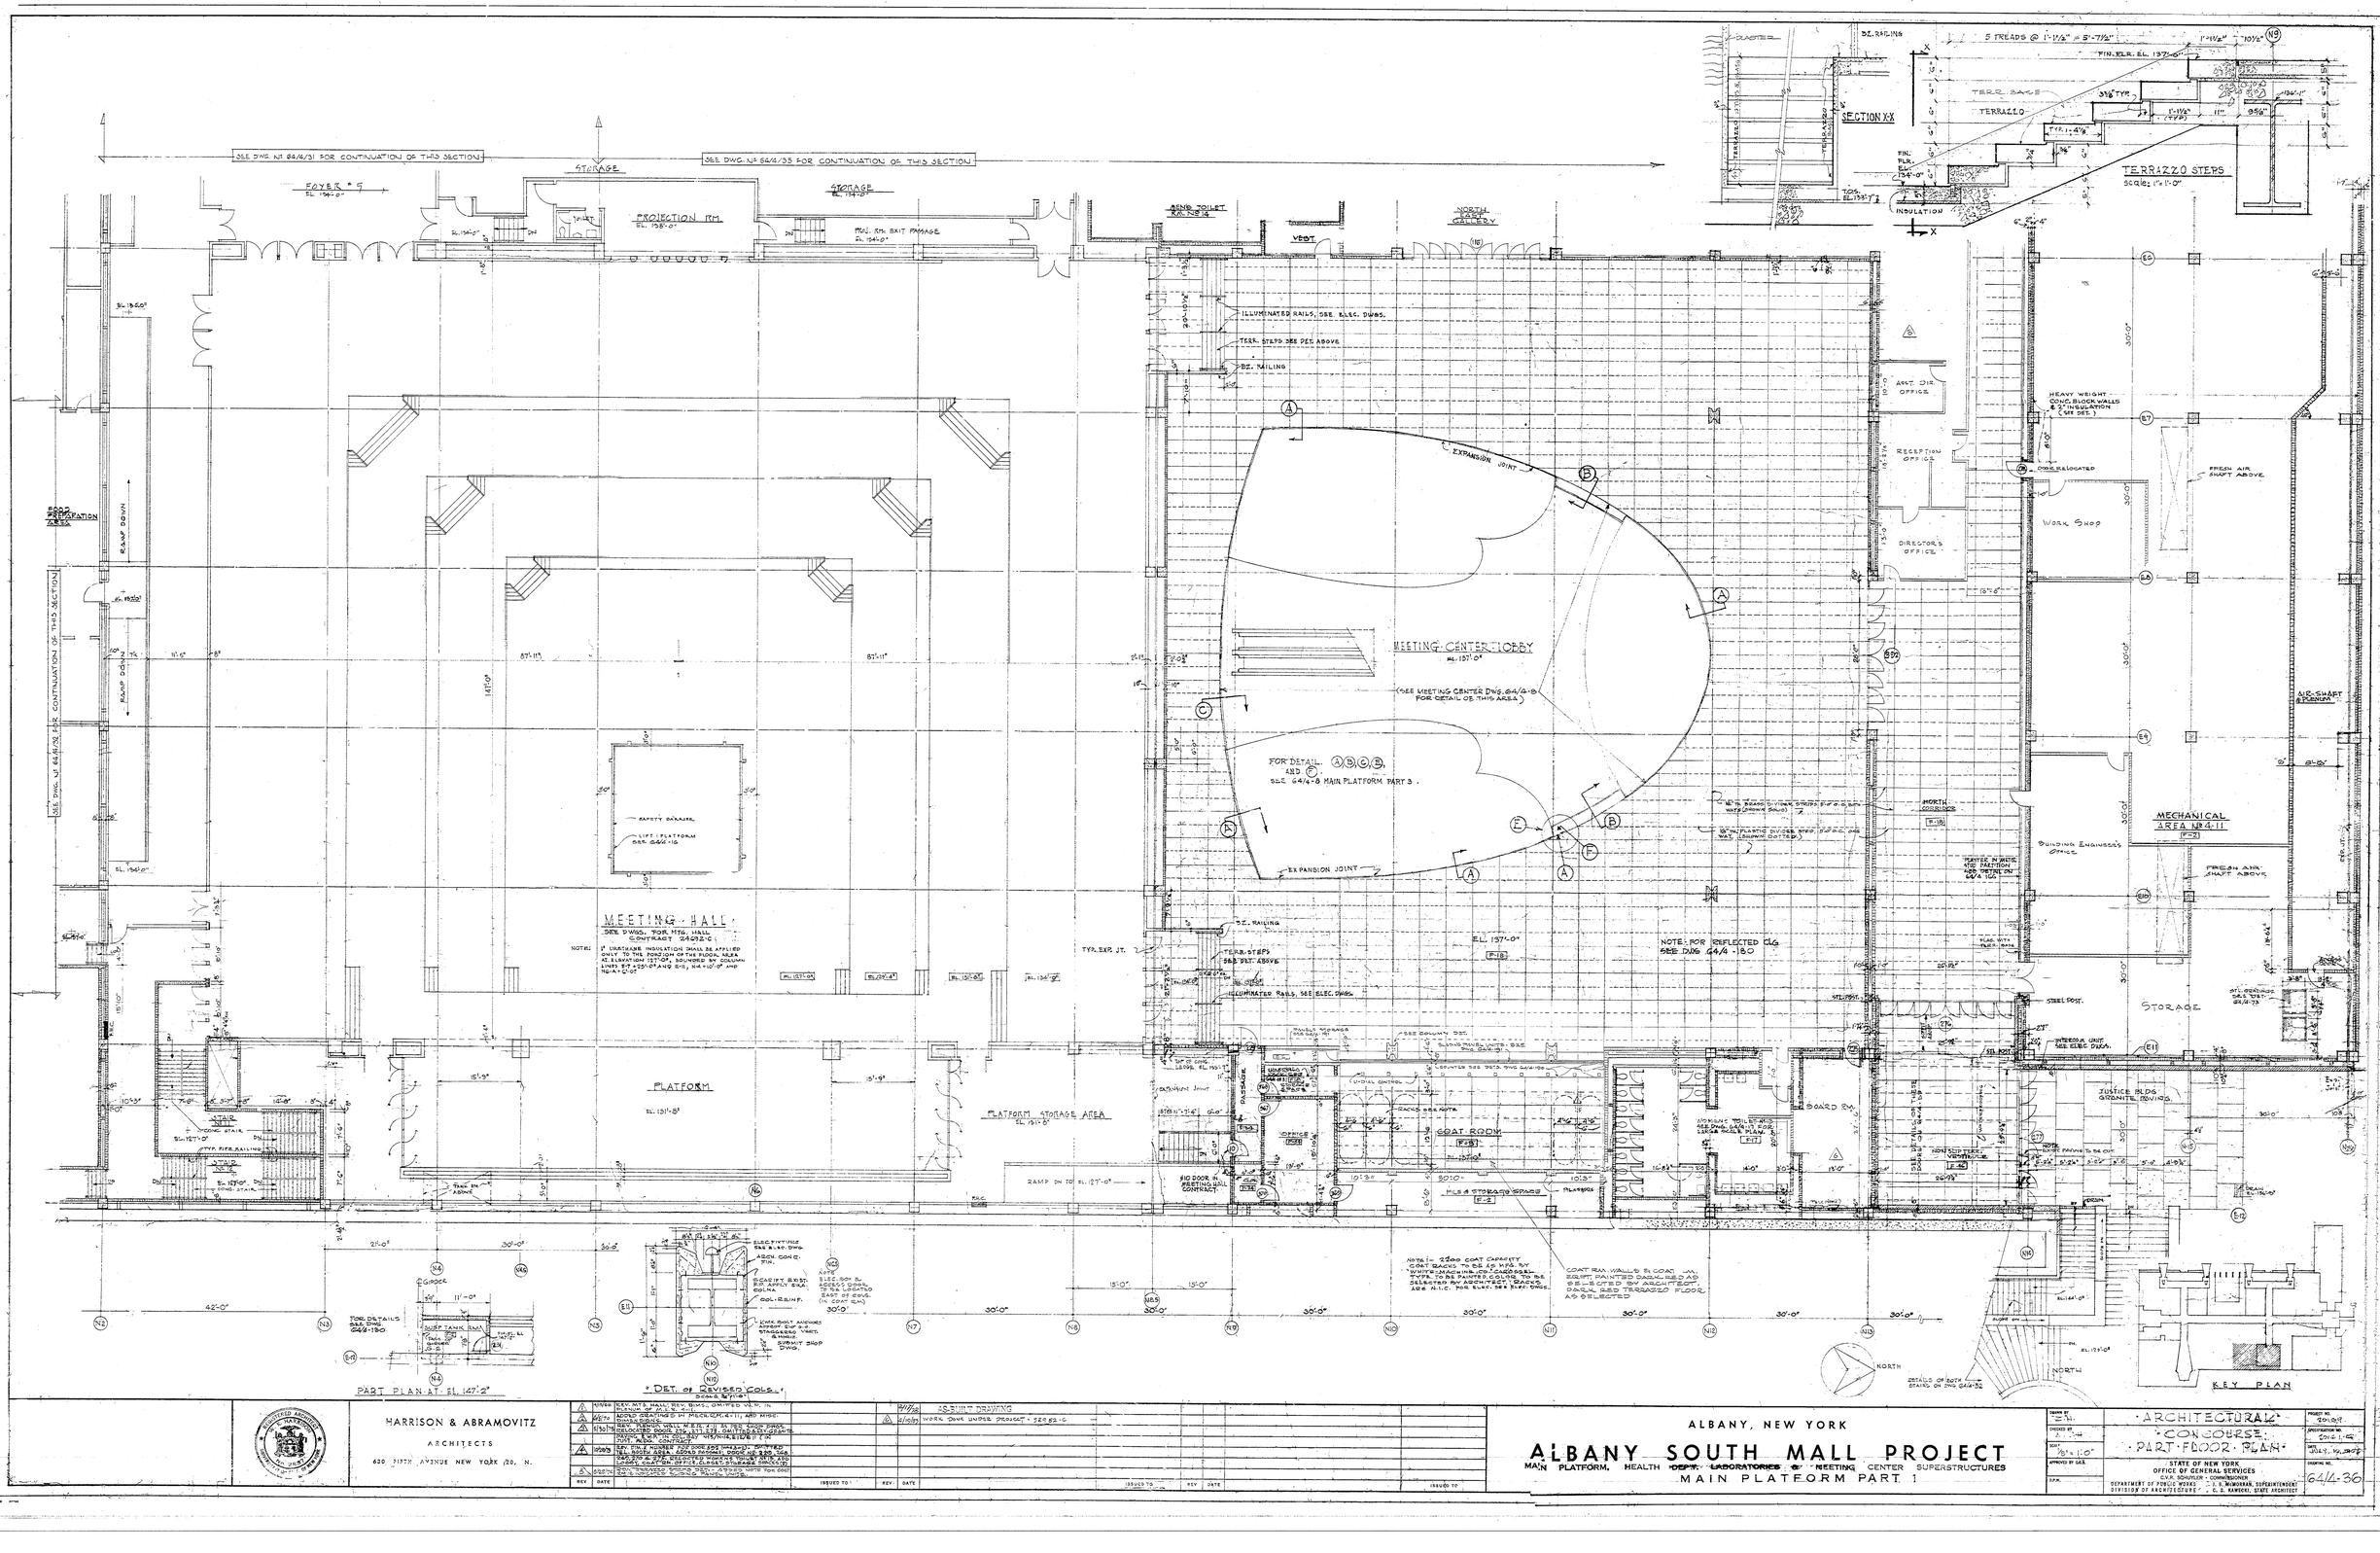




REV.	DATE	ISSUED TO

HARRISON & ABRAMOVITZ
ARCHITECTS
620 FIFTH AVENUE NEW YORK 20, N.Y.

ALBANY, NEW YORK

ALBANY SOUTH MALL PROJECT

MAIN PLATFORM, HEALTH ~~DEPT. LABORATORIES~~ & MEETING CENTER SUPERSTRUCTURES

MAIN PLATFORM PART 1

DRAWN BY: E.S.L.
CHECKED BY: A.J.M.
SCALE: 1/8"=1'-0"
APPROVED BY: G.A.R.
D.P.W.

ARCHITECTURAL
CONCOURSE
PART FLOOR PLAN

PROJECT NO. 20-0-59
SPECIFICATION NO. 20-0-1-62
DATE: JULY 10, 1957
DRAWING NO. 64/4-36

STATE OF NEW YORK
OFFICE OF GENERAL SERVICES
C.V.A. SCHUYLER - COMMISSIONER
DEPARTMENT OF PUBLIC WORKS - J.C.S. McMORRAN, SUPERINTENDENT
DIVISION OF ARCHITECTURE - C.S. RAMSKILL, STATE ARCHITECT

44782 ADDENDUM REFERENCE DRAWING SET 1

FOR REFERENCE ONLY. REFERENCE DRAWINGS MAY NOT REFLECT ACTUAL CONDITIONS.

HARRISON & ABRAMOVITZ
ARCHITECTS
630 FIFTH AVENUE NEW YORK 20, N. Y.

ALBANY, NEW YORK

ALBANY SOUTH MALL PROJECT

MAIN PLATFORM, HEALTH LABORATORIES & MEETING CENTER SUPERSTRUCTURES

MAIN PLATFORM PART

ARCHITECTURAL CONCOURSE & PART FLOOR PLAN

STATE OF NEW YORK
OFFICE OF GENERAL SERVICES
CULLEN, HOWARD, STORRS, McKELL & McKEE, Consulting Engineers
EDWARD DURELL STONE, JR., Associate Architect
WALLACE K. HARRISON, State Architect

44782 ADDENDUM REFERENCE DRAWING SET 1

FOR REFERENCE ONLY. REFERENCE DRAWINGS MAY NOT REFLECT ACTUAL CONDITIONS.

SEE DWG. LS 64/4-37 FOR CONTINUATION OF THIS SECTION

EXECUTIVE PARKING

EXHIBIT AREA F-15

STORAGE F-5

COAT RM. F-15

TOILET RMS. F-13

CHAUFFEUR'S WAITING ROOM F-16

EXECUTIVE PARKING PLATFORM F-20

EXECUTIVE WAITING ROOM F-18

LOUNGE F-19

MEN'S TOILET RM. NO. 7 F-17

WOMEN'S TOILET RM. NO. 7 F-17

POWDER ROOM F-19

STORAGE F-2

CORRIDOR F-2

CORRIDOR TO LEGISLATIVE BLDG.

F-18

EL. 137'-0"

PNEUMATIC OPERATOR SEE DWG. 64/4-100

16'-0" x 16'-0" CONC. SLAB PIERS FILLED SOLID W/CEMENT MORTAR AND ASBESTOS TO SOLID

STORAGE F-2

SUSP. (500 LBS) SCULPTURE (N.I.C.)

NORTH LOBBY

EL. 137'-0"

TUNNEL TO CAPITOL BLDG.

SEE CONTRACT NUMBER

EXISTING CONC. KNOCK-OUT WALL

TOP OF SLAB EL. 134'-6"
SIN. FL. EL. 135'-4"

EXISTING WALLS, FLOORS & CEILING

BLOCK PIER, SEE ABOVE

INFORMATION DESK (N.I.C.) PROVIDE ELECTRIC & TELEPHONE CONDUIT TO FLOOR BOX

NOTE: LT. CEILINGS PARTITION STOPS 4' ABOVE CEILING

NORTH GALLERY F-16

1/16" BRASS DIVIDER STRIPS 5'-0" O.C. BOTH WAYS (SHOWN SOLID)
1/8" PLASTIC DIVIDER STRIPS 5'-0" O.C. ONE WAY (SHOWN DOTTED)

SUPERVISOR F-15

CUSTODIAL F-2

UNIFORM STORAGE F-2

ELECTRICAL RM. NO. 8 F-2

INTERCOM NO. 8 F-2

TELEPHONE NO. 8 F-2

STORAGE F-5

STORAGE F-5

STORAGE F-5

DRY STORAGE F-24

KITCHEN ELEV. NO. 21

SERVING AREA F-22

TRASH F-22

COMPRESSOR RM. F-22

VEG. SERVERS

MEN'S F-23

WOMEN'S F-23

FEMALE F-23

WAIT'S F-23

WAIT'S F-23

WAIT'S F-23







44782 ADDENDUM REFERENCE DRAWING SET 1

FOR REFERENCE ONLY. REFERENCE DRAWINGS MAY NOT REFLECT ACTUAL CONDITIONS.

PART REFLECTED CEILING PLAN OF LOBBY TO CULTURAL CENTER
SCALE: 1/4"=1'-0"

ELEV @ CORRIDOR C/G BREAK
SCALE: 3/4"=1'-0"

SECTION F-39 RECESS @ PLASTER FASCIA
SCALE: FULL SIZE

SECTION H-39 CEILING RECESS @ WINDOW
SCALE: FULL SIZE

SECTION F-39 RETURN AIR @ SASH
SCALE: FULL SIZE

SECTION F-39 CEILING RECESS @ WALL
SCALE: FULL SIZE

SECTION A-39 - TYPICAL AIR & LIGHT SLOT
SCALE: FULL SIZE

SECTION B-39 RETURN AIR @ PLASTER WALL
SCALE: FULL SIZE

SECTION C-39 RETURN AIR @ MARBLE WALL
SCALE: FULL SIZE

SECTION D-39 RETURN AIR @ WINDOW
SCALE: FULL SIZE

HARRISON & ABRAMOVITZ
ARCHITECTS
630 FIFTH AVENUE NEW YORK 20, N. Y.

ALBANY, NEW YORK
ALBANY SOUTH MALL PROJECT
MAIN PLATFORM, HEALTH DEPT. LABORATORIES & MEETING CENTER SUPERSTRUCTURES
MAIN PLATFORM PART 1

ARCHITECTURAL
CONCOURSE
PART REFLECTED CEILING PLAN
SECTIONS

STATE OF NEW YORK
OFFICE OF GENERAL SERVICES
HARRISON, ABRAMOVITZ & HARRIS
ARCHITECTS - ENGINEERS - CONSULTANTS

DRAWING NO. C-44-39

44782 ADDENDUM REFERENCE DRAWING SET 1

FOR REFERENCE ONLY. REFERENCE DRAWINGS MAY NOT REFLECT ACTUAL CONDITIONS.

DETAIL F-40
FULL SCALE
(EXPANSION JT. @ AGENCY BLDG.)

DETAIL G-40 – TYPICAL CONTROL JT.
FULL SCALE
NOTE - CONTROL JOINT ANGYS. STOPS AT AND ADJOIN ALL SLOTS.

REFLECTED C.L.G. PLAN OF NEWS STAND N°2

NEWS STAND N°2
NEWS STANDS
N° 2,465 SIMILAR

STONE ARCHES

EXPANSION JOINT

INSIDE FACE OF STONE ARCHES

AGENCY BLDG. N°2

DISPLAY CASES 10'-0" HUNG CLG.

4 LIGHTS & SPRINKLER HEADS IN THIS AREA, N.I.C.

NOTE: LOCATION OF EXPANSION JOINT AT AGENCY BLDG. NO. 1 & 2 MAKES EXPANSION JOINT AT STORE CONTINUE TO CEILING RECESS TO WALL.

CEMENT PLANTER RAISE BEAM COVERING PLUMBING

CONTINUOUS FLUOR. STRIP LIGHTING HUNG AT UNDERSIDE OF BEAMS. SEE ELEC. DWGS.

SOUTH WEST CORNER
NORTH WEST CORNER IDENTICAL

NOTE
FOR DUCTS, PLUMBING & SPRINKLER SEE MECHANICAL DWGS.

CONCRETE BEAMS BOT. OF BM. EL. 149'-6"

BUS TERMINAL

CONTINUOUS CONTROL JOINT (TYPICAL)

EXPANSION JOINT

FACE OF HUNG CLG.

NOTE: NORTH HALF OF REFLECTED CEILING OPPOSITE HAND.

DETAILS "EXTRUDED ALUMINUM SHAPES"
SCALE FULL SIZE
NOTE: ALL ALUMINUM SHALL BE SHOP PAINTED

DETAIL E-40
SCALE FULL SIZE
(INTERSECTION OF TYPICAL ACTIVE SLOT & EXPANSION JT.)

DETAIL D-40
SCALE FULL SIZE
(INTERSECTION OF ACTIVE SLOT & WALL & EXPANSION JT.)

SECTION-DD
SCALE FULL SIZE

SECTION 4-4
1/2" SCALE

SECTION-CC
SCALE FULL SIZE

SECTION 1-1
SCALE

SECTION 2-2
SCALE

SECTION 3-3
SCALE

DETAIL A-40
SCALE FULL SIZE
(INTERSECTION OF TYPICAL AIR & LIGHT SLOT & CEILING RECESS @ WALL)

DETAIL B-40
SCALE FULL SIZE
(INTERSECTION OF TYPICAL AIR & LIGHT SLOT & AIR SLOT @ WALL)

DETAIL C-40
SCALE FULL SIZE
(INTERSECTION OF SEALTIGHT @ WALL AND EXPANSION JOINT)

LEGEND:
- PLASTER CONTROL JOINT
- R- RETURN AIR SLOT
- S- SUPPLY AIR SLOT
- L- LIGHTING SLOT @ RECESS 2'-6" O.C.
- S/L- SUPPLY AIR SLOT, RECESS 5'-0" O.C.

NOTES: 1) ALL SLOTS WITH RECESS TO HAVE AN ADDITIONAL RECEPTACLE 8'-0" FROM EACH END WALL.
2) ALL SLOTS SHALL BE ABLE TO SUPPORT BRACING OF MOVABLE DISPLAY PARTITIONS.
3) ALL SPRINKLERS ARE FULLY RECESSED.
4) ALL SLOTS TO BE IDENTICAL IN APPEARANCE
5) RECEPTACLES SHALL BE RECESSED OUT OF SIGHT INTO STRIPS.
6) ALL DOWLIGHTS TO BE RECESSED LOW BRIGHTNESS DOWNLIGHTS.
7) ALL INACTIVE SLOTS TO BE FLUSH TO WALLS SHALL HAVE SAME WIDTH OPENINGS AS ADJOINING SLOTS UNLESS OTHERWISE NOTED.
8) DISTANCES BETWEEN SLOTS DIMENSIONED FROM ℄ TO ℄ OF SLOTS.

AREA COVERED BY THIS DWG.
AREAS WITH SIMILAR REFLECTED CEILING PLAN

KEY PLAN

HARRISON & ABRAMOVITZ
ARCHITECTS
630 FIFTH AVENUE NEW YORK 20, N.Y.

ALBANY, NEW YORK
ALBANY SOUTH MALL PROJECT
MAIN PLATFORM, HEALTH DEPARTMENT, CONCOURSE, CENTER, SUPERSTRUCTURES
MAIN PLATFORM PART I

STATE OF NEW YORK
OFFICE OF GENERAL SERVICES
CLAY-SNYDER-CONSULTANTS
DEPARTMENT OF PUBLIC WORKS
DIVISION OF ARCHITECTURE

ARCHITECTURAL
CONCOURSE
PLAN

40

44782 ADDENDUM REFERENCE DRAWING SET 1

FOR REFERENCE ONLY. REFERENCE DRAWINGS MAY NOT REFLECT ACTUAL CONDITIONS.

EXECUTIVE PARKING

CEMENT PLASTER HUNG CLG.

EL. 126'-0"

EXEC. PARK. PLATFORM

9'-0" CEM. PLASTER H.C.

CHAUFFEURS WAITING ROOM

EXECUTIVE WAITING ROOM

EXHIBITS

NORTH GALLERY

CORRIDOR TO LEGISLATIVE BLDG.

10'-10" H.C.

CORRIDOR TO JUSTICE BLDG. SIMILAR TO CORRIDOR TO LEGISLATIVE BLDG.

NORTH LOBBY

PART ELEVATION OF CORRIDOR TO PLAZA RESTAURANT

SCALE: 1/4"=1'-0"

SECTION A

SECTION B

D-41 SECTION THRU HEAD WITH FASCIA ADDED

E-41 ELEVATION OF FASCIA FROM AT HEAD

DETAIL 2

SECTION A-A

SCALE: 1/4" = 1'-0"

DETAIL A

SCALE: HALF SIZE

11-0" THICK CONCRETE RAMP

1'-8" THICK CONCRETE SLAB.

1" x 3/16" BAR.

1½" RUNNER @ 1.05 # @ 9'-0" O.C.

1" RUNNER, 12" O.C.

¾" CEMENT PLASTER ON STEEL LATH

PLASTER STOP

⅞" x ⅞" RECESS

1⅛" x 1⅛" ∠

LEGEND:

——— PLASTER CONTROL JOINT

R- RETURN AIR SLOT

S- SUPPLY AIR SLOT

L- LIGHTING SLOT 1'-0" RECESS, 2'-6" O.C.

R&L- RETURN AIR & LIGHTING SLOT

S&L- SUPPLY AIR & LIGHTING SLOT. RECESS 2'-6" O.C.

NOTES: 1) ALL SLOTS WITH RECESS, TO HAVE 4'-0" ADDITIONAL RECEPTACLE 5'-0" FROM EACH END WALL.
2) ALL SLOTS SHALL BE ABLE TO SUPPORT BRACING OF MOVABLE DISPLAY PARTITIONS.
3) ALL SPRINKLERS ARE FULLY RECESSED
4) ALL SLOTS TO BE IDENTICAL IN APPEARANCE.
5) RECEPTACLES SHALL BE RECESSED OUT OF SIGHT INTO STRIPS.
6) ALL DOWNLIGHTS TO BE RECESSED LOW BRIGHTNESS DOWNLIGHTERS.
7) ALL INACTIVE CEILING SLOTS ADJACENT TO WALLS SHALL HAVE BAMS WIDTH OPENING AT ADJOINING SLOTS UNLESS OTHERWISE NOTED.
8) DISTANCES BETWEEN SLOTS DIMENSIONED FROM ℄ TO ℄ OF SLOTS.

NOTE: FOR DOWNS PLUMBING & SPRINKLER SEE MECHANICAL DWGS.

NOTE: PROVIDE DURANODIC FINISH ALUM. FASCIA. FASCIA TO EXTEND FOR FULL DISTANCE OF EXPOSED CLG. AREA (USE GAGE 22, 21 & 20). CUT OFF AT TOP OF DOOR JAMBS WITHIN EXPOSED CLG. AREA. PROVIDE PAINTED CLOSURE PLATE AT CHL. SHAPED CLG. RECESS ADJACENT TO PLAS. FASCIA.

NOTE A: PROVIDE STIFFENERS AT 24" O.C. MAX. AS REQUIRED TO PREVENT DEFLECTION OF FASCIA. STIFFENERS TO BE ATTACHED TO FASCIA AND TO FURR & LATH CONSTRUCTION BEHIND FASCIA.

CORRIDOR TO PLAZA RESTAURANT

KEY PLAN

NORTH

AREA COVERED BY THIS DWG.

AREA WITH SIMILAR, REFL. CLG.

HARRISON & ABRAMOVITZ
ARCHITECTS
630 FIFTH AVENUE NEW YORK 20, N.Y.

ALBANY, NEW YORK

ALBANY SOUTH MALL PROJECT

MAIN PLATFORM, HEALTH DEPT. LABORATORIES & TESTING CENTER SUPERSTRUCTURES

MAIN PLATFORM PART 1

ARCHITECTURAL CONCOURS

STATE OF NEW YORK
OFFICE OF GENERAL SERVICES
CLAUDE SHAUGER, COMMISSIONER
DEPARTMENT OF PUBLIC WORKS — J. D. MCKEEVER, DEPUTY COMMISSIONER
DIVISION OF ARCHITECTURE — CLAUDE SHAUGER, DIVISION ARCHITECT

DRAWN BY M.M.S.
CHECKED BY H.S.
APPROVED BY H.S.

PROJECT NO. 6014-A
SHEET NO. A-41

44782 ADDENDUM
REFERENCE
DRAWING SET 1

FOR REFERENCE ONLY.
REFERENCE DRAWINGS
MAY NOT REFLECT
ACTUAL CONDITIONS.

A-42 SECTION @ SUSP. PLASTER CLG.
SCALE: FULL SIZE

B-42 ELEVATION OF FASCIA-½ EXP. JT.
SCALE: FULL SIZE

C-42 EXPANSION JOINT DETAIL
SCALE: FULL SIZE

REFLECTED CLG. PLAN OF EXP. JT.
SCALE: FULL SIZE

EMPLOYEES HEALTH UNIT
REFLECTED CEILING PLAN
FLOOR PLAN SEE DWG. G-4-93 3/4"=1'-0"

NORTH-WEST GALLERY
(SOUTH-WEST AND NORTH-EAST GALLERIES SIMILAR)
12'-0" HUNG CEILING

PART ELEV. OF CORRIDOR TO MEETING HALL
SCALE: 3/4"=1'-0"

BUS TERMINAL

CENTRAL CORRIDOR

TOURS AND EXHIBITS
12'-0" HUNG CEILING

EXHIBITS
12'-0" HUNG CEILING

SYMMETRICAL ABOUT C OF BUILDING

EXPANSION JOINT

CORRIDOR TO MEETING HALL


KEY PLAN

HARRISON & ABRAMOVITZ
ARCHITECTS
220 FIFTH AVENUE NEW YORK 20, N.Y.


ALBANY, NEW YORK
ALBANY SOUTH MALL PROJECT
MAIN PLATFORM, HEALTH UNIT, LABORATORIES & MEETING CENTER SUPERSTRUCTURES
MAIN PLATFORM PART I

STATE OF NEW YORK
OFFICE OF GENERAL SERVICES


A-42

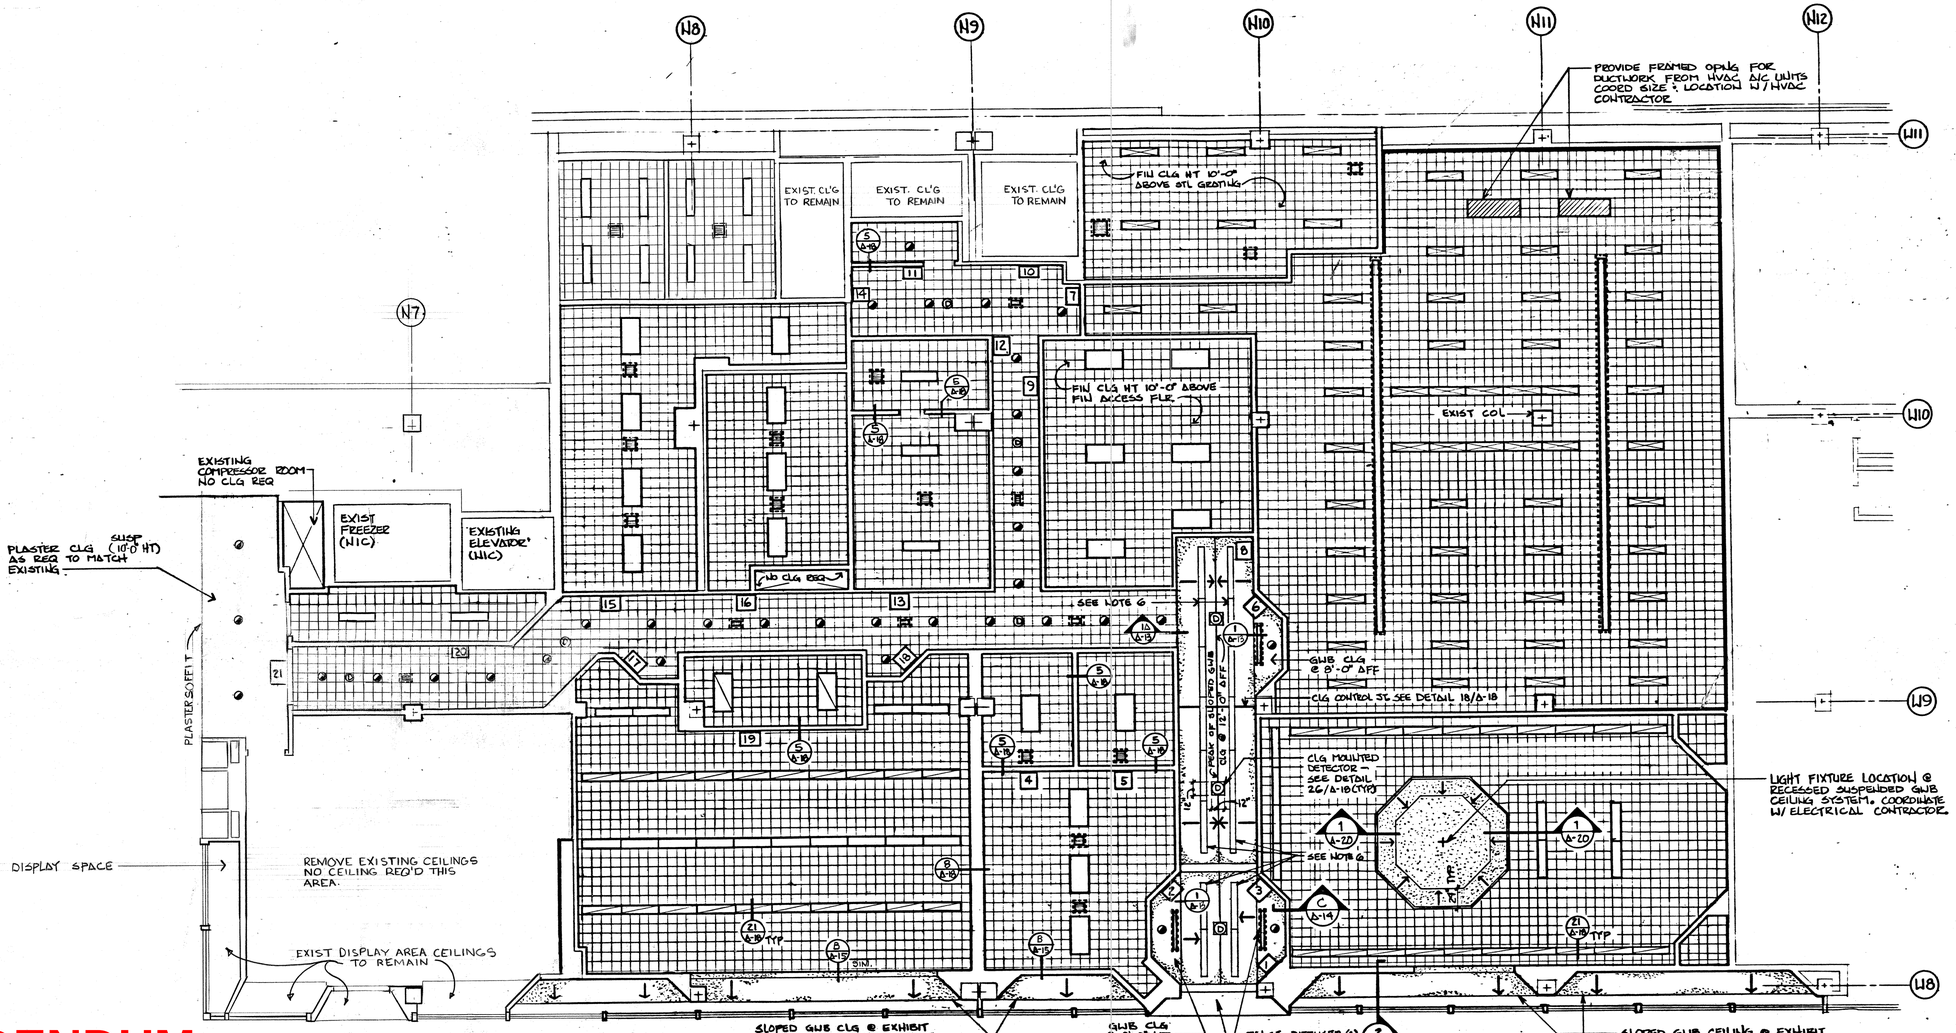

N PARTIAL REFLECTED CEILING PLAN
SCALE: 1/8" = 1'-0"

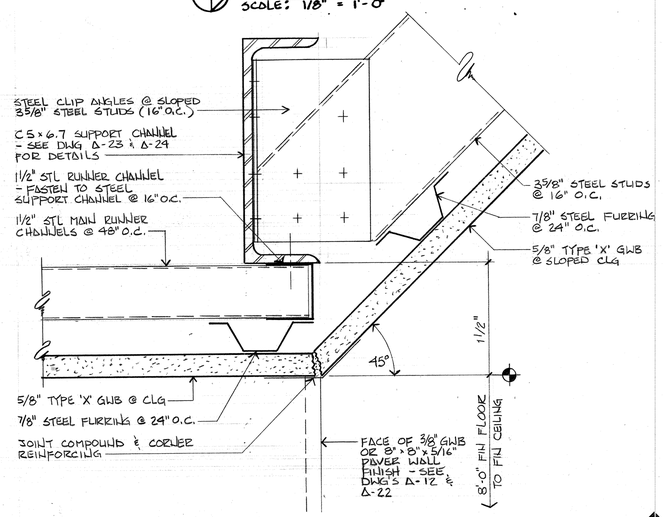

GWB/SLOPED GWB CEILING DETAIL
SCALE: 6" = 1'-0"

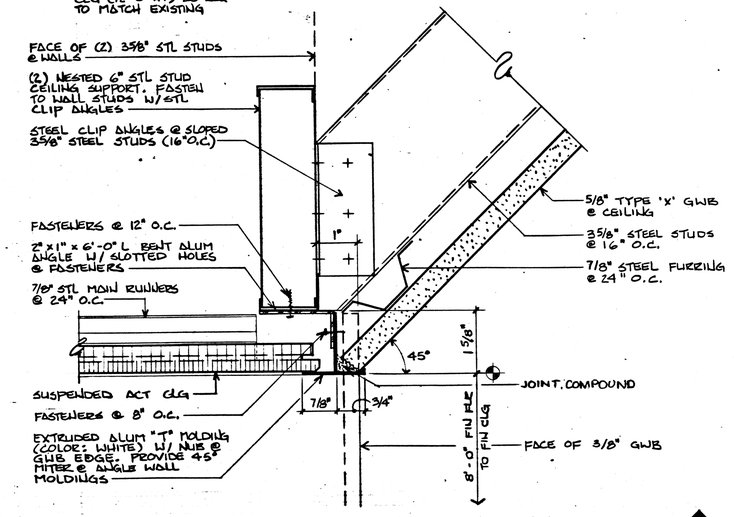

ACT/SLOPED GWB CEILING DETAIL
SCALE: 6" = 1'-0"

44782 ADDENDUM REFERENCE DRAWING SET 1

FOR REFERENCE ONLY. REFERENCE DRAWINGS MAY NOT REFLECT ACTUAL CONDITIONS.

NOTES

1) CONTRACTOR TO FIELD VERIFY DIMENSIONS & CONDITIONS IN FIELD.
2) GRID SHOWN FOR SUSPENDED ACT CEILING IS FOR REFERENCE ONLY.
3) SEE DWG A-17 FOR FINISH SCHEDULE & COLOR LIST.
4) SEE DWG A-18 FOR PARTITION, WALL, FLOOR & CEILING DETAILS.
5) SEE DWG A-22 FOR FLOOR FINISH PLAN.
6) PENDANT CABLE MOUNTED CYLINDER LITE TUBES SUSPENDED FROM SLOPED GWB CEILING @ 9'-0" ABOVE FINISHED FLR. COORDINATE W/ ELECTRICAL CONTRACTOR.

SYMBOL KEY

- SUSPENDED ACT CEILING
- SUSPENDED GWB CEILING
- RECESSED LIGHT FIXTURE
- RECESSED LIGHT FIXTURE W/ HVAC DIFFUSER
- SURFACE MOUNT LIGHT FIXTURE
- RECESSED DOWNLIGHT
- HVAC DIFFUSER/ REGISTER
- ROOM SIGN REFERENCE NUMBER
- ROOM SIGNAGE LOCATION
- WALL MOUNTING SURFACE
- CEILING SLOPE INDICATOR
- CEILING MOUNTED SMOKE DETECTOR - SEE DETAIL DWG A-18 FOR SLOPED GWB CEILING

REGISTERED ARCHITECT RAYMOND ERNEST WEBSTER ARC 012101 LICENSED BY THE STATE OF NEW YORK

CONSTRUCTION

PROVIDE TELECOMMUNICATIONS EQUIPMENT ROOMS AND APPURTENANT WORK

VARIOUS BUILDINGS, GNARESP & ENVIRONS
ALBANY, NEW YORK

CONCOURSE TELECOMMUNICATIONS CENTER

REFLECTED CEILING PLAN

STATE OF NEW YORK EXECUTIVE DEPARTMENT
OFFICE OF GENERAL SERVICES

COMMISSIONER JOHN C. EGAN	DESIGN AND CONSTRUCTION DIRECTOR HARRY STEVENS, JR., P. E.
	DIVISION OF DESIGN DIRECTOR WILLIAM F. O'CONNOR, R.A.
ARCHITECTURAL BUREAU CHIEF RICHARD E. THOMAS, R. A.	ENGINEERING BUREAU CHIEF VINCENT P. POLETO, P.E.

DRAWN BY	DATE	SCALE	APPROVED
D. SCOTT	1/7/87	AS NOTED	
TRACED BY	CHECKED BY	STRUCTURAL CHECK	FIELD CHECK
A. GREGORY			

APPROVED BY OFFICE OF GENERAL SERVICES
DATED SEPTEMBER 10, 1986 LETTER NO 006883

PROJECT NO.	DRAWING NO.
35583-C	A13
	(PLAN FILE NO: 86/12-240)

ROOM FINISH SCHEDULE

REVISION DESCRIPTION LIST

- ADDITIONAL ROOMS — 109A, 119, 120
- ROOM NAME REVISIONS — ROOMS 107, 108, 109, 118
- FLOORING REVISIONS — ROOMS 106, 108, 109, 118
- BASE REVISIONS — ROOMS 108, 109 118
- NORTH WALL REVISIONS — ROOM 108, 103
- SOUTH WALL REVISIONS — ROOM 103
- EAST WALL REVISIONS — ROOM 108, 103
- WEST WALL REVISIONS — ROOM 103
- CEILING REVISIONS — ROOMS 101, 102, 102A, 102B, 105, 105A, 106, 106A, 107, 108
- DELETIONS FROM REMARKS — ROOMS 102A, 109, 103
- REVISIONS TO REMARKS — ROOMS 102A, 103, 104, 108
- SIGN MARKER REVISIONS — ROOMS 109, 118

ROOM NO.	ROOM NAME	FLOOR MATERIAL	FLOOR FINISH	FLOOR COLOR	BASE MATERIAL	BASE FINISH	BASE COLOR	NORTH WALL MATERIAL	NORTH WALL FINISH	NORTH WALL COLOR	SOUTH WALL MATERIAL	SOUTH WALL FINISH	SOUTH WALL COLOR	EAST WALL MATERIAL	EAST WALL FINISH	EAST WALL COLOR	WEST WALL MATERIAL	WEST WALL FINISH	WEST WALL COLOR	CEILING MATERIAL	CEILING FINISH	CEILING COLOR	CEILING HEIGHT	REMARKS	SIGN MARKERS
101	CONTROL ROOM	P.P./CPT	–	1A, 1B 2A, 2B	WOOD	I-2	6A	G.W.B.	W.C./I-2	6B/6D	G.W.B.	W.C.	4A	G.W.B.	W.C./P.P.	4A/1B	G.W.B.	W.C./P.P.	4B/1B	SUSP.	ACOUST.	7A	9'-0"	SEE FLOOR FINISH PLAN, DWG A-13; SEE SECTION B/A-14	3
102	TELECOMMUNICATIONS OFFICE SUITE	CARPET	–	2A, 2B	WOOD	I-2	6A	G.W.B.	W.C.	3A	G.W.B.	W.C.	3A	G.W.B.	W.C.	3A	G.W.B.	W.C.	4B	SUSP.	ACOUST.	7A	9'-0"	SEE FLOOR FINISH PLAN, DWG A-13	2
102A	MANAGER	CARPET	–	2B	WOOD	I-2	6A	G.W.B.	W.C.	3A	G.W.B.	W.C.	3A	G.W.B.	W.C.	3A	G.W.B.	W.C.	3A	SUSP.	ACOUST.	7A	9'-0"	PAINT EXPOSED COLUMN WITH I-2, COLOR NO. 6A & PROVIDE WOOD BASE, COLOR NO. 8	4
102B	ASSISTANT MANAGER	CARPET	–	2B	WOOD	I-2	6A	G.W.B.	W.C.	3A	G.W.B.	W.C.	3A	G.W.B.	W.C.	3A	G.W.B.	W.C.	3A	SUSP.	ACOUST.	7A	9'-0"		5
103	EQUIPMENT ROOM	V.C.T.	–	5A	VINYL	–	5B	G.W.B.	I-2	6B	G.W.B.	I-2	6B	GWB	I-2	6B	G.W.B.	I-2	6B	SUSP.	ACOUST.	7A	10'-0"	SEE DRAWINGS A-12 & A-13 & A-22	6 7
103A	BATTERY ROOM	STL FLR GRATE	–	–	VINYL	–	5B	G.W.B.	I-2	6B	G.W.B.	I-2	6B	G.W.B.	I-2	6B	G.W.B.	I-2	6B	SUSP.	ACOUST.	7A	10'-0"	FINISHED CEILING HEIGHT TO BE FROM TOP OF STEEL FLOOR GRATING; PAINT FLOOR & WALL SURFACES BELOW FLOOR GRATING COLOR: 6A	–
104	COMPUTER ROOM	AC. FL.	–	–	VINYL	–	BLACK	G.W.B.	I-2	6B	G.W.B.	I-2	6B	G.W.B.	I-2	6B	G.W.B.	I-2	6B	SUSP.	ACOUST.	7A	10'-0"	FINISHED CEILING HEIGHT TO BE FROM TOP OF ACCESS FLOOR SYSTEM; PROVIDE VCT FINISH FLOOR (COLOR: 5A) @ LOWER PART OF RAMP – SEE DWG A-22	8 9
105	OPERATORS	CARPET	–	2A, 2B	WOOD	I-2	6A	G.W.B.	W.C.	4A	G.W.B.	W.C.	4A	G.W.B.	W.C./P.P.	4A/1B	G.W.B.	W.C.	4B	SUSP.	ACOUST.	7A	9'-0"	PAINT EXPOSED COLUMNS & WALLS OF ROOM 105A WITH TYPE I-2, COLOR: 6D; SEE SECTION C/A-14	17 18
105A	SUPERVISING ATTENDANT	CARPET	–	2B	WOOD	I-2	6A	G.W.B.	W.C.	4A	G.W.B.	W.C.	4A	G.W.B.	W.C.	4A	G.W.B.	W.C.	4B	SUSP.	ACOUST.	7A	9'-0"		19
106	LOUNGE	EXIST. TERRAZZO	–	–	WOOD	I-2	6A	G.W.B.	W.C.	4A/3A	G.W.B.	W.C.	4A/3A	G.W.B.	W.C.	4A/3A	G.W.B.	W.C.	4A/3A	SUSP.	ACOUST.	7A	9'-0"	CHAIR RAIL @ 3'-0" A.F.F. - NORTH, SOUTH & EAST WALLS. PAINT WITH TYPE I-2, COLOR: 6A; WALLCOVERING (COLOR: 9A) ABOVE RAIL, WALLCOVERING (COLOR: 8A) BELOW RAIL; SEE SECTION A/A-14	13
106A	LOCKER ROOM	V.C.T.	–	5A	WOOD	I-2	6A	G.W.B.	I-2	6B	G.W.B.	I-2	6B	G.W.B.	I-2	6B	G.W.B.	I-2	6B	SUSP.	ACOUST.	7A	9'-0"	DO NOT INSTALL BASE BEHIND LOCKERS	12
107	OFFICE	CARPET	–	2B	WOOD	I-2	6A	G.W.B.	I-2	6B	G.W.B.	I-2	6B	G.W.B.	I-2	6B	G.W.B.	I-2	6B	SUSP.	ACOUST.	7A	9'-0"		16
108	LINCS OFFICE	CARPET	–	2B	WOOD	I-2	6A	G.W.B.	I-2	6B	–	–	–	GWB	I-2	6B	G.W.B	I-2	6B	SUSP.	ACOUST.	7A	9'-0"	BASE REQUIRED @ NEW WALLS	14 15
109	UNASSIGNED	–	–	–	–	–	–	G.W.B.	I-2	6B	–	–	–	–	–	–	G.W.B.	I-2	6B	—	—	—	—		–
110	ENTRY	P.P.	–	1A, 1B	P.P.	GLAZED	1B	G.W.B.	P.P.	1B	G.W.B.	P.P.	1B	G.W.B.	P.P.	1B	G.W.B.	P.P.	1B	G.W.B.	I-2	6C	8'-0"- 12'-0"	SEE FLOOR FINISH PLAN, DRAWING A-13; SEE SECTIONS 'B' & 'D', DRAWING A-14; PATCH AND FINISH EXISTING PLASTER CEILING @ CONCOURSE AS REQUIRED TO MATCH EXISTING	SEE ELEVATION 1 THIS DWG
110A	CORRIDOR 'A'	P.P.	–	1A, 1B	P.P.	GLAZED	1B	G.W.B.	W.C.	3A	G.W.B.	W.C.	3A	G.W.B.	–	–	G.W.B.	I-2	6C	G.W.B.	I-2	6C	8'-0"- 12'-0"	SEE FLOOR FINISH PLAN; 3/8" G.W.B. TOP OF BASE TO THE START OF SLOPED CEILING	–
111	CORRIDOR 'B'	P.P.	–	1A, 1B	P.P.	GLAZED	1B	—	–	–	G.W.B.	W.C.	3A	G.W.B.	W.C.	3A	G.W.B.	W.C.	3A	SUSP.	ACOUST.	7A	8'-0"	SEE FLOOR FINISH PLAN; 3/8" G.W.B. TOP OF BASE TO 1'-0" ABOVE FINISHED CEILING	–
112	CORRIDOR 'C'	P.P.	–	1A, 1B	P.P.	GLAZED	1B	G.W.B.	W.C.	3A	G.W.B.	W.C.	3A	—	–	–	—	–	–	SUSP.	ACOUST.	7A	8'-0"	SEE FLOOR FINISH PLAN; 3/8" G.W.B. TOP OF BASE TO 1'-0" ABOVE FINISHED CEILING	–
113	CORRIDOR 'D'	P.P.	–	1A, 1B	P.P.	GLAZED	1B	G.W.B.	W.C.	3A	G.W.B.	W.C.	3A	G.W.B.	W.C.	3A	G.W.B.	W.C.	3A	SUSP.	ACOUST.	7A	8'-0"	SEE FLOOR FINISH PLAN; 3/8" G.W.B. TOP OF BASE TO 1'-0" ABOVE FINISHED CEILING	–
114	CORRIDOR 'E'	P.P.	–	1A, 1B	P.P.	GLAZED	1B	G.W.B.	W.C.	3A	G.W.B.	W.C.	3A	G.W.B.	W.C.	3A	G.W.B.	W.C.	3A	SUSP.	ACOUST.	7A	8'-0"	SEE FLOOR FINISH PLAN; 3/8" G.W.B. TOP OF BASE TO 1'-0" ABOVE FINISHED CEILING	–
115	VESTIBULE	P.P.	–	1A	P.P.	GLAZED	1B	G.W.B.	W.C.	3A	G.W.B.	W.C.	3A	G.W.B.	W.C.	3A	G.W.B.	W.C.	3A	SUSP.	ACOUST.	7A	8'-0"	SEE FLOOR FINISH PLAN; 3/8" G.W.B. TOP OF BASE TO 1'-0" ABOVE FINISHED CEILING	–
116	MEN'S ROOM	P.P.	–	1A	P.P.	GLAZED	1B																	* PROVIDE HANDICAP SYMBOL ON NEW SIGN; SEE DWG A-20	11
117	WOMEN'S ROOM	P.P.	–	1A	P.P.	GLAZED	1B																	* PROVIDE HANDICAP SYMBOL ON NEW SIGN; SEE DWG A-20	10
119	SERVICE CORRIDOR 'F'	VCT	–	5A	VINYL	–	BLACK	GWB	I-2	6B	GWB	I-2	6B	GWB	I-2	6B	GWB	I-2	6B	SUSP	ACOUST.	7A	8'-0"	EXISTING ELEVATOR WALL & FREEZER WALL TO REMAIN – PAINT EXISTING SURFACES AS REQUIRED TO MATCH NEW	20
120	REAR ENTRY	TERRAZZO	–	MATCH EXIST.	VINYL	–	BLACK	GWB	I-2	6B	—	—	—	G.W.B.	I-2	6B	GWB	I-2	6B	SUSP	PLASTER	MATCH EXIST	10'-0"		21

REMARKS

REVISION DESCRIPTION LIST

- FLOORING REVISIONS — ROOMS 103A, 109
- BASE REVISIONS — ROOM 104, 109
- NORTH WALL REVISIONS — ROOMS 109, 111
- SOUTH WALL REVISIONS — ROOM 103
- EAST WALL REVISIONS — ROOM 112
- WEST WALL REVISIONS — ROOMS 103, 109, 112
- CEILING REVISIONS — ROOMS 101, 111 THRU 115 INCLUSIVE
- ADDITIONS TO REMARKS — ROOMS 102A, 103, 103A, 104, 105, 105A, 106, 109, 110, 110A, 111, 112, 113, 114, 115, 116, 117, 118

SIGN MARKERS – SEE ROOM NAME COLUMN FOR SIGN TYPE – SEE REFLECTED CEILING PLAN FOR LOCATION

COLOR LIST


1. * AMERICAN OLEAN "TERRA PAVERS"
   A. NO. W73 PEPPER GRANITE-MATTE FINISH, 8"X8"
   B. NO. W75 LAVA GRAY GLAZED FINISH, 8"X8"
2. COMMERCIALON BY J&J INDUSTRIES, INC. "3500CG", DENSE CUT PILE
   A. NO. 559 WOOD VIOLET
   B. NO. 547 GRAPHITE
3. GENON VINYL WALLCOVERINGS "ARTISTRY"
   A. NO. FN-6119 WINSTON STRIPE
4. GENON VINYL WALLCOVERINGS "METRICS"
   A. NO. FA-5178 DOMINO
   B. NO. FA-5173 WAFFLE
5. TARKETT VINYL COMPOSITION TILE "EXPRESSIONS COLLECTION"
   A. NO. 4514 (FLOOR TILE)
   B. NO. F-11 (BASE)
6. BENJAMIN MOORE "MOOR-O-MATIC" PAINT
   A. NO. GN-1 (GRAPHITE)
   B. NO. OW-4 (OFF WHITE)
   C. NO. OW-36 (CEILING WHITE)
   D. NO. GN-10 (GRAY)
7. ARMSTRONG ACCESSIBLE TILE SYSTEM NO. 550, 3/4"X12"X12", SQUARE EDGE, K4C4, NATURAL FISSURED, WHITE
8. ALL STEEL FRAMES AND DOORS TO BE TYPE I-4 SYSTEM, COLOR 6A. ALL WOOD BASE TO BE TYPE I-3 SYSTEM, COLOR 6A.
9. ALL WOOD DOORS TO BE STAINED WITH A "WINDSOR MAHOGONY" COLOR, AND FINISHED WITH TYPE T-3 SYSTEM.

* USE AMERICAN OLEAN SANDED GROUT 'MUSHROOM' W/'PEPPER GRANITE', & 'RAVEN' W/'LAVA GRAY' PAVERS.

REVISION NUMBER	DATE	DESCRIPTION
4	1/2/87	MISCELLANEOUS REVISIONS
3	12/9/86	MISCELLANEOUS ROOM FINISH SCHEDULE REVISIONS
2	11/14/86	CEILING FINISH REVISED @ ROOMS 111 THRU 115; MISCELLANEOUS ROOM FINISH SCHEDULE REVISIONS
1	9/17/86	CEILING HEIGHT CHANGE @ DAKA ROOM 109 TO 9'-0"


REGISTERED ARCHITECT RAYMOND SAMUEL WEBSTER ARC 012101 THE UNIVERSITY OF THE STATE OF NEW YORK

44782 ADDENDUM REFERENCE DRAWING SET 1

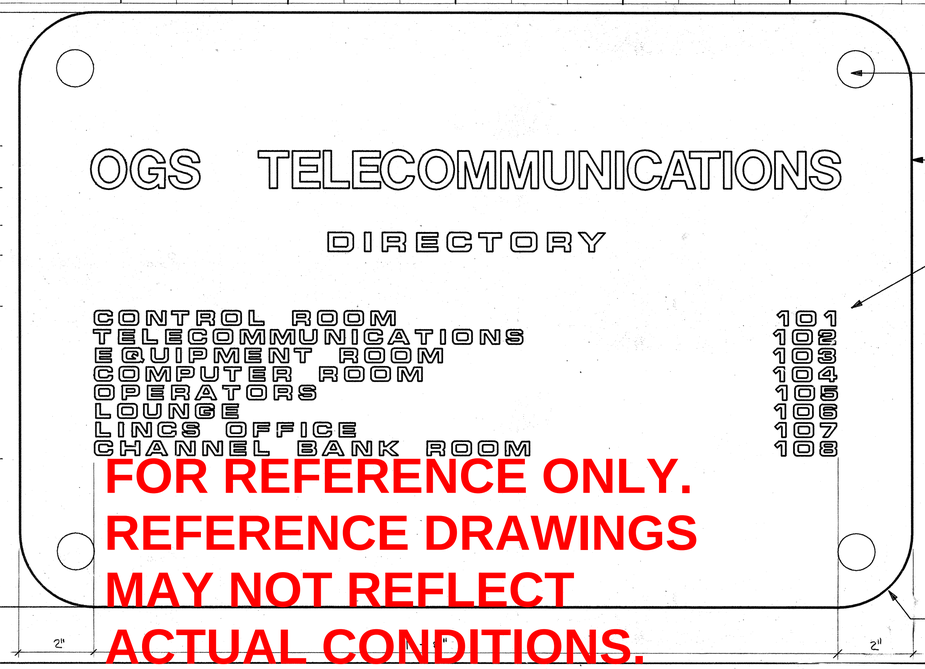


NOTE: 21
16"X24" TYPICAL SIGN WITH 1" HELVETICA, WHITE VINYL LETTERS - "OGS TELECOMMUNICATIONS"

DIRECTORY ELEVATION 1
SCALE: 6" = 1'-0"

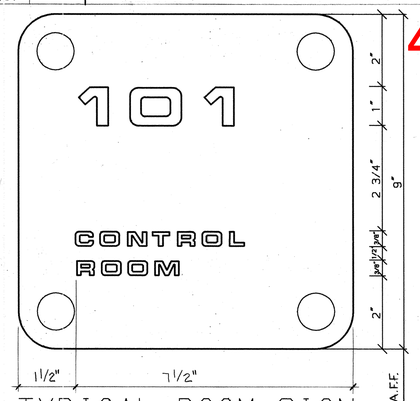

TYPICAL ROOM SIGN
SCALE: 6" = 1'-0"
ALL SIGNS 9"X9" EXCEPT 1 AND 21

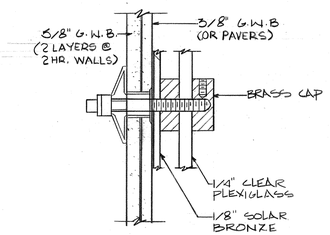

WALL-MOUNT DETAIL
NO SCALE

FOR REFERENCE ONLY. REFERENCE DRAWINGS MAY NOT REFLECT ACTUAL CONDITIONS.

CONSTRUCTION

PROVIDE TELECOMMUNICATIONS EQUIPMENT ROOMS

VARIOUS BUILDINGS G.N.A.R.E.S.P. AND ENVIRONS ALBANY, NEW YORK

CONCOURSE TELECOMMUNICATIONS CENTER

FINISH SCHEDULE

STATE OF NEW YORK EXECUTIVE DEPARTMENT
OFFICE OF GENERAL SERVICES

COMMISSIONER JOHN C. EGAN	DESIGN AND CONSTRUCTION DIRECTOR HARRY STEVENS, JR., P.E.
	DIVISION OF DESIGN DIRECTOR WILLIAM F. O'CONNOR, R.A.
ARCHITECTURAL BUREAU CHIEF RICHARD E. THOMAS, R.A.	ENGINEERING BUREAU CHIEF VINCENT P. POLETO, P.E.

DESIGNED BY	DATE	SCALE	APPROVED
D. SCOTT	1/7/87	AS SHOWN	
DRAWN BY	CHECKED BY	STRUCTURAL CHECK	FIELD CHECK
A. SPANG			

APPROVED BY OFFICE OF GENERAL SERVICES
DATED SEPTEMBER 10, 1986 LETTER NO. 006883


PROJECT NO. 35583-C
DRAWING NO. A 17
PLAN FILE NO. 86/12-244

44782 ADDENDUM REFERENCE DRAWING SET 1

LEGEND

CEILING MOUNTED LIGHT FIXTURES SHOWN ON THIS PLAN, ARE FOR LOCATION ONLY! FOR CIRCUITING REFER TO ELECTRIC DRAWINGS.

- ACOUSTICAL TREATMENT
- PARTITION
- EXISTING WALL TO REMAIN
- 2' x 2' GRID SUSPENDED ACOUSTICAL CEILING GRID.
- PAINTED GYPSUM BOARD CEILING.
- HVAC DIFFUSER
- CEILING MOUNTED EXIT SIGN

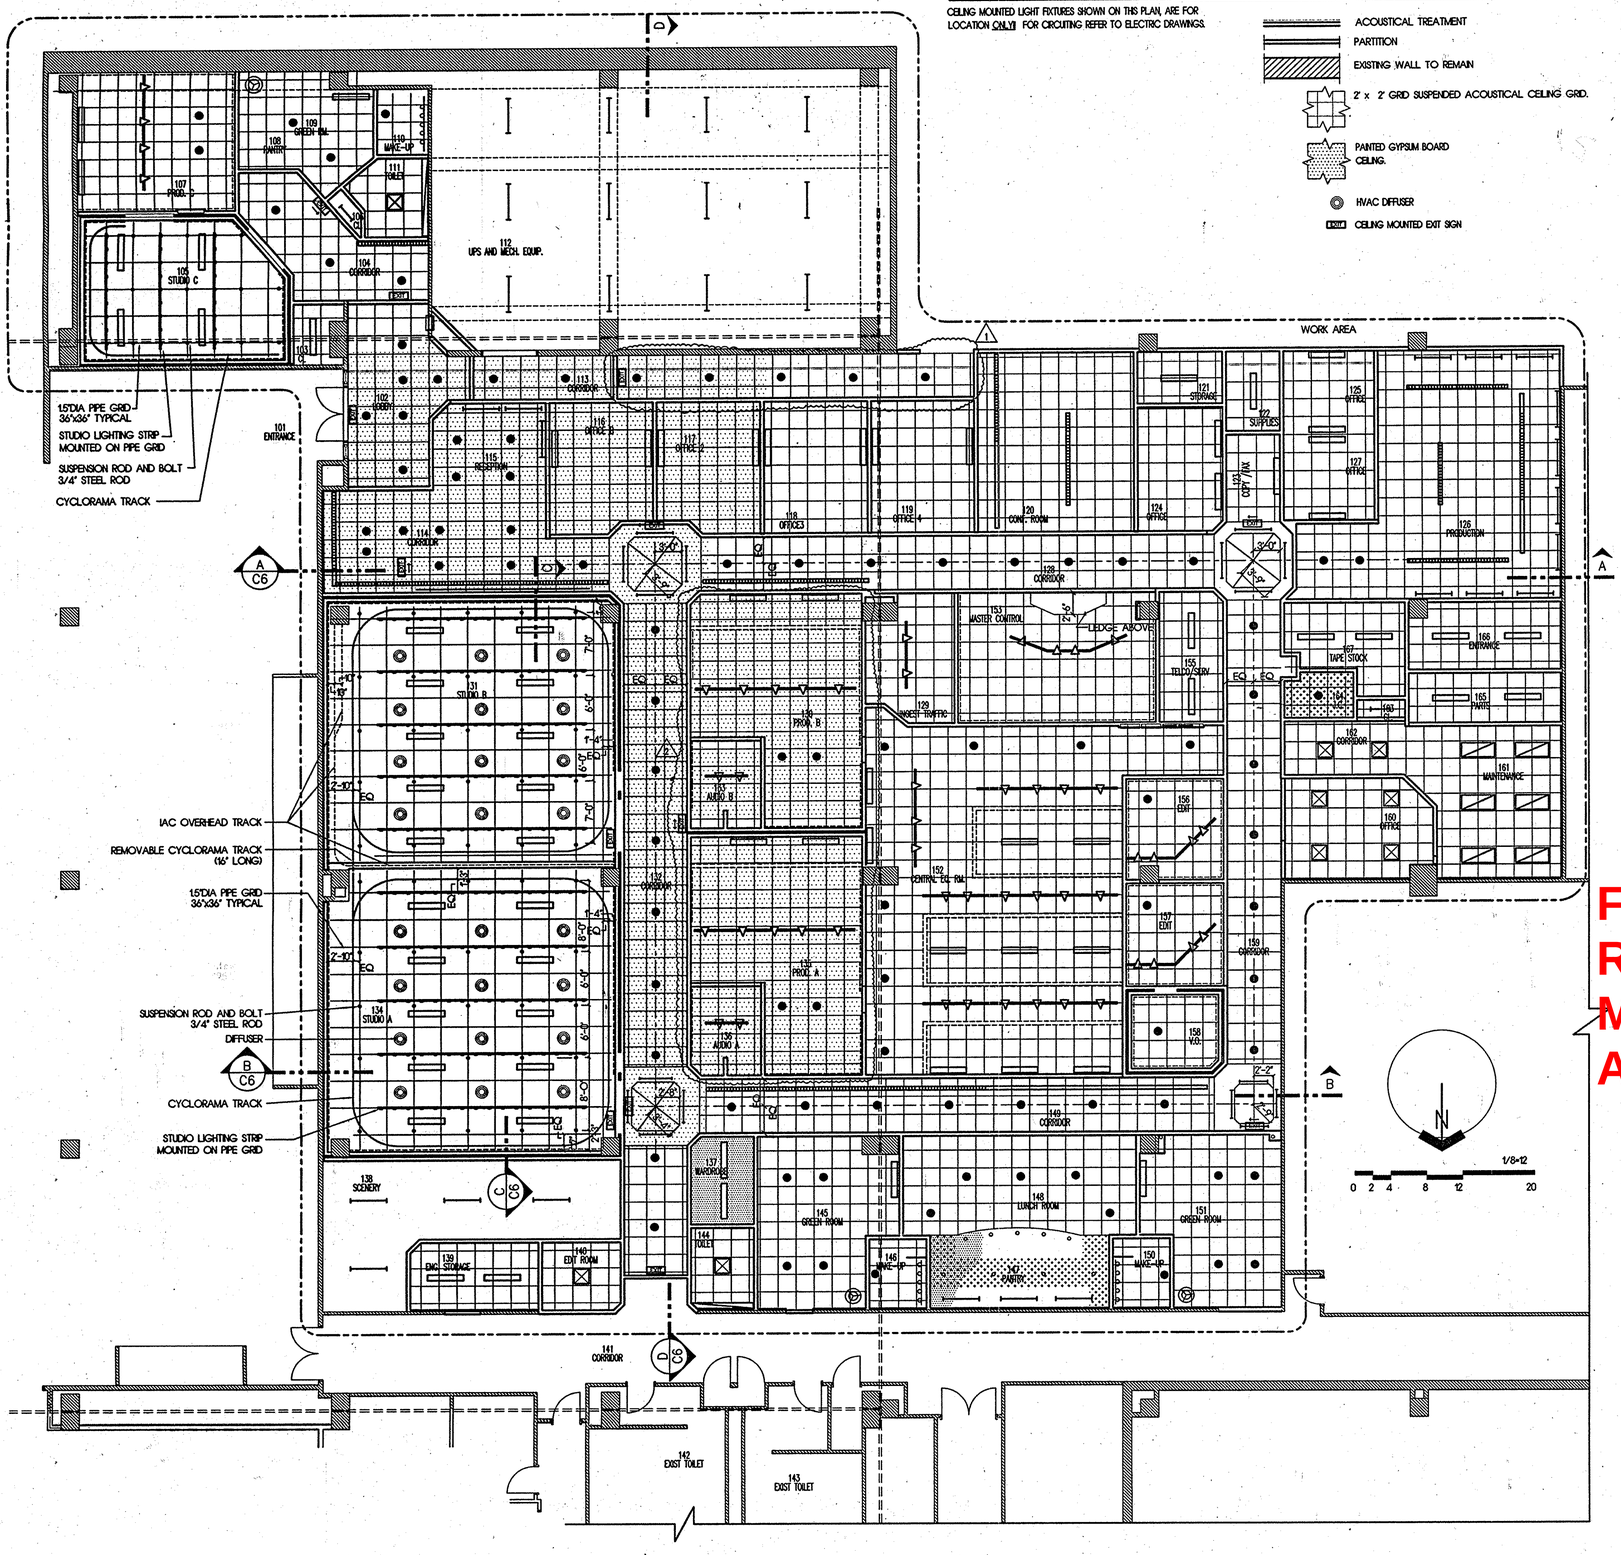

FOR REFERENCE ONLY.
REFERENCE DRAWINGS MAY NOT REFLECT ACTUAL CONDITIONS

RTKL

RTKL New York Architecture & Engineering P.C.
One South Street
Baltimore, MD 21202
410 528-8600

©2001 RTKL Associates Inc.

HKA

HANS KNUTZEN ASSOCIATES, INC.
11 Prall Place Nyack, New York
845-358-7667 Fax 845-358-7691

1	NEW CEILING HIGHT	12/06/01
2	NEW ROOM LAYOUT	12/18/01

FINAL SUBMISSION

NYS OFFICE OF GENERAL SERVICES
Serving New York

GEORGE E. PATAKI
Governor
KENNETH J. RINGLER, JR.
Commissioner
WILLIAM F. O'CONNOR, A.I.A.
Deputy Commissioner for Design and Construction


WARNING:
THE ALTERATION OF THIS MATERIAL IN ANY WAY, UNLESS DONE UNDER THE DIRECTION OF A COMPARABLE PROFESSIONAL, I.E. ARCHITECT FOR AN ARCHITECT, ENGINEER FOR AN ENGINEER OR LANDSCAPE ARCHITECT FOR A LANDSCAPE ARCHITECT, IS A VIOLATION OF THE NEW YORK STATE EDUCATION LAW AND/OR REGULATIONS AND IS A CLASS 'A' MISDEMEANOR.

CLIENT: OFFICE OF GENERAL SERVICES
CONTRACT: CONSTRUCTION
TITLE: SUNY – NY NETWORK RELOCATION
LOCATION: EMPIRE STATE PLAZA ALBANY, NY
SHEET TITLE: REFLECTED CEILING PLAN

DESIGNED BY:	DATE:	
HEK	11-MAY-2001	1/8"=1'-0"
DRAWN BY: JAS	FIELD CHECK:	APPROVED:

PROJECT NUMBER: 41223-C
DRAWING NUMBER: C-04
SHEET OF


PLAN FILE 01/586

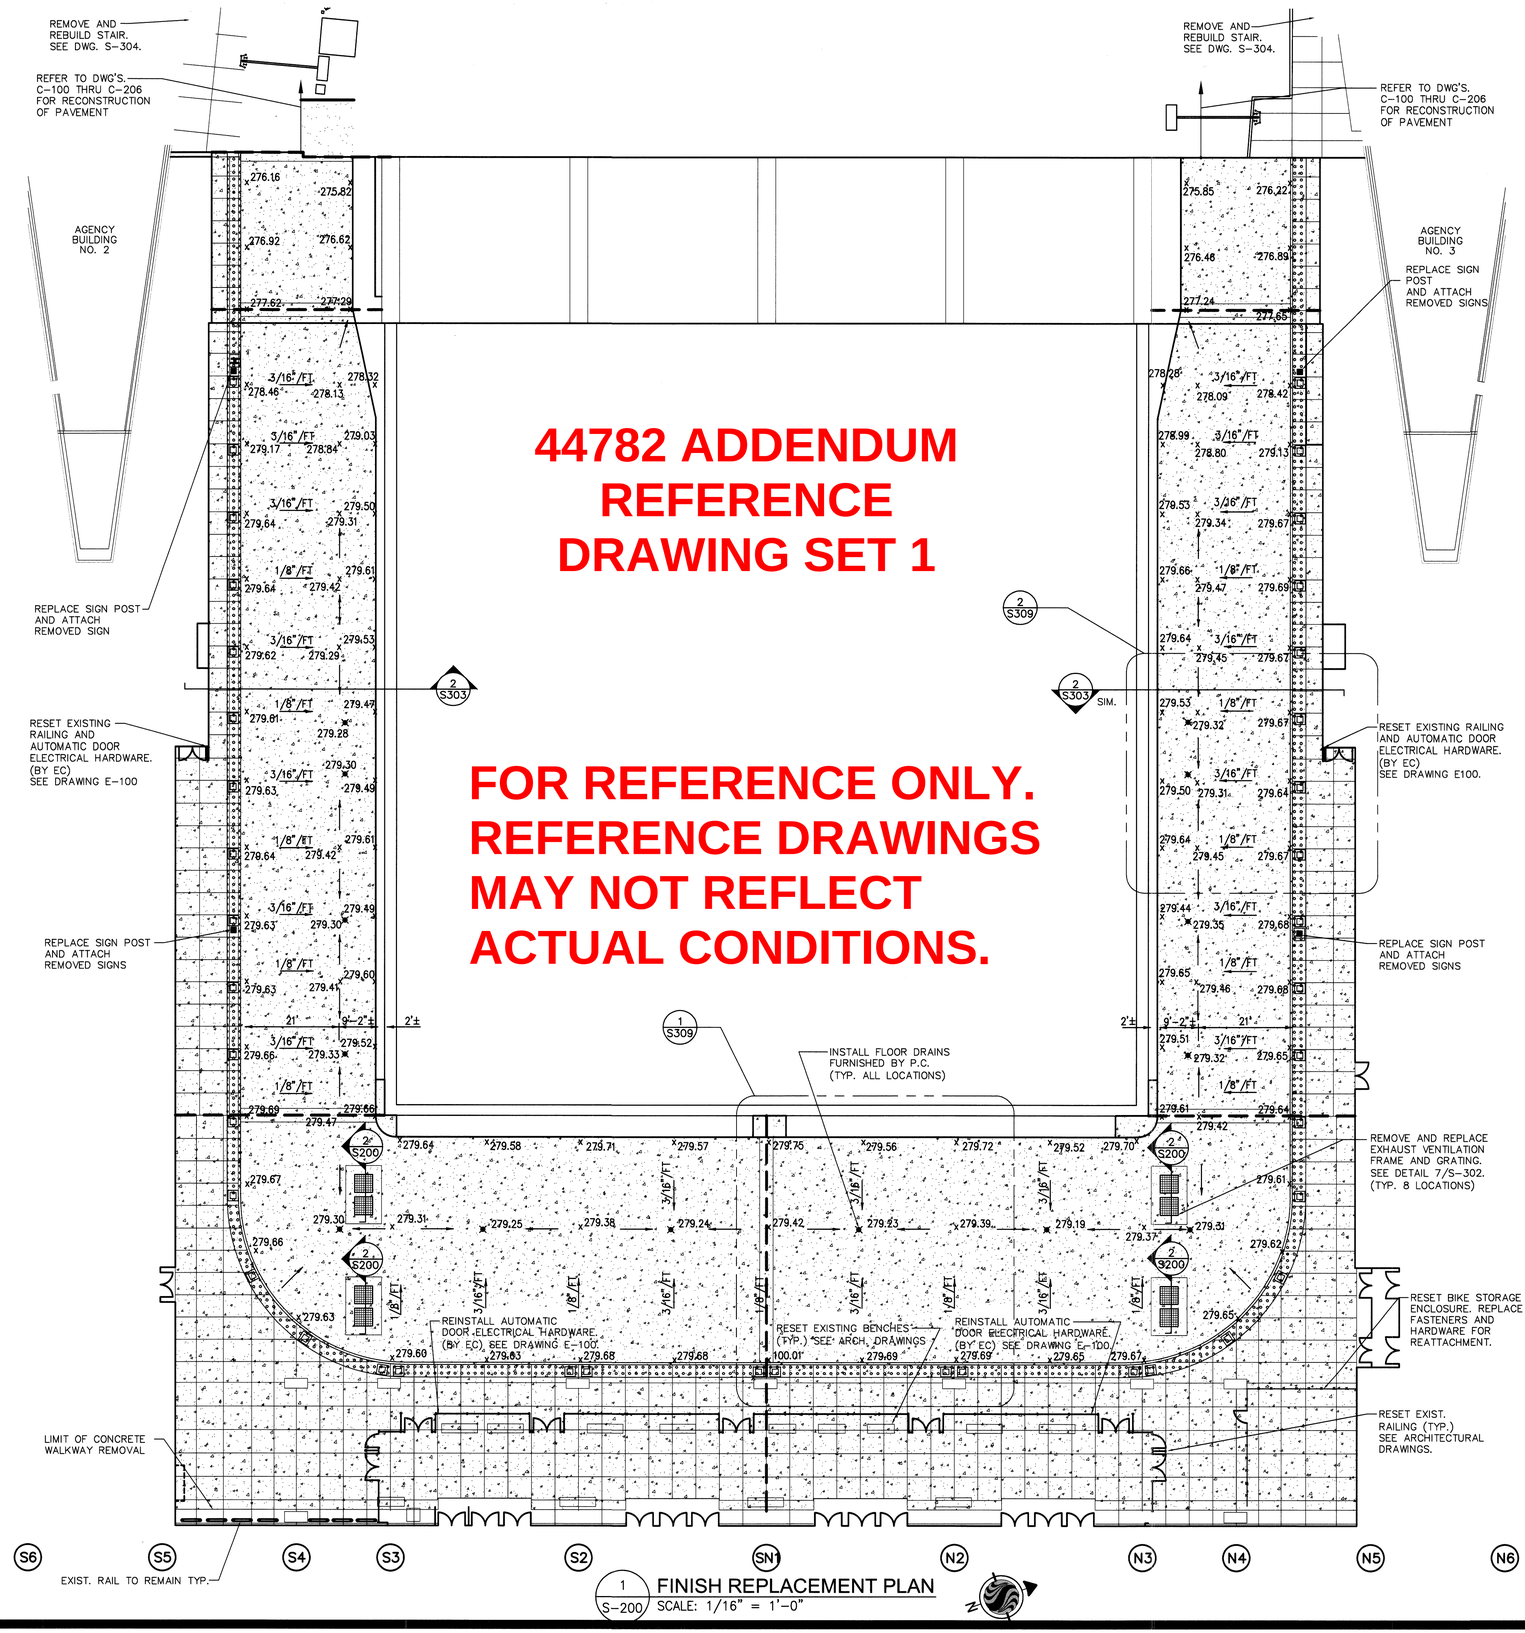

44782 ADDENDUM REFERENCE DRAWING SET 1

FOR REFERENCE ONLY. REFERENCE DRAWINGS MAY NOT REFLECT ACTUAL CONDITIONS.

1 S-200 **FINISH REPLACEMENT PLAN**
SCALE: 1/16" = 1'-0"

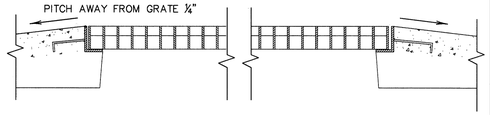


2 S-200 **SECTION - DRAINAGE AT GRATE**
SCALE: N.T.S

NOTES

1. REFER TO DWG. S-002 THRU S-004 FOR CONSTRUCTION FACILITIES AND PHASING REQUIREMENTS. WORK SHALL FOLLOW PHASING PLAN.
2. REVIEW ALL POTENTIAL REPAIRS WITH DIRECTOR'S REPRESENTATIVE FOR AUTHORIZATION PRIOR TO STAGING. DIRECTOR'S REPRESENTATIVE MUST APPROVE ALL REPAIR TYPE AND SCOPE OF WORK CHANGES PRIOR TO CONTINUING WORK.
3. REFER TO SPECIFICATION SECTION 015000 – CONSTRUCTION FACILITIES & TEMPORARY CONTROLS FOR DUST CONTROL.
4. COORDINATE OPERATIONS WITH THE DIRECTOR'S REPRESENTATIVE.
5. REFER TO DWG. C-400 THRU C-403 FOR MAINTENANCE AND PROTECTION OF TRAFFIC DRAWINGS FOR RIGHT LANE ARTERIAL CLOSURE AND LEFT LANE ARTERIAL CLOSURE.
6. PROVIDE UTILITY MARK-OUT FOR EXACT LOCATIONS SEE SPECIFICATIONS.
7. USE OF EXISTING HOSE RACKS SHALL NOT BE PERMITTED DURING THE WINTER MONTHS.
8. REFER TO S-000 FOR CANOPY NOTES AND DESIGN CRITERIA.
9. REFER TO S-203 FOR BONDED CONCRETE TOPPING CONTROL JOINT LOCATIONS IN ROADWAY

LEGEND

- FLOOR DRAIN (REPLACE) SEE DETAIL 1/S-304.
- EXPANSION JOINT (REPLACE GLAND AND ASSEMBLY) SEE DWG. NO. S-500.
- REPLACE WITH BONDED CONCRETE TOPPING SEE DRAWING S-203 AND S-309.
- REPLACE CONCRETE SIDEWALK AND PROVIDE WATER REPELLENT COATING. SEE DRAWING S-303.
- REPLACE ADA DETECTABLE WARNING SURFACE SEE DRAWING S-302.
- RESET CONCRETE BOLLARDS SEE DRAWING S-304.
- RESET SIGN POST
- 274.30 x FLOOR ELEVATION – ELEV. BASED ON MJ ENGINEERS SURVEY DATED SEPTEMBER 2008 SEE DWG. C-102 FOR BENCHMARK LOCATION AND ELEVATION.
- CONCRETE SHOULDER AT EJ.

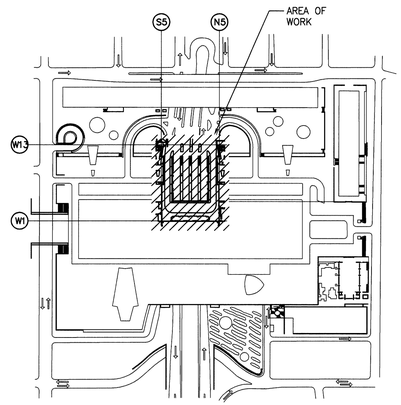

KEY PLAN
P3 AND CONCOURSE LEVELS

NYS OFFICE OF GENERAL SERVICES
Serving New York
ANDREW M. CUOMO
Governor
ROANN M. DESTITO
Commissioner

CONSULTANT

Stantec
Stantec Consulting
61 Commercial Street Suite 100
Rochester NY U.S.A.
14614-1009

WARNING:
THE ALTERATION OF THIS MATERIAL IN ANY WAY, UNLESS DONE UNDER THE DIRECTION OF A COMPARABLE PROFESSIONAL, I.E. ARCHITECT FOR AN ARCHITECT, ENGINEER FOR AN ENGINEER OR LANDSCAPE ARCHITECT FOR A LANDSCAPE ARCHITECT, IS A VIOLATION OF THE NEW YORK STATE EDUCATION LAW AND/OR REGULATIONS AND IS A CLASS 'A' MISDEMEANOR.

STATE OF NEW YORK · GARY D. GARWIG · 084421 · LICENSED PROFESSIONAL ENGINEER

CONTRACT: CONSTRUCTION

TITLE: REHABILITATE BUS LOOP AND CONCRETE ROADWAYS

LOCATION: EMPIRE STATE PLAZA ALBANY, N.Y. 12242

CLIENT: NYS OFFICE OF GENERAL SERVICES

–	6/17/2015	FOR BID
MARK	DATE	DESCRIPTION

PROJECT NUMBER:	44839 – C
DESIGNED BY:	GARY GARWIG
DRAWN BY:	PAUL CURTS
FIELD CHECK:	
APPROVED:	

SHEET TITLE: BUS LOOP PLAN FINISH REPLACEMENT

DRAWING NUMBER: S-200

SHEET 39 OF 95

Jul 01,2015 – 9:44am
u:\191060221\structural\design\drawing\RE BID 6 17 2015\OGS Bus Loop (6-17-15)\S-200.dwg
36x24 PLOT SHEET